

Latitude



Longitude

Topo Location

7.5' Loc. _____ 15' Loc. _____
 _____ (calc.) _____

Company _____

Farm _____


15' Quad _____
(sec.)

7.5' Quad Shannonston

District Lincoln

WELL LOCATION PLAT

County 049 Permit 30920

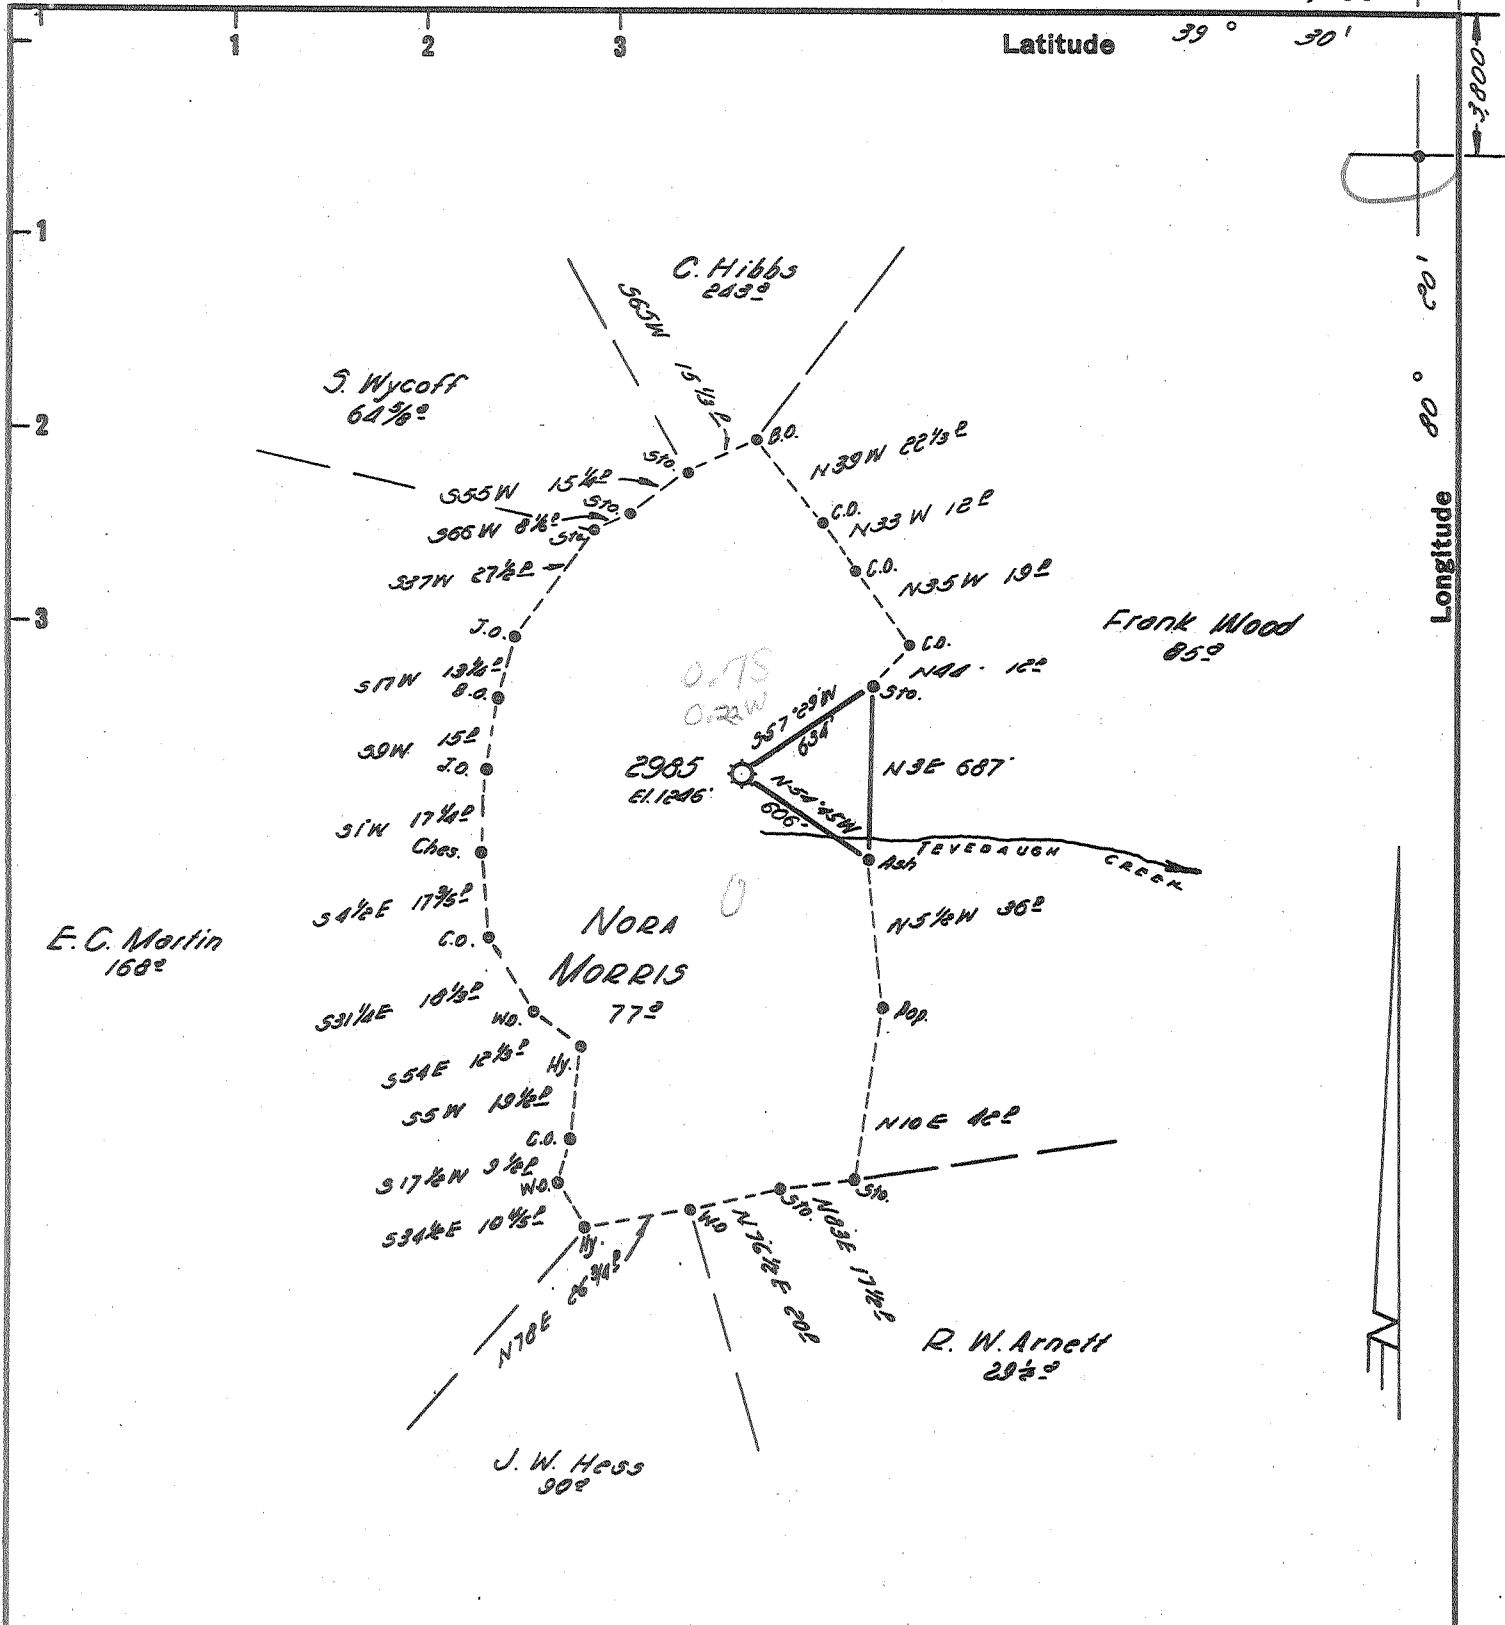

MOD Sect 90 N3 E16 FB 113 P59

Minimum Error of Closure 1" 10,000'
 Source of Elevation Elev. from U.S.G.S. B.M. 144 N-2-M. -1257.
Elev. 1000'

New Location I, the undersigned, hereby certify that this map is correct to the best of my know-
 Drill Deeper ledge and belief and show all the information required by paragraph 6 of the rules
 Abandonment and regulations of the oil and gas section of the mining laws of West Virginia.

Company HOPE NATURAL GAS CO.
 Address CLARKSBURG W.VA.
 Farm NORA MORRIS
 Tract _____ Acres 77 Lease No. 20721
 Well (Farm) No. _____ Serial No. 2985
 Elevation (Spirit Level) 1246'
 Quadrangle CLARKSBURG NC.
 County MARION District LINCOLN
 Engineer Jackson M. Jarvis
 Engineer's Registration No. 2397
 File No. _____ Drawing No. _____
 Date 11-9-64 Scale 1"=40 FEET

STATE OF WEST VIRGINIA
 DEPARTMENT OF MINES
 OIL AND GAS DIVISION
 CHARLESTON

WELL LOCATION MAP
 FILE NO. MAR-920-A

+ Denotes location of well on United States Topographic Maps, scale 1 to 62,500, latitude and longitude lines being represented by border lines as shown.

- Denotes one inch spaces on border line of original tracing.