

39°32'30"

Latitude

80°17'30"

.87s
.63w

Longitude

Topo Location

7.5' Loc. _____ 15' Loc. _____
 _____ (calc.) _____

Company _____

Farm _____


15' Quad _____
(sec.)

7.5' Quad Mannington

District London

WELL LOCATION PLAT

County 049 Permit 30965

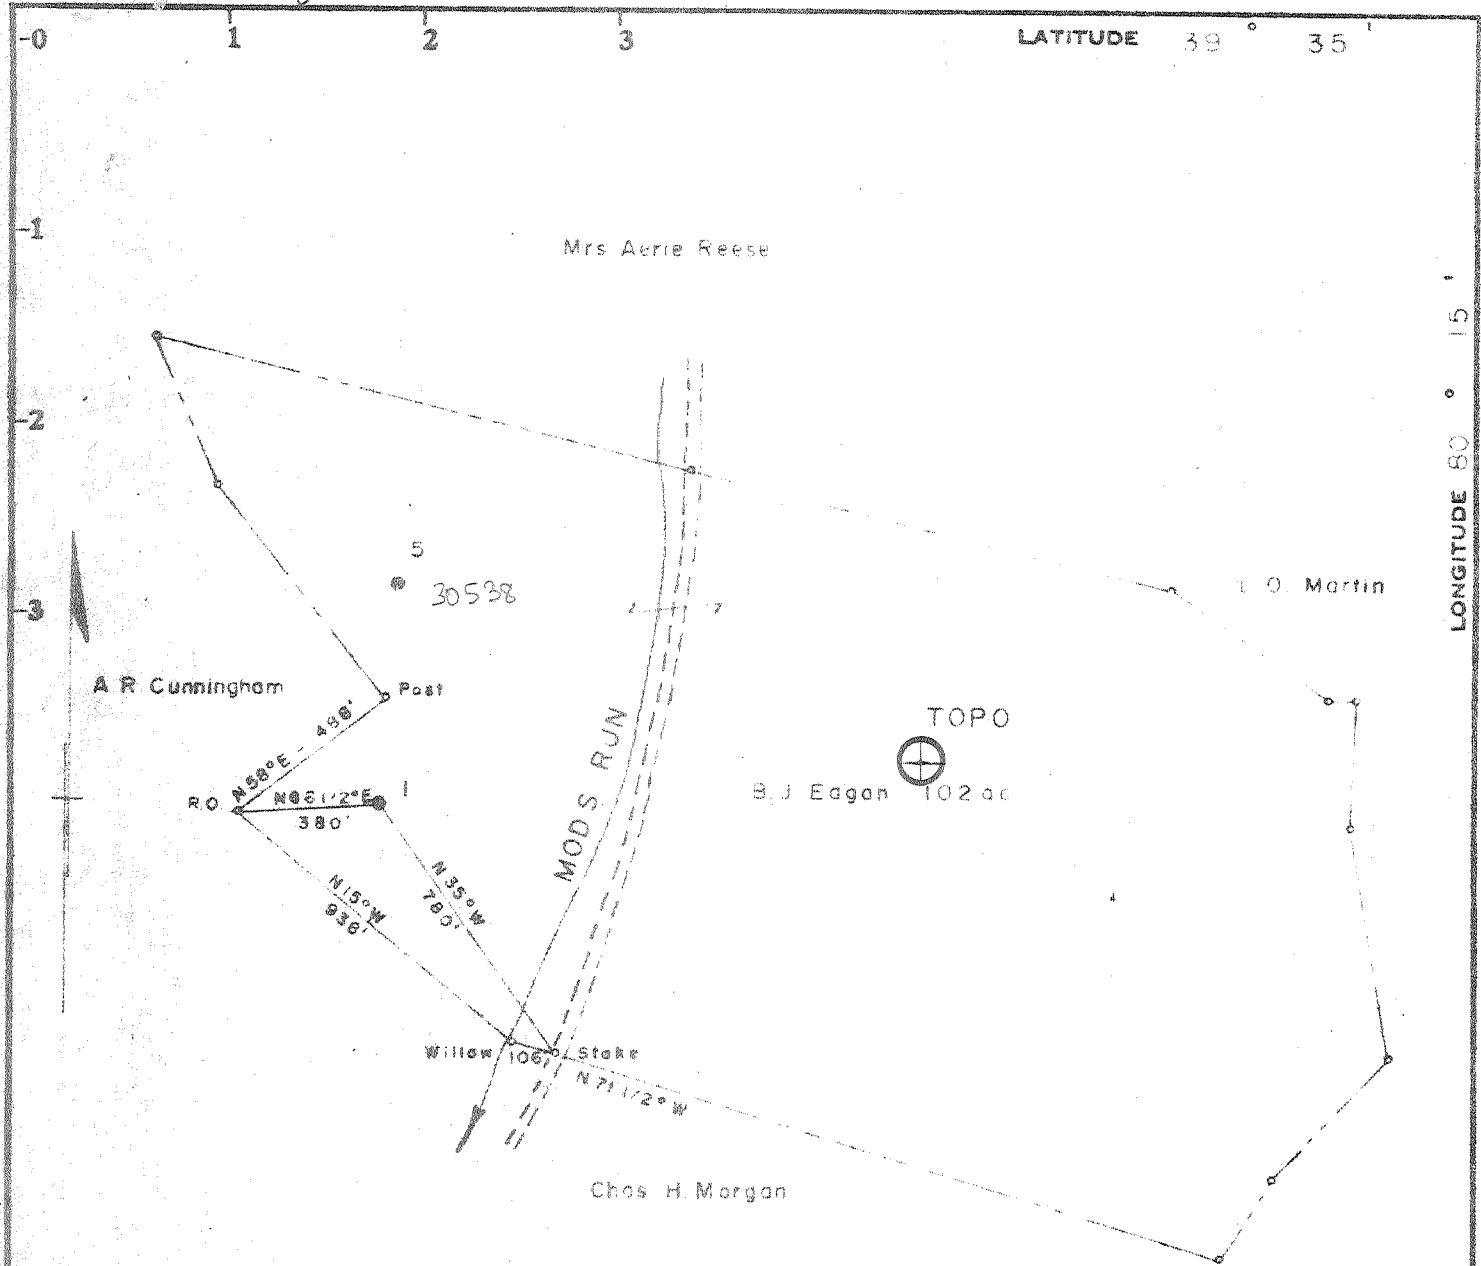

SURFACE.
Eastern Asc.
Coal Co.
Rachel, W.Va. 26587

Minimum Error of Closure 1 in 200
Sources of Elevation Pennzoil company records

3.84S
2.84W

- Fracture
- New Location
- Drill Deeper
- Abandonment *9/17/74*

I, the undersigned, hereby certify that this map is correct to the best of my knowledge and belief and shows all the information required by paragraph 6 of the rules and regulations of the oil and gas section of the mining laws of West Virginia.

Signed: *Curtis A. Lucas*
Squares: N 5-6 S E 18 W

Company PENNZOIL COMPANY
 Address P.O. Box 1588, Parkersburg, W. Va. 26101
 Farm B. J. Eagan
 Tract Acres 102 Lease No. 6248
 Well (Farm) No. 1 Serial No.
 Elevation (Spirit Level) 1156.85
 Quadrangle Mannington SE
 County Marion District Lincoln
 Surveyor CURTIS A. LUCAS
 Surveyor's Registration No. 275
 File No. 985 Drawing No.
 Date Sept. 9, 1974 Scale 1" = 500'

STATE OF WEST VIRGINIA
DEPARTMENT OF MINES
OIL AND GAS DIVISION
CHARLESTON

WELL LOCATION MAP

FILE NO. 77M-965-A

+ Denotes location of well on United States Topographic Maps, scale 1 to 62,500, latitude and longitude lines being represented by border lines as shown.

- Denotes one inch spaces on border line of original tracing. 47-049