


LATITUDE 39 35

LONGITUDE 80 22 30

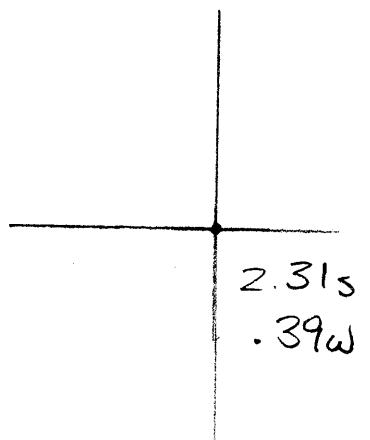

7'5 OGIS topo location

7.5' loc _____ 15' loc _____
 (calc.) _____

Company _____

Farm FLATHA 1

Quad GLOVER GAP

County MARION

District MANNINGTON

WELL LOCATION MAP

File No. 70012

70012

Mannington District, Marion County, W. Va.
By Hartman Oil Co.

3

	Top.	Bottom.
Pittsburgh Coal		865
Big Injun Sand	2234 -	2322
Total depth		2325