


LATITUDE

39 35

LONGITUDE 80 17 30

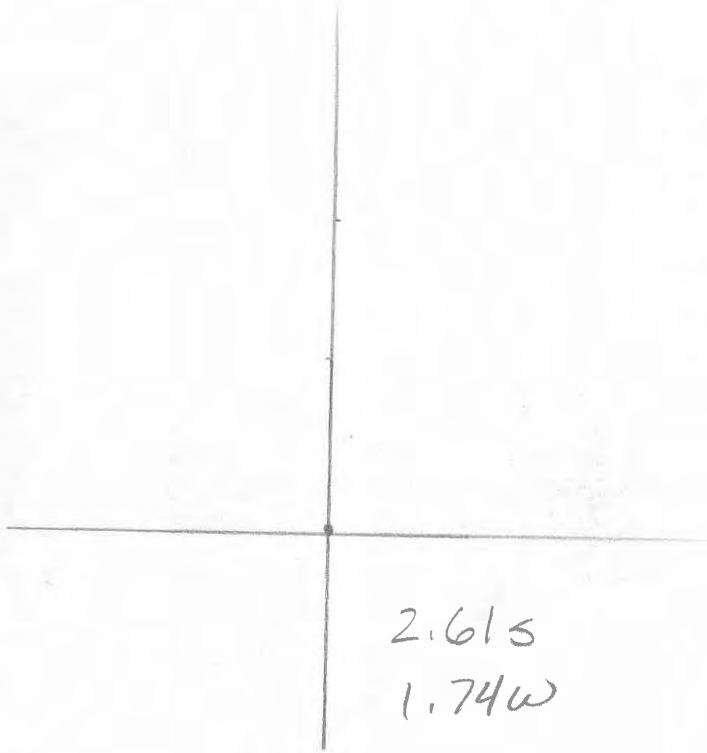

2.615
1.74W

7'5 OGIS topo location

7.5' loc _____

15' loc _____
(calc.) _____

Company _____

Farm E A BLACKSHERE 6

Quad MANNINGTON

County MARRION

District MANNINGTON

WELL LOCATION MAP

File No. 70032

MAR-

L. A. Richards No. 6 Well.

Hannington District, Marion County, W. Va.

By South Penn Natural Gas Co.

On 670 acres.

Elevation Derrick floor, 1141.73'; Ground, 1139.23'.

Drilling commenced July 10, 1903; completed August 13, 1903.

3

	Top.	Bottom.
Pittsburgh Coal	593	...
Gas Sand	1330	1420
Salt Sand	1525	1595
Big line	1800	1864
Big Injan Sand (oil, 2025')	1916
Total depth		2046

Initial production = 5 bbls. per day.

Well abandoned November 5, 1910.