


LATITUDE 39 32 30

LONGITUDE 80 20

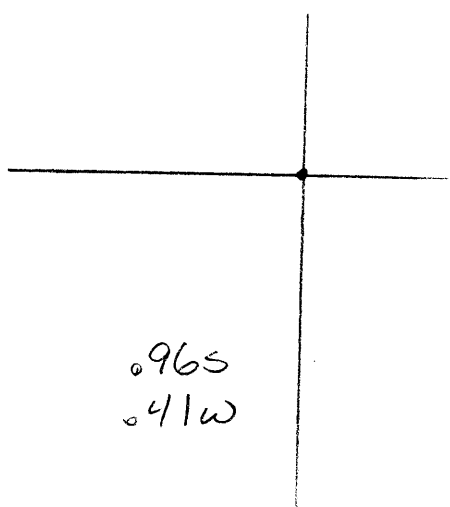

7'5 OGIS topo location

7.5' loc _____ 15' loc _____
 (calc.) _____

Company _____

Farm BURT 14

Quad MANNINGTON

County MARION

District MANNINGTON

WELL LOCATION MAP

File No. 70042

BURT NO. 14 WELL.

70042
Pt. No. 12 C.F. - Marion.
No. 508 M-M-T Rept., p. 551.

Mannington District, Marion County, W. Va.
By Burt Oil Co.
1/2 mile below Mannington.
7-5/8" casing, 1030'; 5-5/8", 1782'.
Elevation 1057' L.

508 MMT
Co Rep
#261 on Map

	Top.	Bottom.
Pittsburgh Coal	510	
Big Injun Sand (1st pay, 1914'; 2nd pay, 1924')	1838	
Depth		1939½
Gordon Sand (pay, 2728')	2723 - 2742	
Dark slate, soft	2742 - 2762	
4th Sand	2762 - 2788	
Dark slate, to bottom	2788 - 3000	