


LATITUDE 39 30

LONGITUDE 89 20

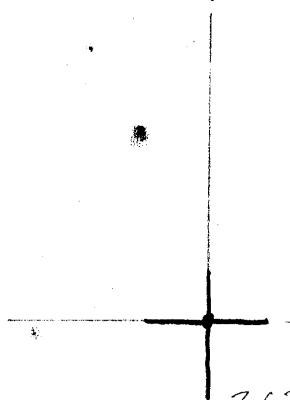

2.62S
.27W

7'5 OGIS topo location

7.5' loc	<u>2.62S</u>	15' loc	_____
	<u>.27W</u>	(calc.)	_____

Company _____ 1889

Farm J N CUNNINGHAM

Quad SHINNSTON

County MARION

District LINCOLN

WELL LOCATION MAP

File No. 70050

MAR

70050
632 MMT Co Rep

PITTSBURGH AND WEST VIRGINIA GAS COMPANY

absent

Well No. 1889

Lessor - J. N. Cunningham

Lincoln Dist., Marion County

Clks. NE 1

Completed 6/29/06

Elevation - ?

Abandoned 10/12/17

<u>Formations</u>	<u>Top</u>	<u>Bottom</u>	<u>Remarks</u>
Gravel	0	26	
Lime	26	70	
Coal-Mapletown	70	75	
Lime	75	179	
Pittsburgh Coal	179	189	
Red Rock	189	350	
Sand - L. Dunkard?	350	605	
Sand	605	620	
Slate	620	636	
Sand-B. Dunkard	636	736	
Lime	736	776	
Gas Sand	776	940	
Lime	940	955	
Sand- Salt	955	1260	
Lime	1260	1285	
Red Rock	1285	1356	
Lime	1356	1438	
Red Rock	1438	1442	
Lime - Little Lime	1442	1464	
Pencil Cave	1464	1479	
Lime - Big Lime	1479	1545	
Sand - Big Injun	1545	1630	Gas at 1630
Slate	1630	1634	
Sand	1634	1674	Gas at 1640
Slate	1674	1774	
Slate & Shells	1774	2015	
Shells	2015	2070	
Sand - 50'	2070	2180	
Slate	2180	2200	
Red Rock	2200	2216	
30' Sand	2216	2240	
Red Rock	2240	2280	
Sand	2280	2285	
Slate & Shells	2285	2351	
Slate	2351	2399	
Sand- Gordon	2399	2419	Gas at 2410
Red Rock	2419	2425	
Sand - 4th	2425	2449	
Slate	2449	2550	
Sand - 5th	2550	2554	Gas at 2553
Slate	2554	2679	
Lime	2679	2727	
TOTAL DEPTH		<u>2727</u>	

632 MMT
Co Rep

(C)

No volume or pressure data on hand for original tests.