


LATITUDE 39 32 30

LONGITUDE 80 25

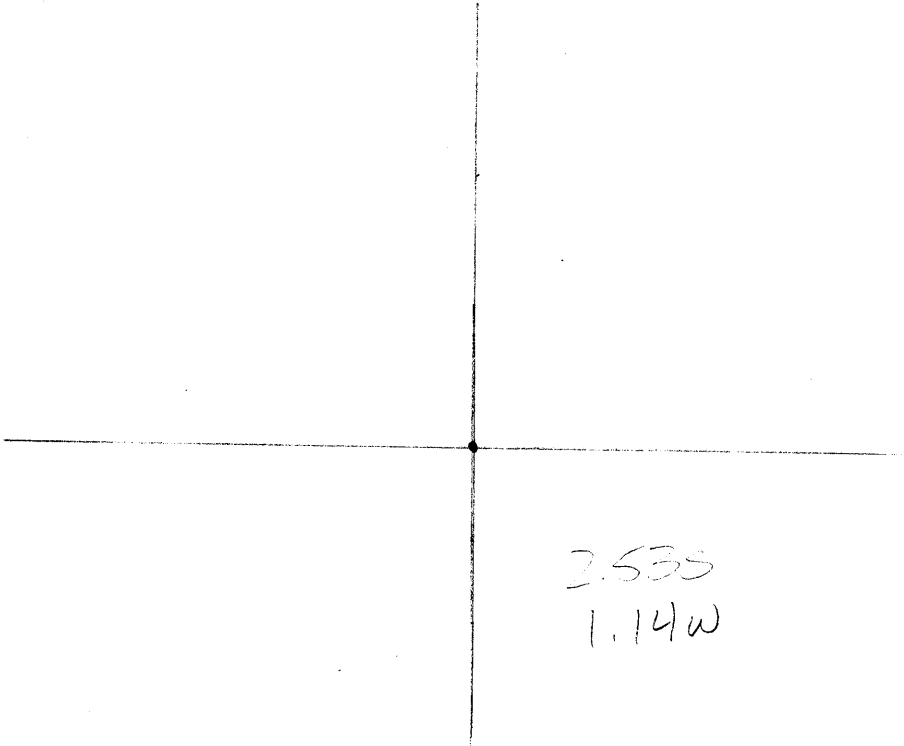

2.53S
1.14W

7'5 OGIS topo location

7.5' loc	<u>2.53S</u>	15' loc	_____
	<u>1.14W</u>	(calc.)	_____

Company Alexander Huey 1

Farm ALEXANDER HUEY 1

Quad GLOVER GAP

County MARION

District MANNINGTON

WELL LOCATION MAP

File No. 70113

ALEXANDER HUBY NO. 1 WELL.

70113
 No. 469 M-M-T Rpt.
 pp. 534 & 566.

Mannington District, Marion County, W. Va.
 By Delmar Oil Co.
 1.3 mi. S. of Curtisville.
 Well abandoned as non-paying.

469 M-M-T Rpt.



	Thickness.	Total.
Unrecorded	161	- 161
Coal, native	5	- 166
Unrecorded	276	- 442
Coal, (Waynesburg)	11	- 453
Unrecorded	269	- 722
Coal, Mapletown (Sawickley)	8	- 730
Unrecorded	85	- 815
Pittsburgh Coal (very broken)	6	- 821
Unrecorded	1212	- 2033
Marion Sand (oil, 2041')	10	- 2043
Unrecorded	139	- 2182
Big Injun Sand	112	- 2294
Unrecorded	511	- 2805
Fifty-foot Sand (gas, 2830')	50	- 2855
Unrecorded	5	- 2860
Thirty-foot Sand (oil show, 2870')	36	- 2896
Unrecorded	19	- 2915
Garden Stray Sand	27	- 2942
Unrecorded	30	- 2972
Garden Sand (badly broken)	36	- 3008
Slaty shale	309	- 3317
Total depth		3317