


39 32 30

LATITUDE 39 32 30

LONGITUDE 80 20

80 20

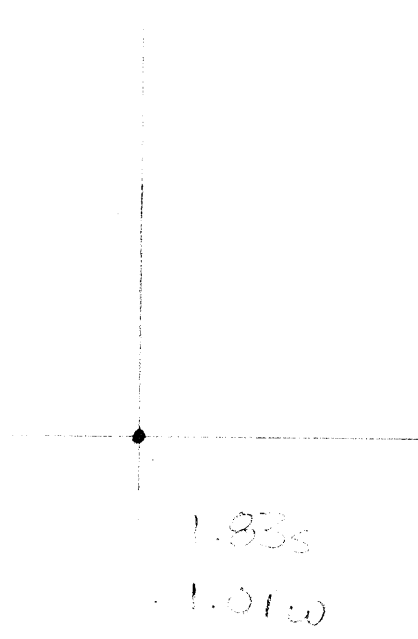

7'5 OGIS topo location

7.5' loc	<u>1.83S</u>	15' loc	_____
	<u>1.01W</u>	(calc.)	_____

Company \_\_\_\_\_

Farm GR MORGAN 1

Quad MANNINGTON

County MANNINGTON


District MANNINGTON

WELL LOCATION MAP

File No. 70146

Mannington District, Marion County, W. Va.  
By South Penn Oil Co.  
1.3 mi. S. 5° W. of Mannington.  
Completed, August 9, 1894.  
Elevation, 1060' B.  
10" casing, 115'; 8 $\frac{1}{4}$ ", 500'; 6 $\frac{1}{4}$ ", 1083'; 5", 1819'.

70146  
542 M-W-T Rept



	Top.	Bottom.
Pittsburgh Coal	475	
Dunbar Sand	892	934
Salt Sand	1545	1842
Big Injun Sand (oil and gas, light, 1912-1920'), to bottom	1842	1943