


39 37 30

LATITUDE 39 37 30

LONGITUDE 80 22 30

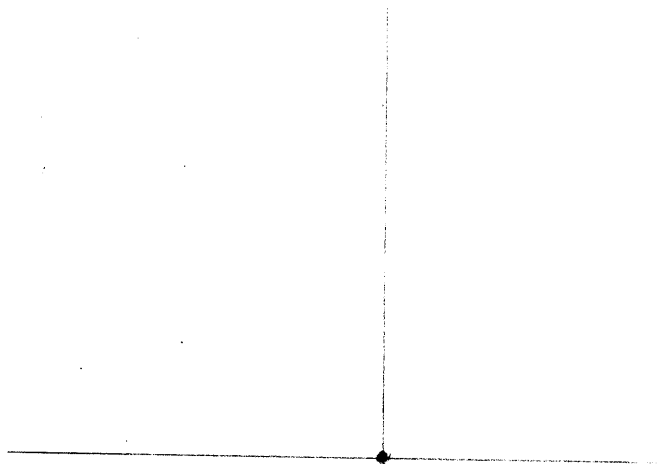

1.77S  
.94W

80 22 30

7'5 OGIS topo location

7.5' loc	<u>1.77S</u>	15' loc	_____
	<u>.94W</u>	(calc.)	_____

Company \_\_\_\_\_

Farm MW STURM 2

Glover Gap

Quad GLOVER GAP

County WYOMING

District MANNINGTON

WELL LOCATION MAP

File No. 710173

395 M.M.T. 2 Top

Mannington District, Marion County, W. Va.  
By South Penn Oil Co.  
1 mi. S. E. of Glover Gap.  
10" casing, 440'.

	Top.	Bottom.	Thickness.
Conductor	0	- 16	16
Mapietown (Sewickley) Coal	982	- 986	4
Pittsburgh Coal	1050	- 1055	5
Dunkard Sand	1600	- 1650	50
Salt Sand	1928	- 1978	50
Big Lime	2310	- 2372	62
Break	2372	- 2373	1
Big Injun Sand	2373	- 2533	160
Squaw Sand	2533	- 2565	32
Fifty-foot Sand	3050	- 3092	42
Thirty-foot Sand	3117	- 3150	33
Gordon Sand	3250	- 3284	34
Slate	3284	- 3285	1
Sand, gray	3285	- 3295	10
Slate	3295	- 3300	5
Shells	3300	- 3308	8
Sand, gray	3308	- 3320	12
Slate, to bottom	3320	- 3347	27