


LATITUDE 39 30

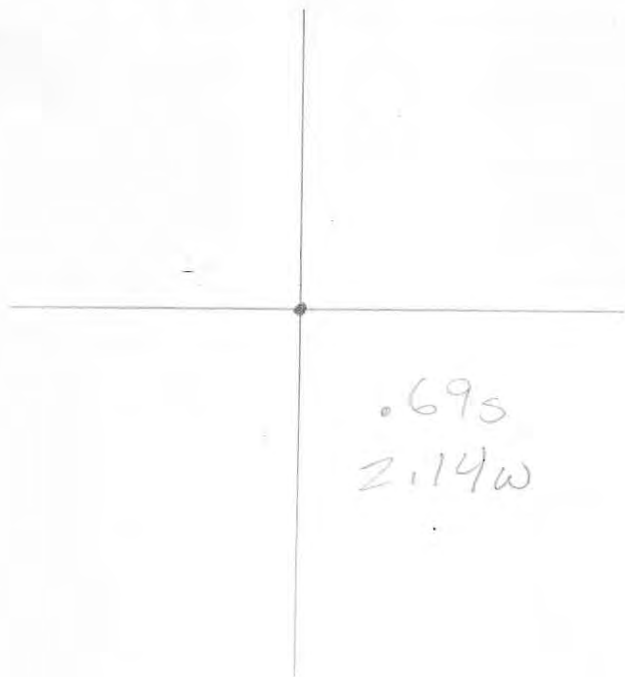

LONGITUDE 80 20

7'5 OGIS topo location

7.5' loc .69S 15' loc \_\_\_\_\_  
                   2.14W (calc.) \_\_\_\_\_

Company \_\_\_\_\_

Farm S M TETRICK 2

Quad SHINNSTON

County MARION

District MANNINGTON

WELL LOCATION MAP

File No. 70179

S. M. TETRICK NO. 2 WELL.

70179  
No. 64 O.F.-Marion.  
No. 523 M-M-T Rept.,  
tabulated only.

523 MMT Co Rep

Mannington District, Marion County, W. Va.  
By Hartman Oil Co.  
2.5 mi. N. E. of Pleasantville.

?

	Top.	Bottom.
Pittsburgh Coal		878
Gas Sand (water)		1670
Big Injun Sand (slate break, 2317-21')	2244	- 2336

M-523

S. M. Tetrick Well No 2

Mannington Dist. Marion Co.

Completed 12-8-01

El. 1482.80 ground

1484.40 Derrick Floor

P&h. Coal 878

Gas Sand 1670

Injun 2240

oil 2323

slate 2317 - 2321

Total 2336

purchased by S.P.O. Co. - 7/16/02  
Abandoned 3/19/19