

Latitude

.645
.31w

Longitude

Topo Location

7.5' Loc. _____ 15' Loc. _____
 _____ (calc.) _____

Company Manufact Lt & HT

Farm James H Teagarden #2


15' Quad _____
(sec.)

7.5' Quad Wilcoxville

District Liberty

WELL LOCATION PLAT

County 051 **Permit** 136

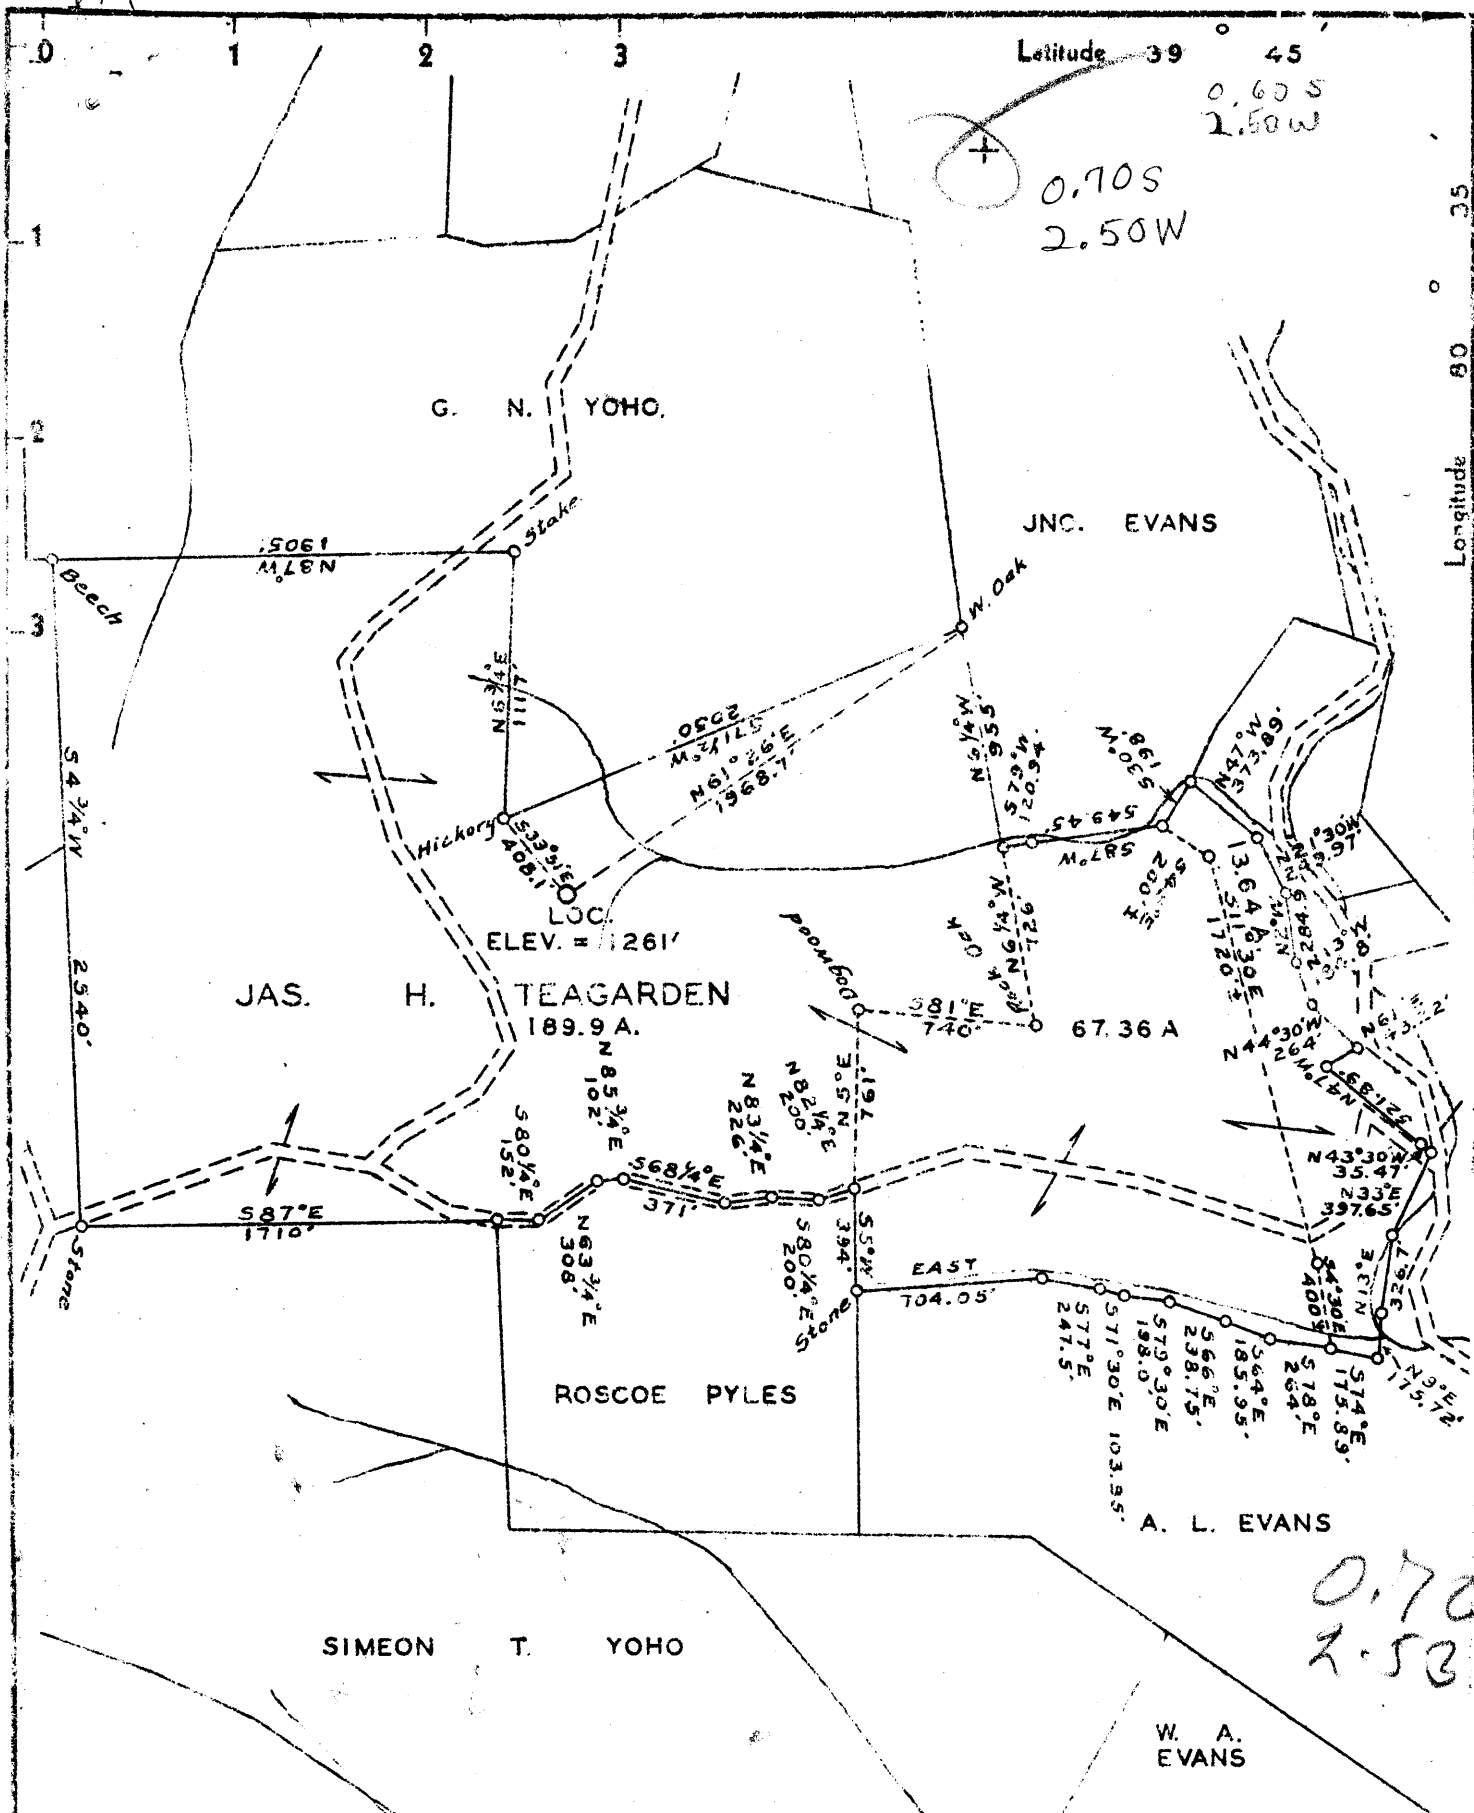

T. L. ROGERSON, MOUNDSVILLE W. VA. OWNS COAL ON 189.9A. AND 67.36A. TRACTS. STATE OF WEST VIRGINIA OWNS COAL ON 13.64 A. TRACT.

New Location..
 Drill Deeper.....
 Abandonment.....

Company THE MANUFACTURERS LIGHT & HEAT CO.
 Address 800 UNION TRUST BLDG. PITTSBURGH PA.
 Farm JAMES H. TEAGARDEN
 Tract _____ Acres 260 Lesse No. 2291
 Well (Farm) No. 2 Serial No. _____
 Elevation (Spirit Level) 1261'
 Quadrangle LITTLETON N. W. N.C.
 County MARSHALL District LIBERTY
 Engineer *A. C. Strator*
 Engineer's Registration No. _____
 File No. A.C.S. F.B.I PG.52 Drawing No. Y - 10 / 836
 Date *Oct. 30-42* Scale 1" = 800'

STATE OF WEST VIRGINIA
 DEPARTMENT OF MINES
 OIL AND GAS DIVISION
 CHARLESTON
 WELL LOCATION MAP
 File No. *MARS-136*

+ Denotes location of well on United States Topographic Maps, scale 1 to 62,500, latitude and longitude lines being represented by border lines as shown.
 — Denotes one inch spaces on border line of original tracing.

WEST VIRGINIA DEPARTMENT OF MINES
OIL & GAS DIVISION
W E L L R E C O R D

Permit No. Mars 136		Gas Well
Littleton N.W. Quad.		CASING & TUBING
Company	The Manf. Light & Heat Co.	
Address	800 Union Trust Bldg., Pittsburgh, Pa.	10 285'6 Same
Farm	James H. Teagarden Acres 260	8½ 1494'9 Same
Location		4 2073'9 Same
Well No	2- 3681 Elev. 1261'	
District	Liberty Marshall County	
Surface	O.A. Teagarden, R.D.1, Moundsville, W.Va.	
Mineral	The M L & H Co., 800 Union Trust Bldg. Pittsburgh, Pa.	Anchor Packer Size 8½ x 4" Depth 2037
Commenced	1-13-43	
Completed	2-12-43	
Open flow	50/10ths M in 2"	
Volume	820.338 C.F.	Coal at 847' 24";
Rock Pressure	350 lbs. 48 hrs.	943' 48"

Clay	0	12	
Sand	12	40	
Slate	40	50	
Sand	50	60	
Slate & R. Rock	60	137	
Sand	137	190	
Slate & Lime	190	237	
Sand	237	292	
Slate & Lime	292	385	
Red Rock	385	415	
Slate & Lime	415	605	
Sand	605	645	
Slate	645	657	Show of gas 620-627
Sand	657	668	
Lime	668	682	
Red Rock	682	695	
Slate & Lime	695	765	
Red Rock	765	785	
Lime	785	847	
Coal	847	849	
Slate & Lime	849	943	
Pittsburgh Coal	943	947	
Slate & Lime	947	1025	
Red Rock	1025	1040	
Slate & Shell	1040	1080	
Red Rock	1080	1110	
Slate	1110	1120	
Red Rock	1120	1137	
Lime & Slate	1137	1222	
Red Rock	1222	1255	
Slate & Lime	1255	1295	
Dunkard Sand	1285	1318	
Slate	1318	1335	
Red Rock	1335	1358	
Lime	1358	1365	
Sand	1365	1395	
Lime	1395	1415	
Slate	1415	1485	
Lime & Slate	1485	1620	
First Salt Sand	1620	1648	
Limo Shells	1648	1685	
Slate & Limo	1685	1850	
Sand	1850	1860	
Slate, Limo Shells, Shale	1860	1967	
Marion Sand	1967	2006	Gas 1979 to 1985
Lime & Slate	2006	2027	Gas 2050 to 2063
Big Injun Sand	2027	2065	
Total Depth		2065	

Gas