

39°47'30"

**Latitude**

80°35'00"

**Longitude**

285s  
42w

**Topo Location**

7.5' Loc. \_\_\_\_\_ 15' Loc. \_\_\_\_\_  
(calc.) \_\_\_\_\_

**Company** Guy & G Patterson

**Farm** WP Bonar Trust #2

**15' Quad** \_\_\_\_\_  
(sec.)

**7.5' Quad** Cameron

**District** Liberty


**WELL LOCATION PLAT**

**County** 051 **Permit** 176

Latitude 39° 50'

Longitude 80° 35'

LOU A. CONNELLY to W.P. Bonar, Trustee,  
Girl Scout Council of Moundsville.  
Sept 20, 1928 - D.B. 188-P41.  
7 1/2 Ac.

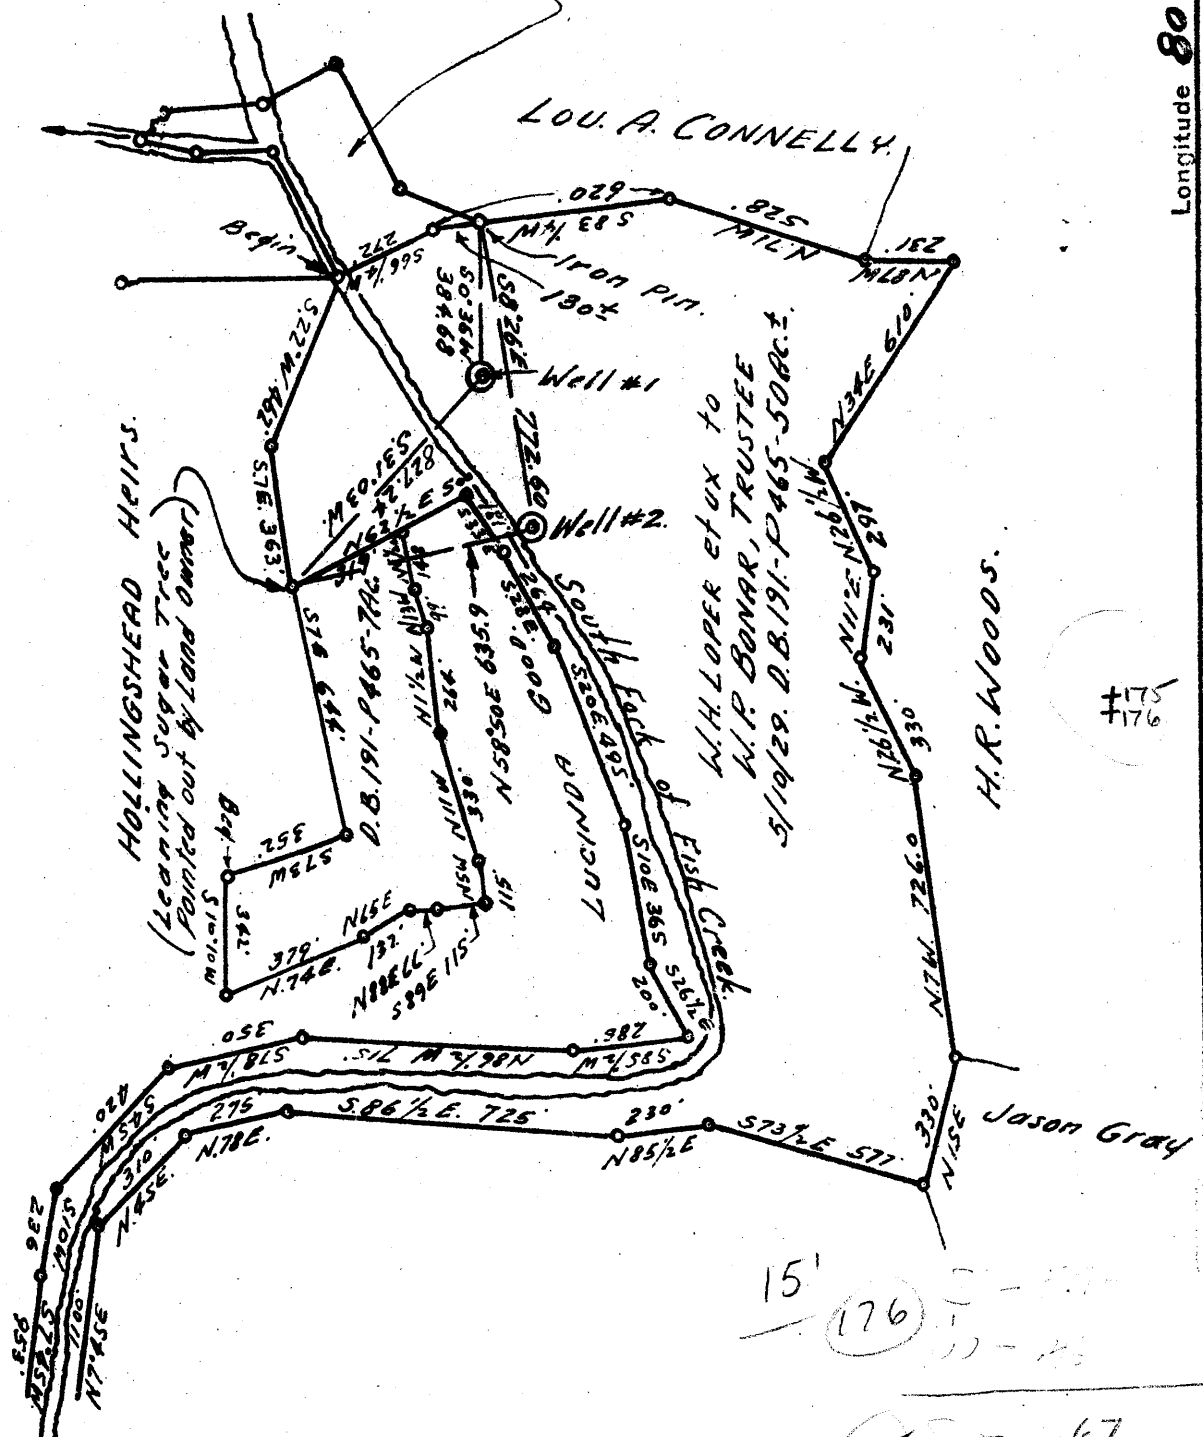

New Location    
 Drill Decr.    
 Abandonment

Company GUY B & A.G. PATTERSON.  
 Address CAMERON W. VA.  
 Farm W.P. BONAR, Trustee, G.S.C.M. (formerly HILL)  
 Tract 1 Acres 57, Lease No. \_\_\_\_\_  
 Well (arm) No. 1 & 2, Serial No. \_\_\_\_\_  
 Elevation (Spirit Level) Well No. 1-835; - No 2-832  
 Quadrangle CAMERON.  
 County MARSHALL District LIBERTY  
 Engineer WALTER W. STEGMAN.  
 Engineer's Registration No. 394  
 File No. G.S.7 - P105. Drawing No. \_\_\_\_\_  
 Date APR. 15, 1947. Scale 1 inch = 500 Feet.

STATE OF WEST VIRGINIA  
 DEPARTMENT OF MINES  
 OIL AND GAS DIVISION  
 CHARLESTON

WELL LOCATION MAP  
 FILE NO. MARS-175-#1-176#2

+ Denotes location of well on United States Topographic Maps, scale 1 to 62,500, latitude and longitude lines being represented by border lines as shown.  
 - Denotes one inch spaces on border line of original tracing.

WEST VIRGINIA DEPARTMENT OF MINES  
OIL & GAS DIVISION  
W E L L R E C O R D

Permit No.	Mars 176			
Cameron Quad.				Dry Hole
Company	Guy B. and A.G. Patterson			CASING & TUBING
Address	Cameron, W. Va.	Trustee	10	21
Farm	(Isaac Hill) W.P. Bonar/A 57		8 1/2	102
Location	Fish Creek		6 5/8	263
Well No.	2	Elev.	832	
District	Liberty	Marshall County		
Surface	W.P. Bonar, Star Route, Cameron, W. Va.			
Mineral	Clara Hopkins, Cameron, Sidney Goodman			
	4724 Coleridge St., Pittsburgh, Pa.			
Commenced	June 29, 1948			Coal at 250'- 252
Completed	Aug. 28, 1948			450'- 451-6
Open flow	1/10ths W in 1/4 plate			
Fresh Water	70'- 125'			

Clay			20	
Lime	Gritty		20	45
Shale	Dk		45	60
Lime			60	140
Sand		H	140	158
Slate			158	170
Lime			170	190
Coal			190	192
Slate			192	200
Lime			200	225
Slate			225	230
Lime	Gritty		230	245
Slate			245	250
Waynesburg Coal			250	253
Slate			253	258
Lime			258	262
Slate			262	268
Lime			268	276
Slate			276	285
Lime			285	300
Slate			300	323
Lime			323	340
Slate		S	340	345
Lime			345	352
Slate			352	360
Lime			360	366
Pink Rock			366	374
Slate	Wh	S	374	393
Lime			393	406
Slate			406	417
Lime	H		417	431
Slate			431	440
Lime			440	445
Slate			445	450
Mapletown Coal			450	453
Slate			453	458
Lime			458	467
Total Depth			471	