


Well is located on topo map 7,851 feet south of Latitude: 39° 57' 30"

Well is located on topo map 10,821 feet west of Longitude: 80° 30' 00"



WELL LOCATION
 UTM 17-NAD83
 N:4420853.59
 E:539440.30
 NAD83, WV NORTH
 N:525043.445
 E:1677336.833
 LAT/LON DATUM-WGS84
 LAT:39°53'59.44916"
 LON:-80°53'76.14282"

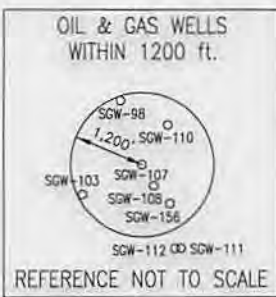

LINE	BEARING	DISTANCE
L1	S 89°35'00" W	190.10'
L2	N 32°27'00" E	319.00'
L3	N 02°07'00" E	582.00'
L4	N 25°48'00" W	430.00'
L5	N 43°03'00" W	198.00'
L6	N 10°13'00" W	315.00'
L7	N 30°00'00" W	163.00'
L8	N 38°32'00" W	536.00'
L9	N 12°27'00" W	281.00'
L10	N 25°15'00" E	203.00'
L11	N 50°35'00" E	244.00'
L12	N 76°02'00" E	231.00'
L13	N 78°45'00" E	49.50'
L14	N 68°30'00" E	231.00'
L15	N 59°30'00" E	94.00'
L16	N 44°45'00" E	86.00'
L17	N 88°15'00" E	600.00'
L18	N 73°15'00" E	510.00'
L19	S 01°45'00" W	831.00'
L20	S 02°45'00" W	730.00'

Blue Mountain Inc.
 11023 MASON DIXON HIGHWAY
 BURTON, WV 26582
 PHONE: (304) 662-6486

BRIAN K. MILLIKEN
 TM/PAR 15-5/43
 DB/PG 665/461
 102.087 ACRES ±

NOTE
 It is not the purpose or intention of this plat to represent surveyed locations of the surface or mineral parcels depicted hereon. The location of the boundary lines, as shown, are based on record deed descriptions, field evidence found and/or tax map position, unless otherwise noted.

FILE #: SGW-107
 DRAWING #: SGW-107
 SCALE: 1" = 600'
 MINIMUM DEGREE OF ACCURACY: 1/2500
 PROVEN SOURCE OF ELEVATION: U.S.G.S. MONUMENT THOMAS 1498.81'

I, THE UNDERSIGNED, HEREBY CERTIFY THAT THIS PLAT IS CORRECT TO THE BEST OF MY KNOWLEDGE AND BELIEF AND SHOWS ALL THE INFORMATION REQUIRED BY LAW AND THE REGULATIONS ISSUED AND PRESCRIBED BY THE DEPARTMENT OF ENVIRONMENTAL PROTECTION.
 Signed: [Signature]
 R.P.E.: _____ L.L.S.: P.S. No. 2000

GEORGE D. SIX
 LICENSED
 No. 2000
 STATE OF WEST VIRGINIA
 PROFESSIONAL SURVEYOR
 PLACE SEAL HERE

(+) DENOTES LOCATION OF WELL ON UNITED STATES TOPOGRAPHIC MAPS WVDEP
 OFFICE OF OIL & GAS
 601 57TH STREET
 CHARLESTON, WV 25304



DATE: JUNE 23, 2014
 OPERATOR'S WELL #: SGW-107
 API WELL #: 47 51 00193 P
 STATE COUNTY PERMIT


Well Type: Oil Waste Disposal Production Deep
 Gas Liquid Injection Storage Shallow

WATERSHED: DUNKARD FORK ELEVATION: 1266.34'
 COUNTY/DISTRICT: MARSHALL/WEBSTER QUADRANGLE: MAJORSVILLE, WV-PA 7.5'
 SURFACE OWNER: BRIAN K. MILLIKEN ACREAGE: 102.087±
 OIL & GAS ROYALTY OWNER: _____ ACREAGE: _____
 DRILL CONVERT DRILL DEEPER REDRILL FRACTURE OR STIMULATE
 PLUG OFF OLD FORMATION PERFORATE NEW FORMATION PLUG & ABANDON
 CLEAN OUT & REPLUG OTHER CHANGE (SPECIFY): _____
 TARGET FORMATION: NONE ESTIMATED DEPTH: _____
 WELL OPERATOR CONSOLIDATION COAL CO. DESIGNATED AGENT ALEX O'NEILL
 Address 6126 ENERGY ROAD Address 6126 ENERGY ROAD
 City MOUNDSVILLE State WV Zip Code 26041 City MOUNDSVILLE State WV Zip Code 26041

07/25/2014

LATITUDE 39°57'30"

LONGITUDE 80°30'00"

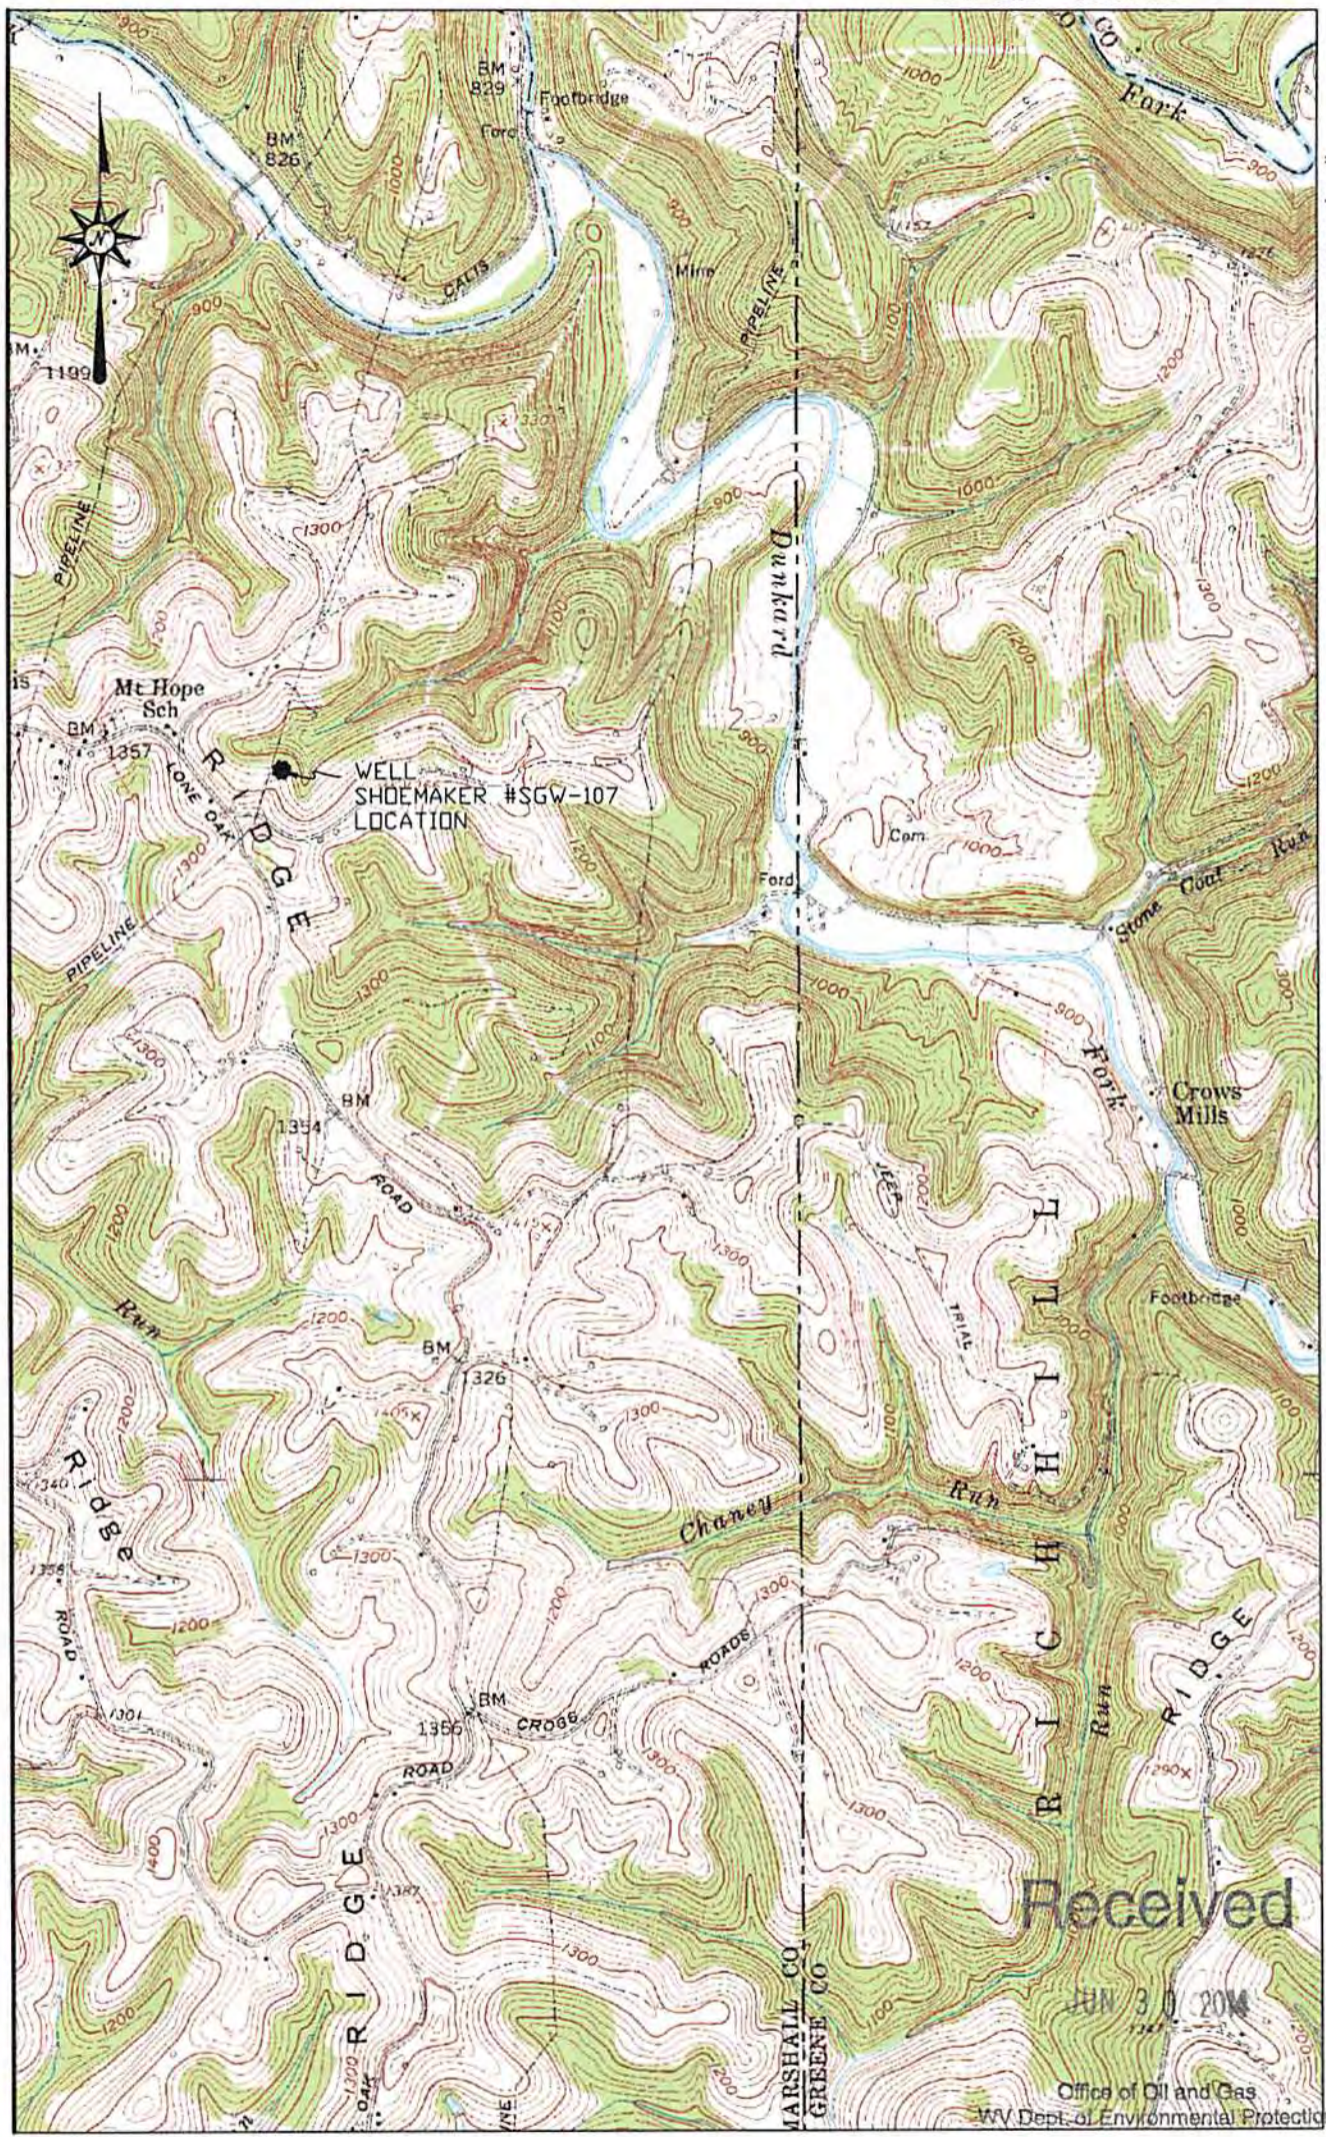

LOCATION MAP
JUNE 23, 2014

Blue Mountain Inc.
 11023 MASON DIXON HIGHWAY
 BURTON, WV 26562
 PHONE: (304) 662-6486

SHOEMAKER WELL # SGW-107
 MAJORSVILLE QUADRANGLE
 WEST VIRGINIA - PENNSYLVANIA 0'

SCALE 1" = 2000'
 2000' 4000' 6000'



BLUE MOUNTAIN INC.