

STATE OF WEST VIRGINIA
DEPARTMENT OF ENVIRONMENTAL PROTECTION
OFFICE OF OIL AND GAS

AFFIDAVIT OF PLUGGING AND FILLING WELL

AFFIDAVIT SHOULD BE IN TRIPLICATE, one copy mailed to the Department, one copy to be retained by the Well Operator and the third copy (and extra copies if required) should be mailed to each coal operator at their respective addresses.

Farm name: Fry, C. Operator Well No.: Victory B 3025

LOCATION: Elevation: 821' Quadrangle: Littleton
District: Liberty County: Marshall
Latitude: 4490 Feet South of 39 Deg. 45 Min. 00 Sec.
Longitude: 3895 Feet West of 80 Deg. 35 Min. 00 Sec.

RECEIVED
Office of Oil and Gas

SEP 02 2026

Well Type: OIL ☐ GAS ☒

WV Department of
Environmental Protection

Company	<u>Columbia Gas Transmission, LLC</u>	Coal Operator	<u>Consol RCPC, LLC</u>
	<u>1700 MacCorkle Avenue S.E., P.O. Box 1273</u>	or Owner	<u>275 Technology Drive, Suite 101</u>
	<u>Charleston, WV 25325</u>		<u>Canonsburg, PA 15317</u>
Agent	<u>Brad Nelson, Storage Engineer</u>	Coal Operator	<u>Marshall County Resources, Inc.</u>
		or Owner	<u>46226 National Road West</u>
Permit Issued Date	<u>4/23/2026</u>		<u>St. Clairsville, OH 43950</u>

AFFIDAVIT

STATE OF WEST VIRGINIA,
County of Marshall ss:

Brad Nelson and Garrett Miller being first duly sworn according to law depose and say that they are experienced in the work of plugging and filling oil and gas wells and were employed by the above named well operator, and participated in the work of plugging and filling the above well say that said work was commenced on the 23rd day of June, 2026, and the well was plugged and filled in the following manner:

TYPE	FROM	TO	PIPE REMOVED	LEFT
Class A Cement	0'	253'	N/A	7", 8-5/8", 10-3/4"
Class A Cement	253'	1111'	N/A	7", 8-5/8"
Class A Cement	1111'	1560'	N/A	7"
Cast Iron Bridge Plug (CIBP)	1560'	1577'	N/A	7"
Class A Cement	1577'	1760'	N/A	7", (unknown fish at 1742')
Class A Cement	1760'	1994'	N/A	N/A

Description of monument: 7" diameter pipe, 6' above GL, API affixed and that the work of plugging and filling said well was completed on the 30th day of July, 2026.

And further deponents saith not.

Sworn and subscribe before me this 4th day of August, 2026

My commission expires: 10/23/2027

Commonwealth of Pennsylvania - Notary Seal
Jennifer Lupi, Notary Public
Washington County
My commission expires October 23, 2027
Commission number 1282201

Notary Public

Affidavit reviewed by the Office of Oil and Gas: Strader Gower Title: Oil & Gas Inspector 09/18/2026

~ not to scale ~

Victory B 3025

API 47-051-00281

Post P&A

(as of 7/30/2026)

RECEIVED
Office of Oil and Gas

SEP 02 2026

WV Department of
Environmental Protection

Pittsburgh Coal 576 - 583'

Sea Level @ +/- 824'

Big Dunkard sandstone 1047 - 1147'

Gas Sand 1201 - 1220'

First Salt Sand 1242 - 1269'

Second Salt Sand 1335 - 1367'

Third Salt Sand 1468 - 1499'

Maxton Sand 1557 - 1655' (gas storage)

Big Injun Sand 1711 - 1984' (gas storage)

Cemented to/near surface

Cemented to/near surface

Cement Plug #4 Top @ 0'

10-3/4" 32# H-40 csg @ 253'

Solid grey fill indicates cement installed during P&A

Cement Plug #3 Top @ 604'

Steel shoe @ 788'

Ran on bottom of upper casing string and set on top of old 8-5/8" casing stub

Cement Plug #2 Top @ 1104'

8-5/8" csg @ 1111'

24# J-55 ran 0 - 788'

Unknown weight/grade 788 - 1111'

A 7" CBL ran on 7/23/2026 showed cement at / near surface. No attempt to perf / squeeze was performed. Attempted to pull 50K lbs. on 7" with no movement. Plugged well to surface after consultation with WVDEP Inspector.

Hashed fill reflects existing cement

Cast Iron Bridge Plug (CIBP) @ 1560'

Cement Plug #1 Top @ 1577'

7" 20# csg @ 1760'

1441' grade unknown (no record of location in string)

327' of J-55 (no record of location in string)

Attempted to fish an obstruction (unknown, had not been identified in well records) at 1745'. Ran 2-3/8" tubing through obstruction to 1748'. Ran a CCL through work string into open hole and tagged TD at 1994.7'. Confirmed no collars below 7" casing shoe at 1760'. Cemented well from TD after consultation with WVDEP Inspector, leaving unknown fish in hole.

PBTD 1997'

Plugged back as follows:

cement 1997 - 2356'

BP @ 2356"

openhole 2356 - 2675'

Tagged TD at 1994.7'

TD 2675'

09/18/2026


~ not to scale ~

Victory B 3025

API 47-051-00281

Prior to P&A

(as of 4/12/24)

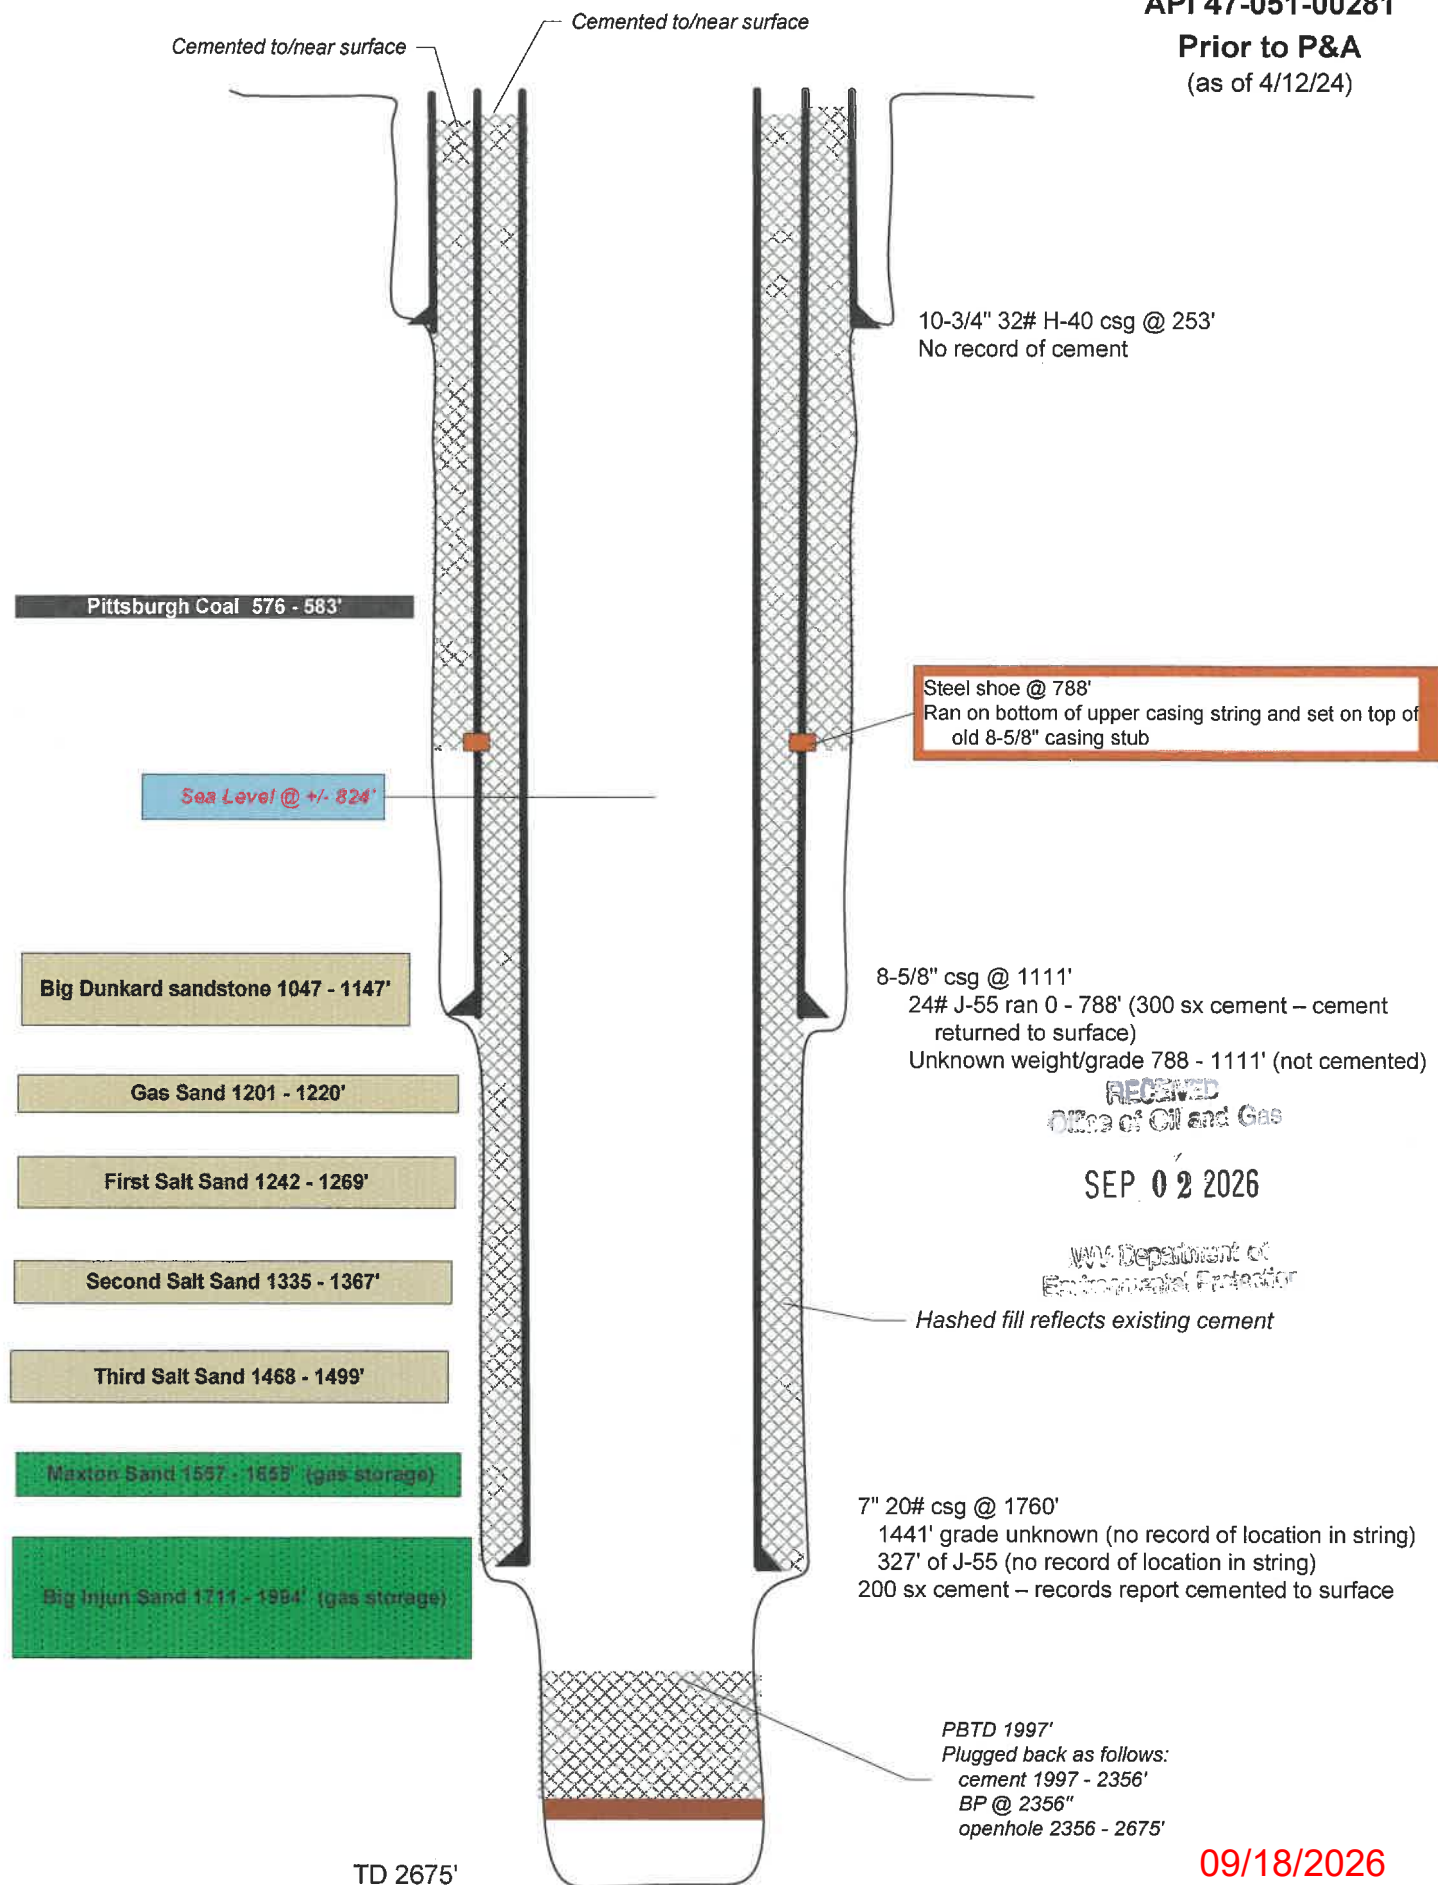

09/18/2026