

STATE OF WEST VIRGINIA
DEPARTMENT OF ENVIRONMENTAL PROTECTION
OFFICE OF OIL AND GAS

AFFIDAVIT OF PLUGGING AND FILLING WELL

AFFIDAVIT SHOULD BE IN TRIPLICATE, one copy mailed to the Department, one copy to be retained by the Well Operator and the third copy (and extra copies if required) should be mailed to each coal operator at their respective addresses.

Farm name: Stern, George Operator Well No.: Victory B 4359

LOCATION: Elevation: 1289' Quadrangle: Wileyville
District: Liberty County: Marshall
Latitude: 8080 Feet South of 39 Deg. 45 Min. 00 Sec.
Longitude: 1485 Feet West of 80 Deg. 37 Min. 30 Sec.

RECEIVED
Office of Oil and Gas

JUN 18 2026

WV Department of
Environmental Protection

Well Type: OIL GAS X

Company	<u>Columbia Gas Transmission, LLC</u>	Coal Operator	<u>Consol RCPC, LLC</u>
	<u>1700 MacCortle Avenue S.E., P.O. Box 1273</u>	or Owner	<u>275 Technology Drive, Suite 101</u>
	<u>Charleston, WV 25325</u>		<u>Canonsburg, PA 15317</u>
Agent	<u>Brad Nelson, Storage Engineer</u>	Coal Operator	<u>Marshall County Coal Resources, Inc.</u>
		or Owner	<u>46226 National Road West</u>
Permit Issued Date	<u>12/29/2025</u>		<u>St. Clairsville, OH 43950</u>

Pennsylvania
STATE OF ~~WEST VIRGINIA~~
County of Washington ss:

AFFIDAVIT

Brad Nelson and Steve Simmons being first duly sworn according to law depose and say that they are experienced in the work of plugging and filling oil and gas wells and were employed by the above named well operator, and participated in the work of plugging and filling the above well say that said work was commenced on the 11th day of May, 2026, and the well was plugged and filled in the following manner:

TYPE	FROM	TO	PIPE REMOVED	LEFT
Class A Cement	0'	1172'	N/A	7", 8-5/8", 10-3/4"
Class A Cement	1172'	1388'	N/A	7", 8-5/8"
Class A Cement	1388'	1665'	N/A	7"
Cast Iron Bridge Plug (CIBP)	1665'	1700'	N/A	7"
Class A Cement	1700'	2130'	N/A	7"
Class A Cement	2130'	2460'	N/A	N/A

Description of monument: 7" diameter pipe, 4' above GL, API and date affixed
said well was completed on the 26th day of May, 2026.

and that the work of plugging and filling

And further deponents saith not.

Sworn and subscribe before me this 9th day of June, 2026

My commission expires: 11/18/2027

Notary Public

Affidavit reviewed by the Office of Oil and Gas: Strader Gower

Title: Oil & Gas Inspector

06/16/2026

06/26/2026

Commonwealth of Pennsylvania - Notary Seal
EMILY KALE LEACH, Notary Public
Washington County
My Commission Expires November 18, 2027
Commission Number 1359854

~ not to scale ~

Victory B 4359

API 47-051-00299

Post P&A

(as of 6/5/2026)

RECEIVED
Office of Oil and Gas

JUN 18 2026

WV Department of
Environmental Protection

Cement top behind 7" casing was good from TD to ~800' from surface. Intermittent bonding from 800' to surface as per CBL ran 5/14/2026. Squeeze perforations shot every 100' at 800', 700', 600', 500', 400', 300', and 200' after consultation with WVDEP inspector on 5/19/2026.

Pittsburgh Coal 1006 - 1115'

Sea Level @ +/- 1297'

Big Dunkard sandstone 1483 - 1541'

Gas Sand 1589 - 1615'

First Salt Sand 1653 - 1774'

Second Salt Sand 1840 - 1864'

Third Salt Sand 1896 - 1931'

Maxton Sand 2025 - 2097' (gas storage)

Big Injun Sand 2191 - 2407' (gas storage)

Cemented to/near surface

Cement Plug #3 Top @ 0'

10-3/4" 32# H-40 csg @ 1172'

Cement Plug #2 Top @ 895'

8-5/8" 24# J-55 csg @ 1388'

Solid grey fill indicates cement installed during P&A

Hashed fill reflects existing cement

Cast Iron Bridge Plug (CIBP) @ 1665'

Cement Plug #1 Top @ 1700'

7" 20# J-55 csg @ 2130'

Found hard bottom at 2460' on 5/13/2026.
See well records for plugging information below this depth.

TD 2470'

06/26/2026


~ not to scale ~

Victory B 4359

API 47-051-00299

Prior to P&A

(as of 4/12/24)

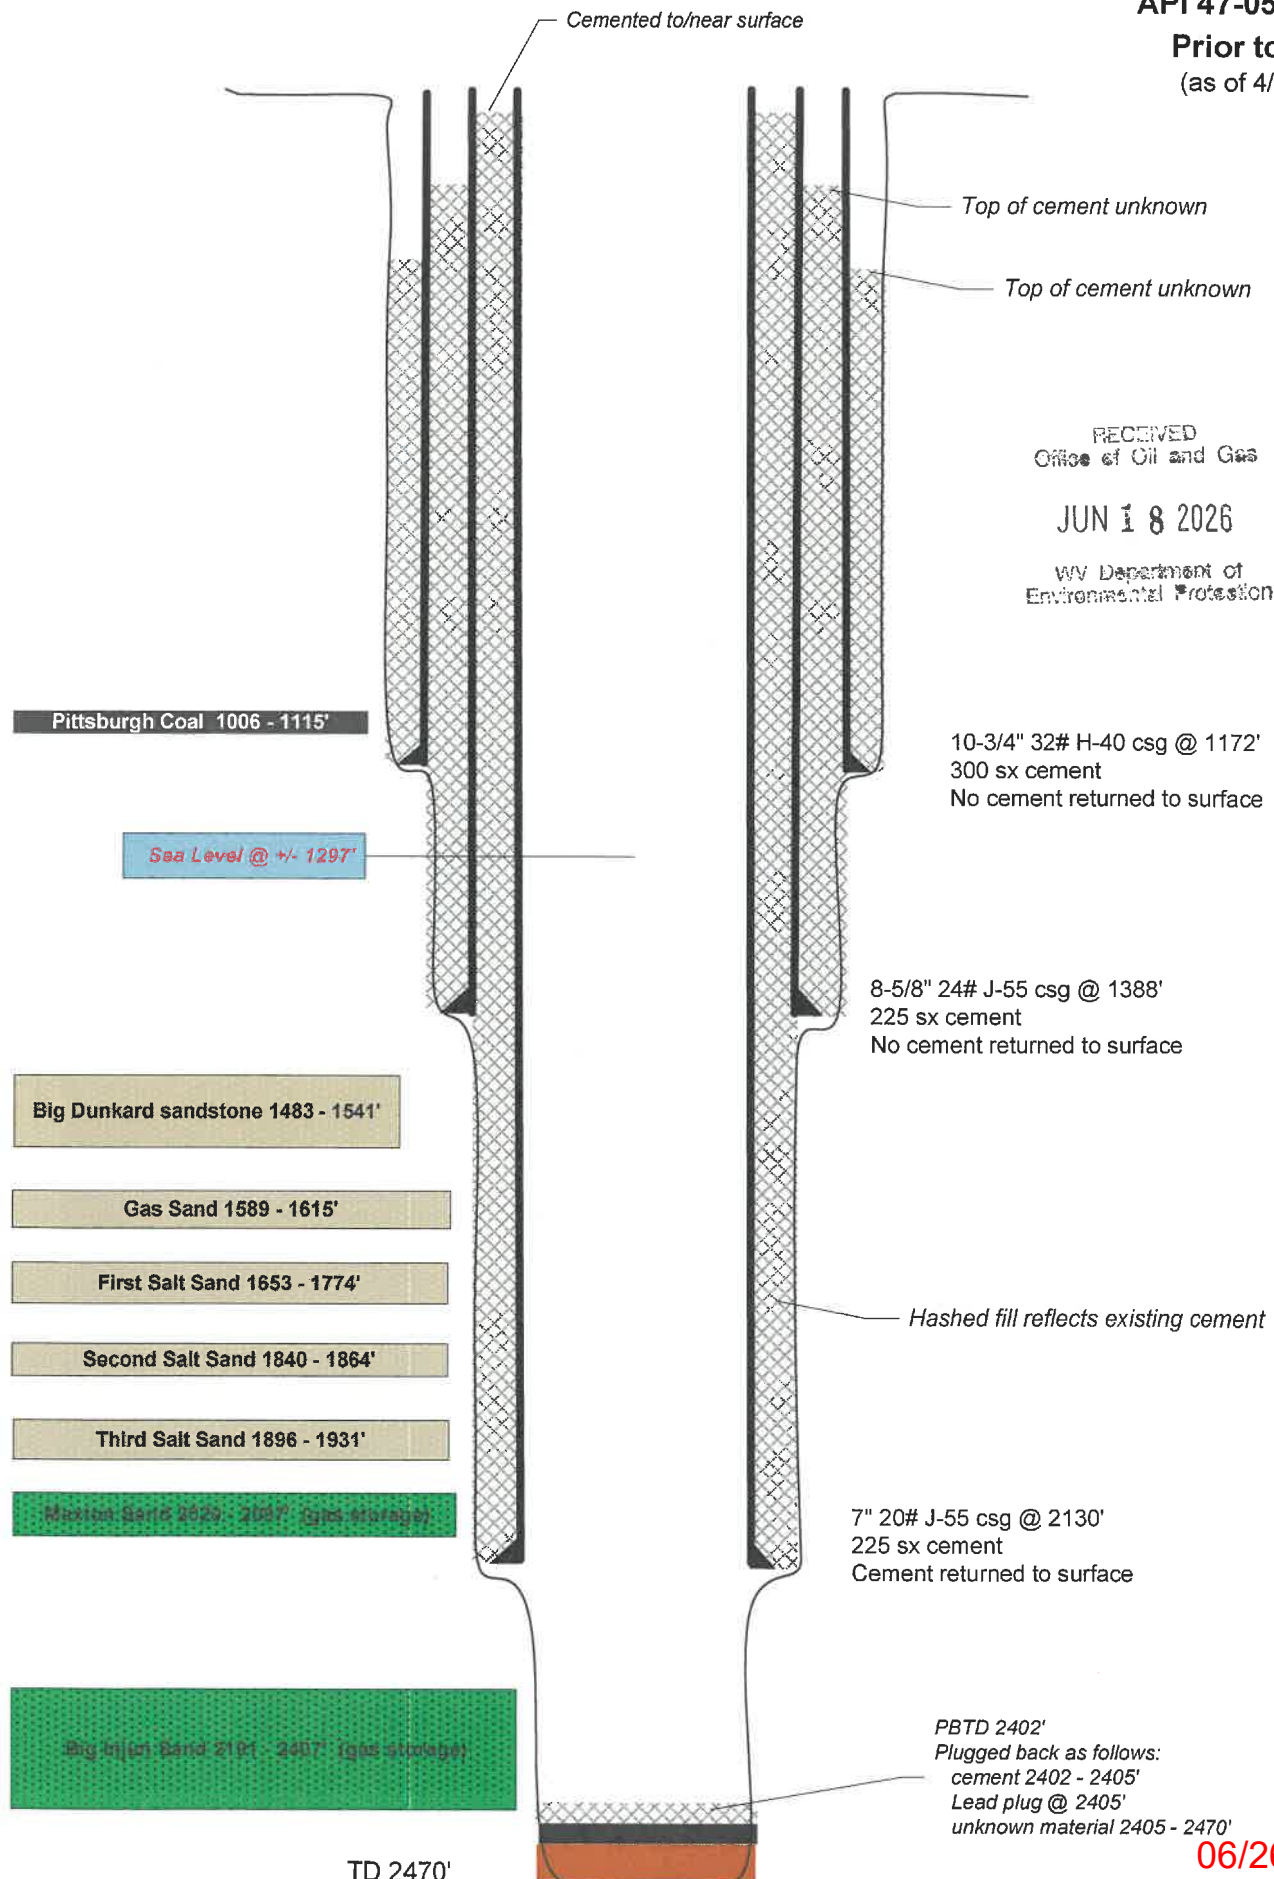

06/26/2026