

COAL OWNED BY Manor Real Estate Co.

NEW LOCATION

DRILL DEEPER

ABANDONMENT *issued July 27, 1970*

COMPANY THE MANUFACTURERS LIGHT & HEAT
 ADDRESS 800 UNION TRUST BLDG. PHA. PA.
 FARM G.W. PHILLIPS
 TRACT _____ ACRES 160 LEASE No. 19406
 WELL (FARM) No. 3 SERIAL No. 3593
 ELEVATION (SPIRIT LEVEL) 1286.64'
 QUADRANGLE CAMMERON NE
 COUNTY MARSHALL DISTRICT WEBSTER
 ENGINEER A.G. Strator M.
 ENGINEER'S REGISTRATION No. 9442
 FILE No. _____ DRAWING No. Y-15-535
 DATE 28 FEB. 1957 SCALE 1" = 800'


STATE OF WEST VIRGINIA
 DEPARTMENT OF MINES
 OIL AND GAS DIVISION
 CHARLESTON

WELL LOCATION MAP

(Plugging) FILE No. MARS-304-D.D-P
+ Cancelled - 1-29-71

+ DENOTES LOCATION OF WELL ON UNITED STATES TOPOGRAPHIC MAPS. SCALE 1 TO 62,500. LATITUDE AND LONGITUDE LINES BEING REPRESENTED BY BORDER LINES AS SHOWN.

- DENOTES ONE INCH SPACES ON BORDER LINE OF ORIGINAL TRACING.

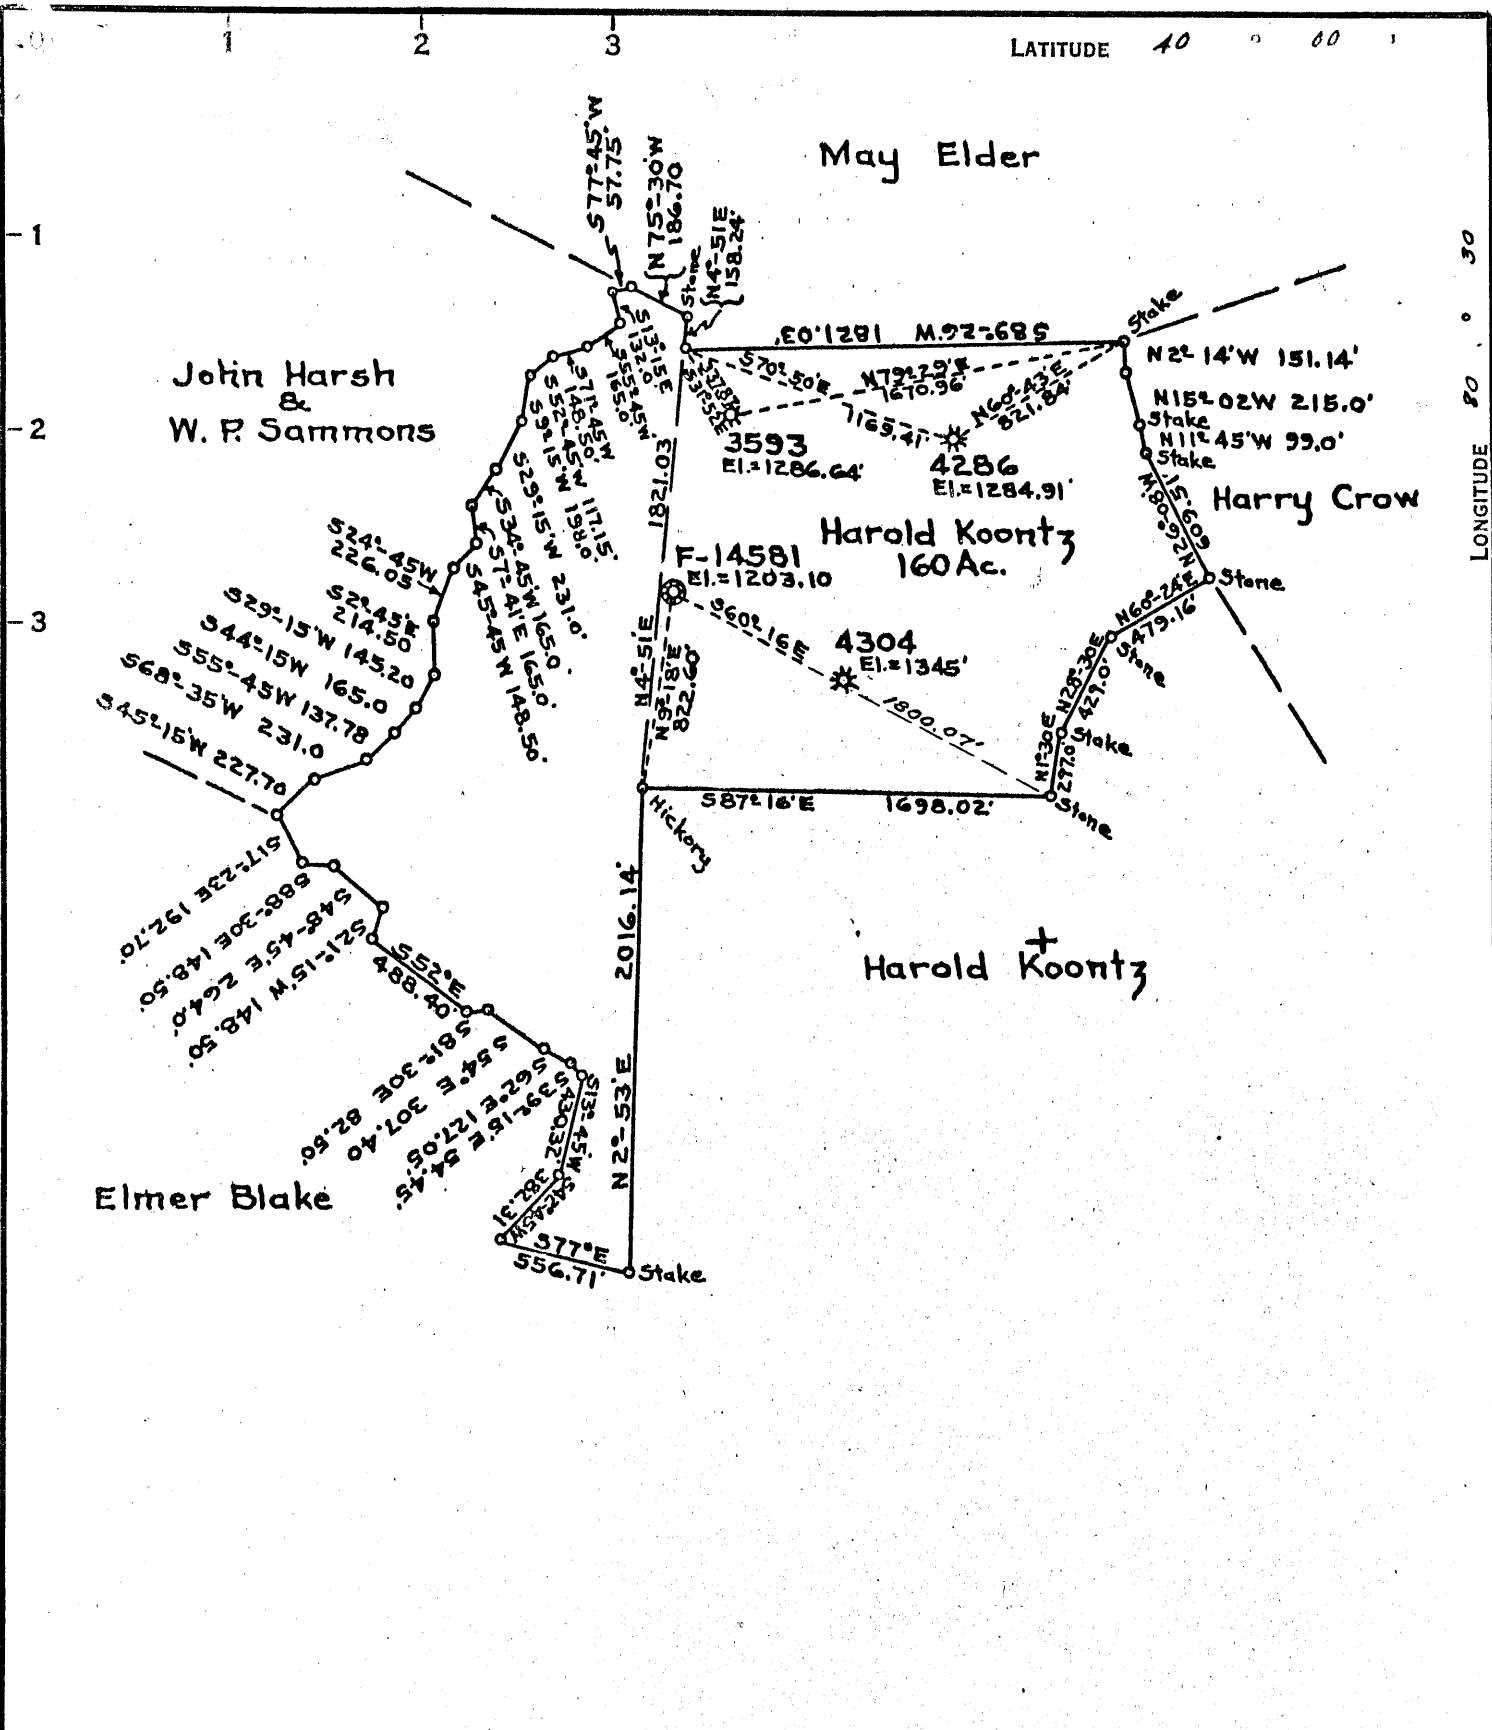

COAL OWNED BY _____

NEW LOCATION.....

DRILL DEEPER.....

ABANDONMENT.....

COMPANY THE MANUFACTURERS LIGHT & HEAT

ADDRESS 800 UNION TRUST BLDG. PGH. PA.

FARM G.W. PHILLIPS

TRACT _____ ACRES 160 LEASE No. 19406

WELL (FARM) No. 3 SERIAL No. 3593

ELEVATION (SPIRIT LEVEL) 1286.64'

QUADRANGLE CAMERON

COUNTY MARSHALL DISTRICT WEBSTER

ENGINEER A.C. Trotter M.

ENGINEER'S REGISTRATION No. 9442

FILE No. _____ DRAWING No. Y-15-535

DATE 28 FEB 1957 SCALE 1"=800'

STATE OF WEST VIRGINIA
DEPARTMENT OF MINES
OIL AND GAS DIVISION
CHARLESTON

WELL LOCATION MAP

FILE No. MARS-304-D.D

+ DENOTES LOCATION OF WELL ON UNITED STATES TOPOGRAPHIC MAPS, SCALE 1 TO 62,500. LATITUDE AND LONGITUDE LINES BEING REPRESENTED BY BORDER LINES AS SHOWN.

- DENOTES ONE INCH SPACES ON BORDER LINE OF ORIGINAL TRACING.