

STATE OF WEST VIRGINIA
DEPARTMENT OF ENVIRONMENTAL PROTECTION
OFFICE OF OIL AND GAS

AFFIDAVIT OF PLUGGING AND FILLING WELL

AFFIDAVIT SHOULD BE IN TRIPLICATE, one copy mailed to the Department, one copy to be retained by the Well Operator and the third copy (and extra copies if required) should be mailed to each coal operator at their respective addresses.

Farm name: Thomas, E. Operator Well No.: Victory B 4446

LOCATION: Elevation: 795' Quadrangle: Glen Easton, WV
District: Liberty County: Marshall
Latitude: 11770 Feet South of 39 Deg. 47 Min. 30 Sec.
Longitude: 995 Feet West of 80 Deg. 37 Min. 30 Sec.

RECEIVED
Office of Oil and Gas

SEP 02 2026

WV Department of
Environmental Protection

Well Type: OIL _____ GAS X

Company	<u>Columbia Gas Transmission, LLC</u>	Coal Operator	<u>Consol RCPC, LLC</u>
	<u>1700 MacCorkle Avenue S.E., P.O. Box 1273</u>	or Owner	<u>275 Technology Drive, Suite 101</u>
	<u>Charleston, WV 25325</u>		<u>Canonsburg, PA 15317</u>
Agent	<u>Brad Nelson, Storage Engineer</u>	Coal Operator	<u>Marshall County Resources, Inc.</u>
Permit Issued Date	<u>12/29/2025</u>	or Owner	<u>46226 National Road West</u>
			<u>St. Clairsville, OH 43950</u>

AFFIDAVIT

STATE OF WEST VIRGINIA,
County of Marshall ss:

Brad Nelson and Garrett Miller being first duly sworn according to law depose and say that they are experienced in the work of plugging and filling oil and gas wells and were employed by the above named well operator, and participated in the work of plugging and filling the above well say that said work was commenced on the 4th day of August, 2026, and the well was plugged and filled in the following manner:

TYPE	FROM	TO	PIPE REMOVED	LEFT
Class A Cement	0'	153'	7", 8-5/8"	10-3/4"
Class A Cement	153'	275'	7", 8-5/8"	N/A
Class A Cement	275'	1049'	N/A	7", 8-5/8"
Class A Cement	1049'	1220'	N/A	7"
Cast Iron Bridge Plug (CIBP)	1220'	1259'	N/A	7"
Class A Cement	1259'	1522'	N/A	7"
Class A Cement	1522'	1568'	N/A	N/A

Description of monument: 7" diameter pipe, 4' above GL, API affixed and that the work of plugging and filling said well was completed on the 17th day of August, 2026.

And further deponents saith not.

Sworn and subscribe before me this 29th day of August, 2026

Commonwealth of Pennsylvania - Notary Seal
Jennifer Lupi, Notary Public
Washington County
My commission expires October 23, 2027
Commission number 1282201

My commission expires: 10/23/2027

Notary Public

Affidavit reviewed by the Office of Oil and Gas: Strader Gower Title: Oil & Gas Inspector

09/18/2026


~ not to scale ~

Victory B 4446

API 47-051-00311

Post P&A

(as of 8/18/2026)

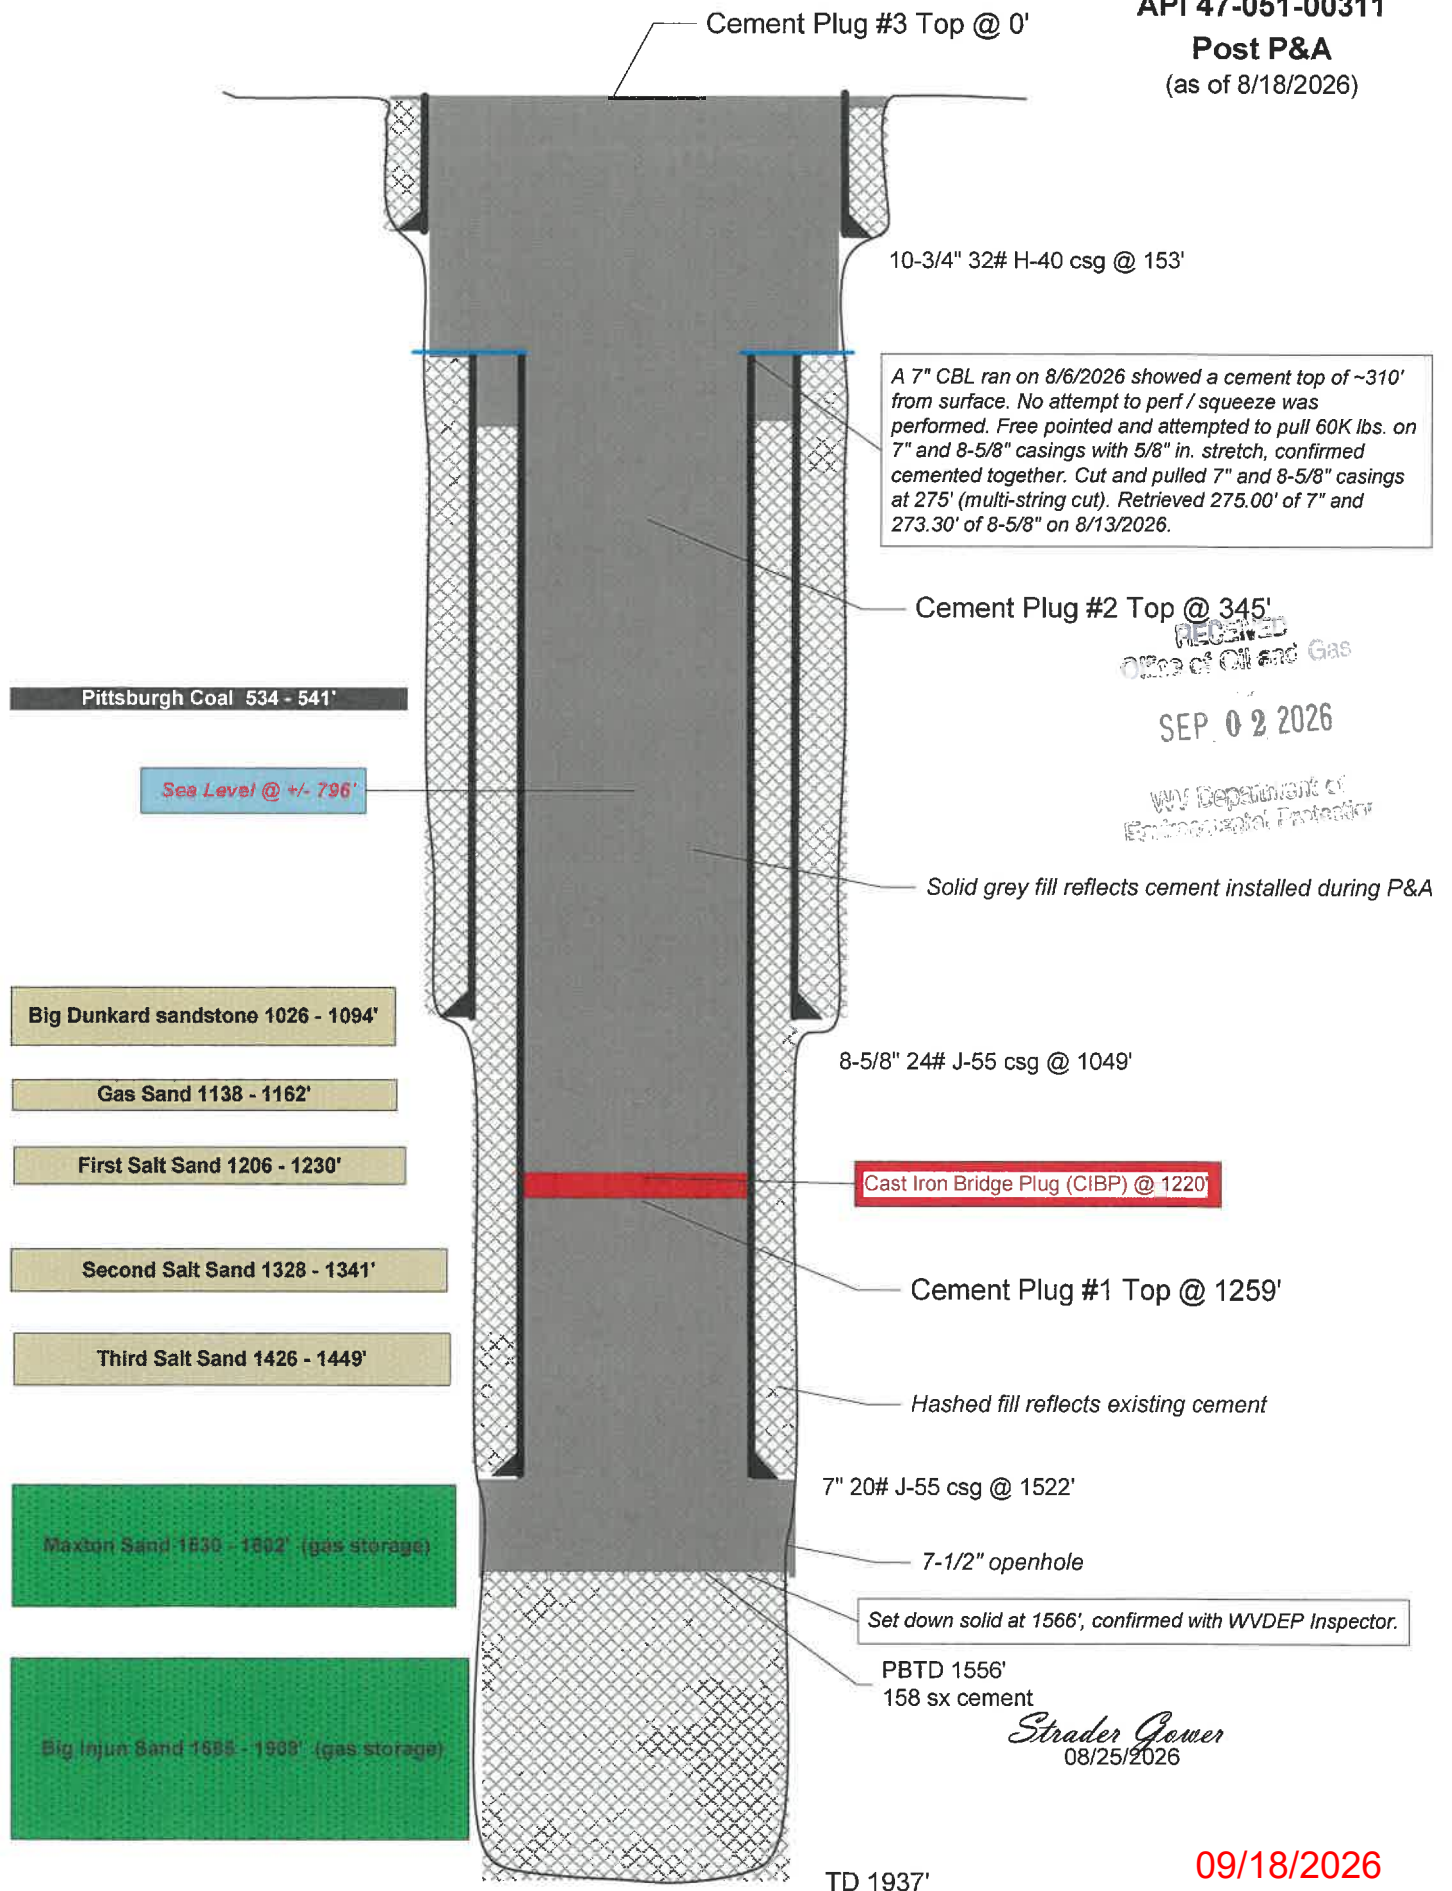

09/18/2026


~ not to scale ~

Victory B 4446

API 47-051-00311

Prior to P&A

(as of 2/27/24)

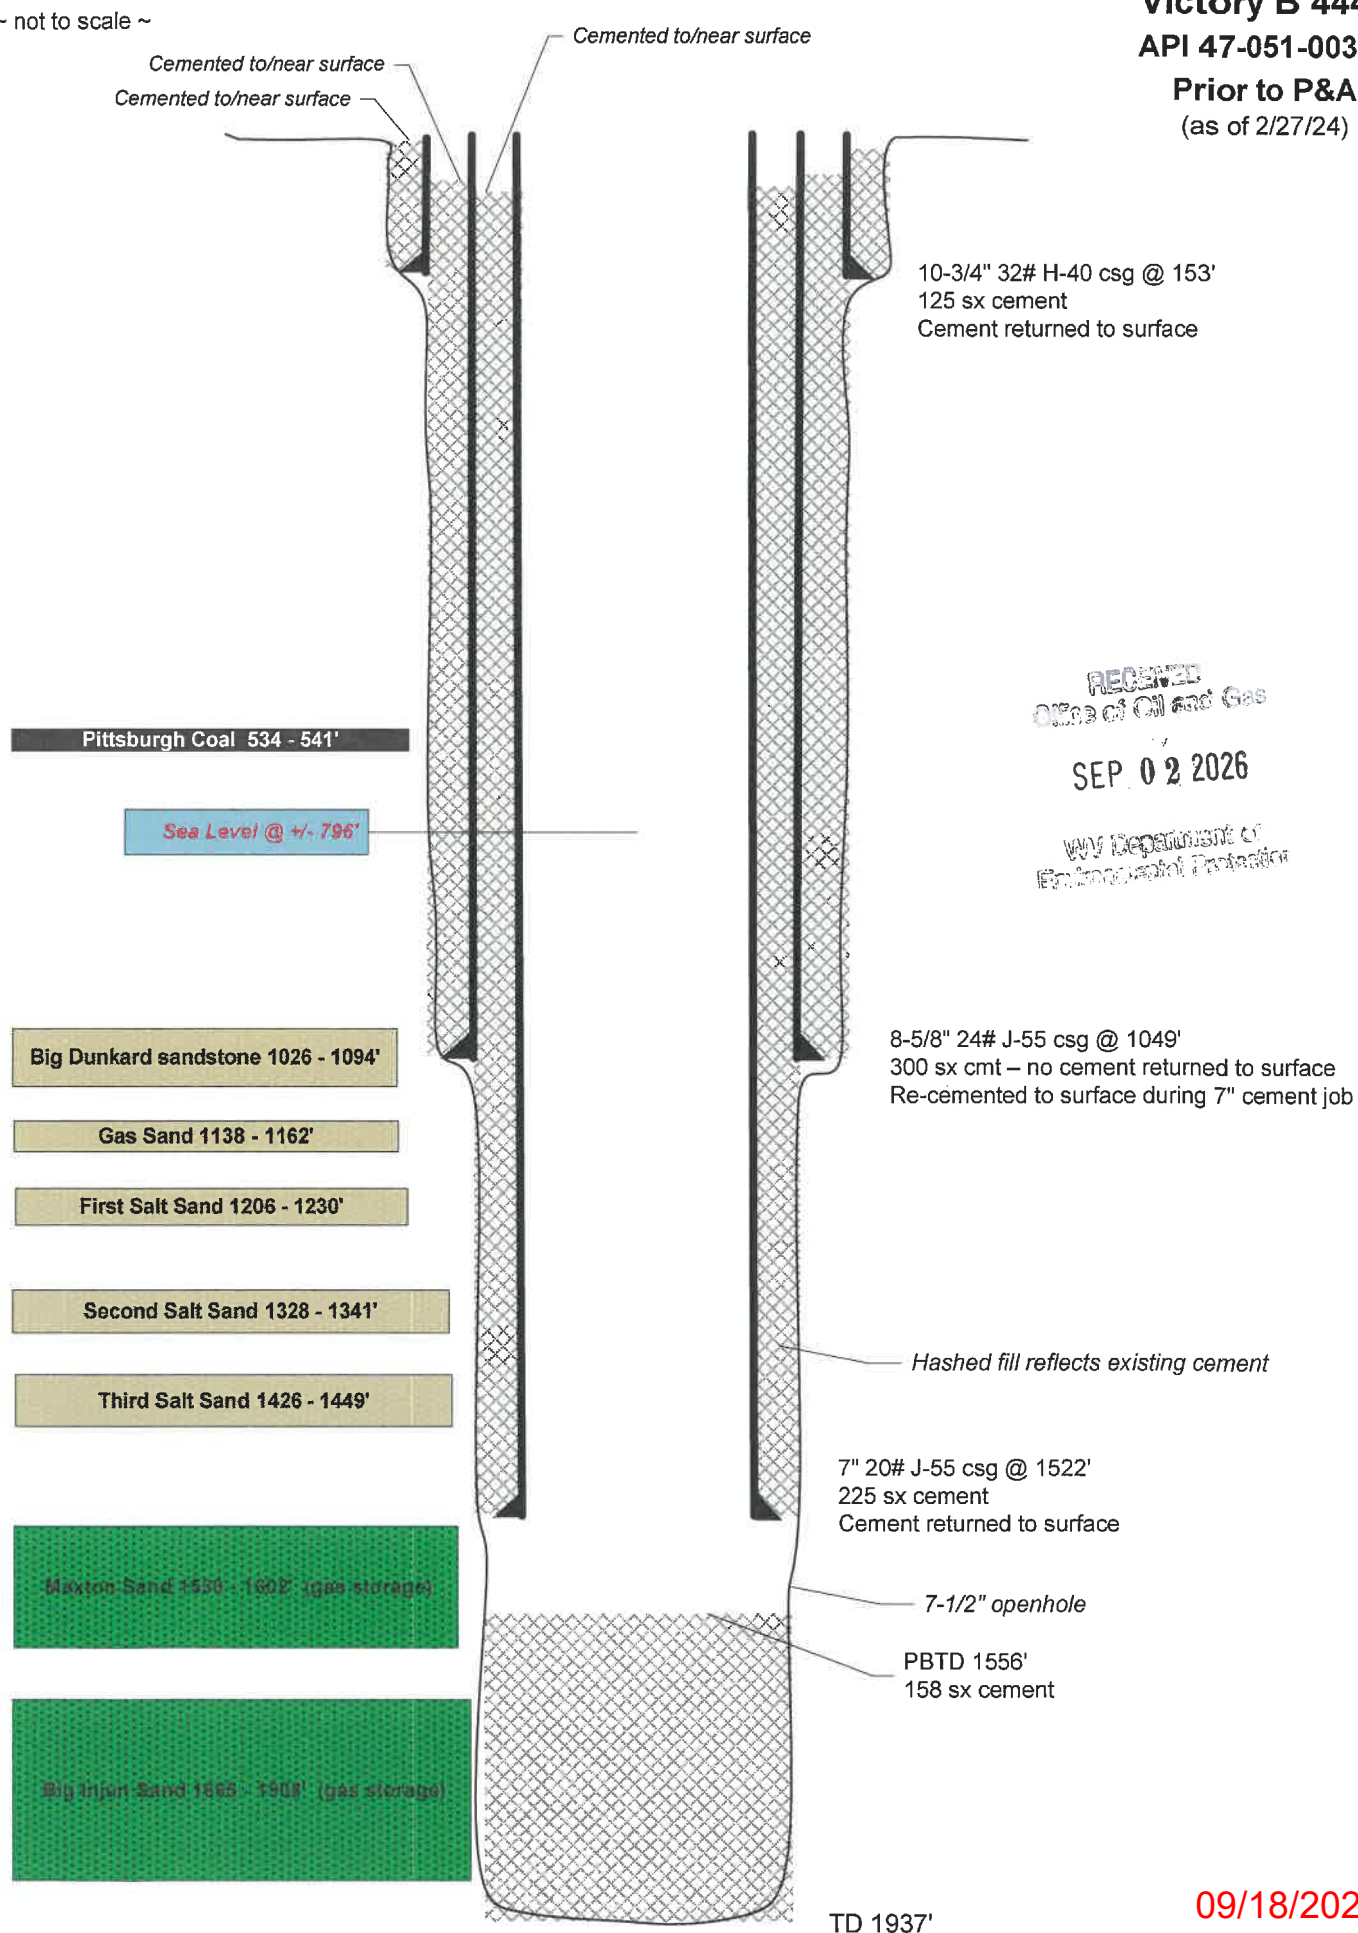

RECEIVED
Office of Oil and Gas

SEP 02 2026

WV Department of
Environmental Protection

09/18/2026