

STATE OF WEST VIRGINIA
DEPARTMENT OF ENVIRONMENTAL PROTECTION
OFFICE OF OIL AND GAS

AFFIDAVIT OF PLUGGING AND FILLING WELL

AFFIDAVIT SHOULD BE IN TRIPLICATE, one copy mailed to the Department, one copy to be retained by the Well Operator and the third copy (and extra copies if required) should be mailed to each coal operator at their respective addresses.

Farm name: Clouston, James Operator Well No.: Victory B 4591

LOCATION: Elevation: 1429' Quadrangle: Cameron
District: Liberty County: Marshall
Latitude: 95 Feet South of 39 Deg. 47 Min. 30 Sec. JUN 18 2026
Longitude: 6975 Feet West of 80 Deg. 32 Min. 30 Sec. WV Department of Environmental Protection

Well Type: OIL _____ GAS X

Company Columbia Gas Transmission, LLC Coal Operator Consol RCPC, LLC
1700 MacCorkle Avenue S.E., P.O. Box 1273 or Owner 275 Technology Drive, Suite 101
Charleston, WV 25325 Canonsburg, PA 15317
Agent Brad Nelson, Storage Engineer Coal Operator _____
Permit Issued Date 4/13/2026 or Owner _____

Pennsylvania
STATE OF WEST VIRGINIA
County of Washington ss:

AFFIDAVIT

Brad Nelson and Garrett Miller being first duly sworn according to law depose and say that they are experienced in the work of plugging and filling oil and gas wells and were employed by the above named well operator, and participated in the work of plugging and filling the above well say that said work was commenced on the 11th day of May, 2026, and the well was plugged and filled in the following manner:

TYPE	FROM	TO	PIPE REMOVED	LEFT
Class A Cement	0'	191'	7", 8-5/8"	10-3/4"
Class A Cement	191'	380'	7", 8-5/8"	N/A
Class A Cement	380'	390'	7"	8-5/8"
Class A Cement	390'	1314'	N/A	7", 8-5/8"
Class A Cement	1314'	2050'	N/A	7"
Cast Iron Bridge Plug (CIBP)	2050'	2055'	N/A	7"
Class A Cement	2055'	2198'	N/A	7"

See
Additional
Plugging
Data

Description of monument: 6" diameter pipe, 3' above GL, API affixed and that the work of plugging and filling said well was completed on the 1st day of June, 2026.

And further deponents saith not.

Sworn and subscribe before me this 9th day of June, 2026

My commission expires: 11/18/2027

Notary Public

Commonwealth of Pennsylvania - Notary Seal
EMILY KALE LEACH, Notary Public
Washington County
My Commission Expires November 18, 2027
Commission Number 1359854

Affidavit reviewed by the Office of Oil and Gas: Strader Gower Title: Oil & Gas Inspector
06/16/2026

06/26/2026

Victory B 4591 Additional Plugging Data (API # 47-051-00398-00-00)

[illegible]

06/26/2026


~ not to scale ~

Victory B 4591

API 47-051-00398

Post P&A

(as of 6/5/2026)

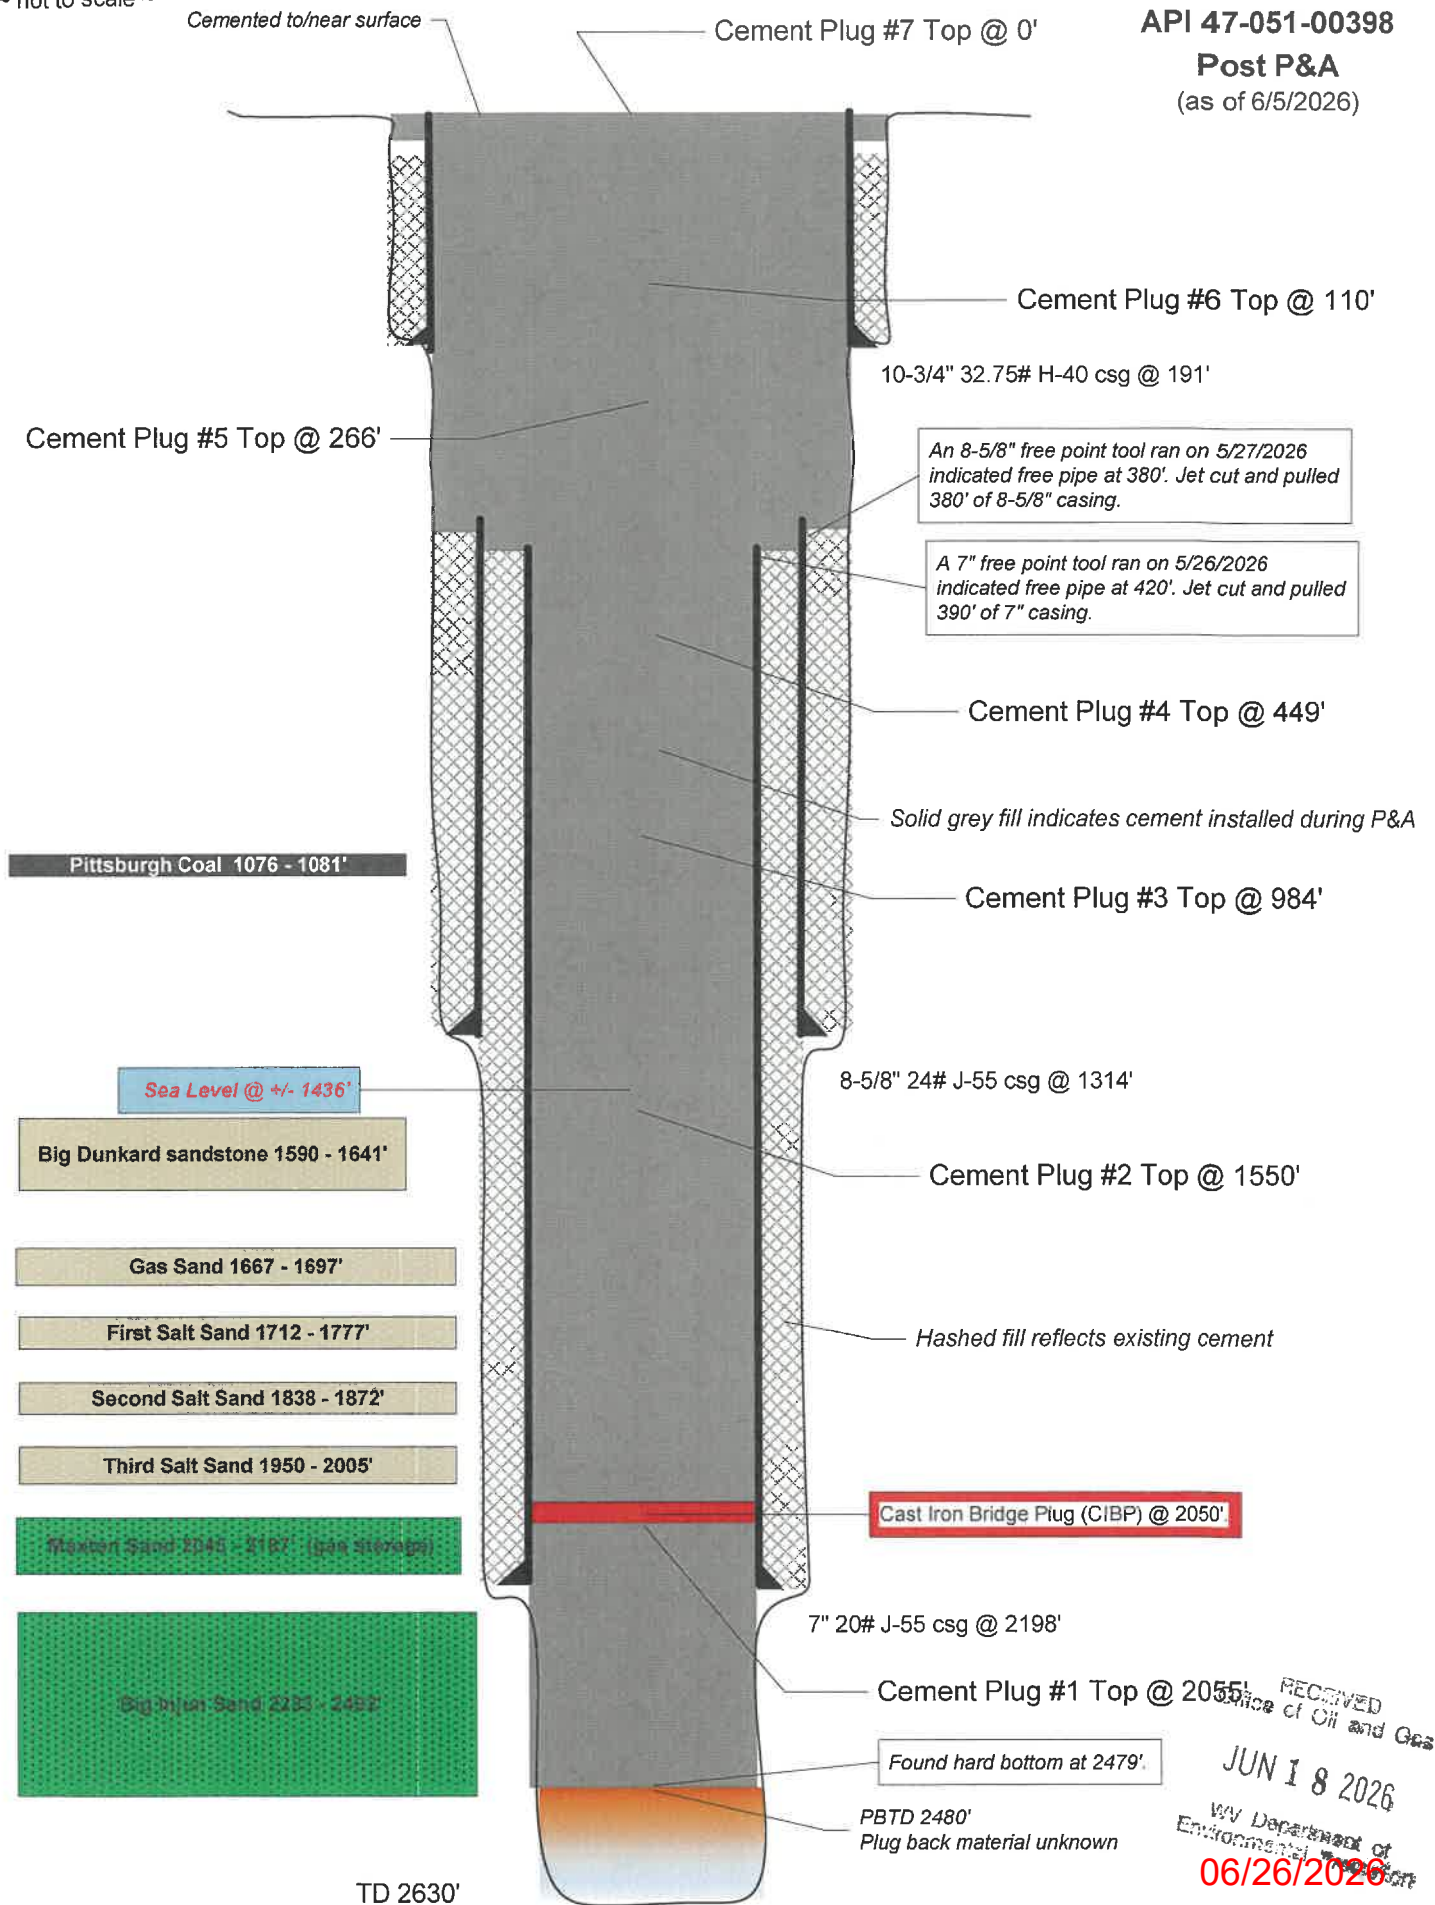

RECEIVED
Office of Oil and Gas
JUN 18 2026
WV Department of
Environmental Protection
06/26/2026


~ not to scale ~

Victory B 4591

API 47-051-00398

Prior to P&A

(as of 4/14/24)

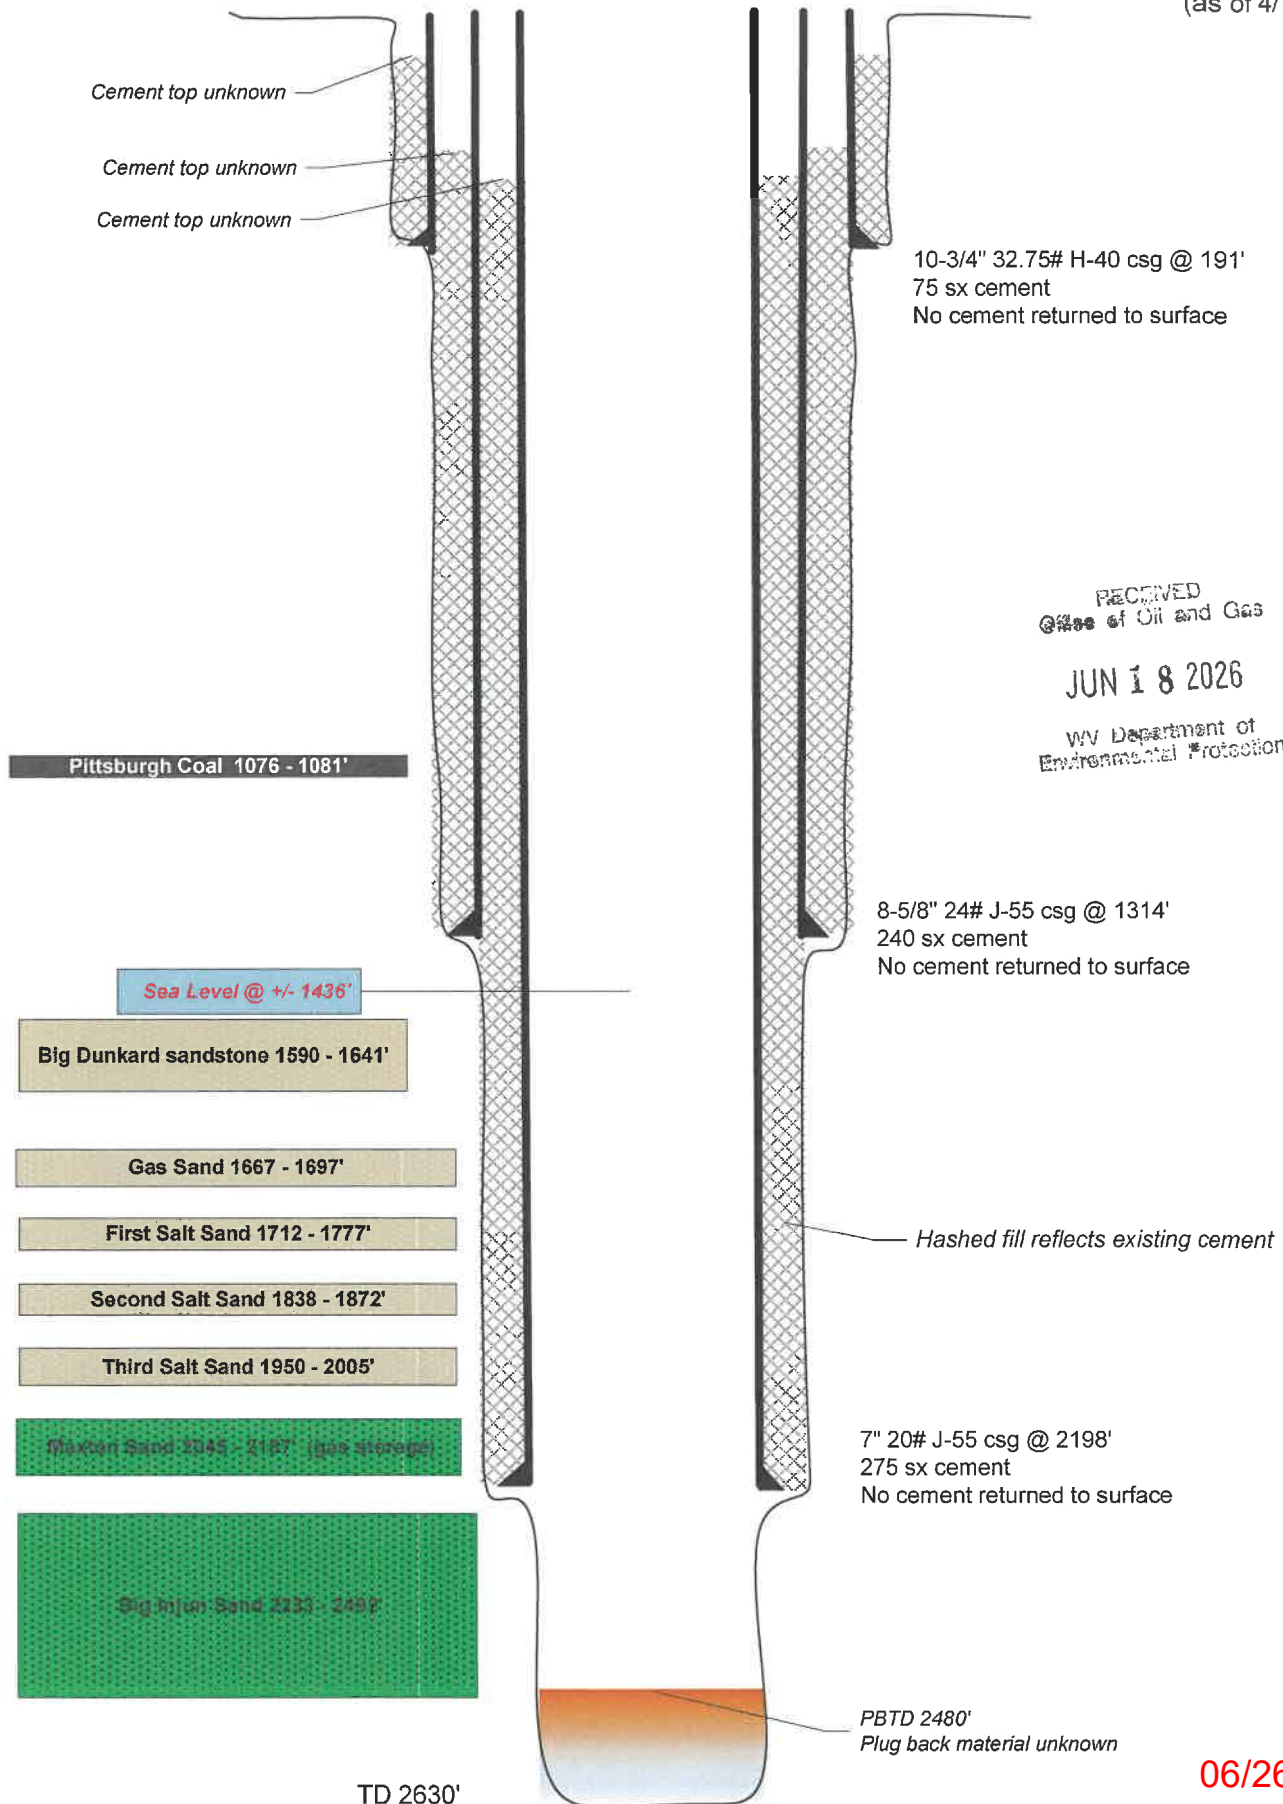

06/26/2026