


0 1 2 3 LATITUDE 39° 50'

394730

-1  
-2  
-3 LONGITUDE 80° 35'

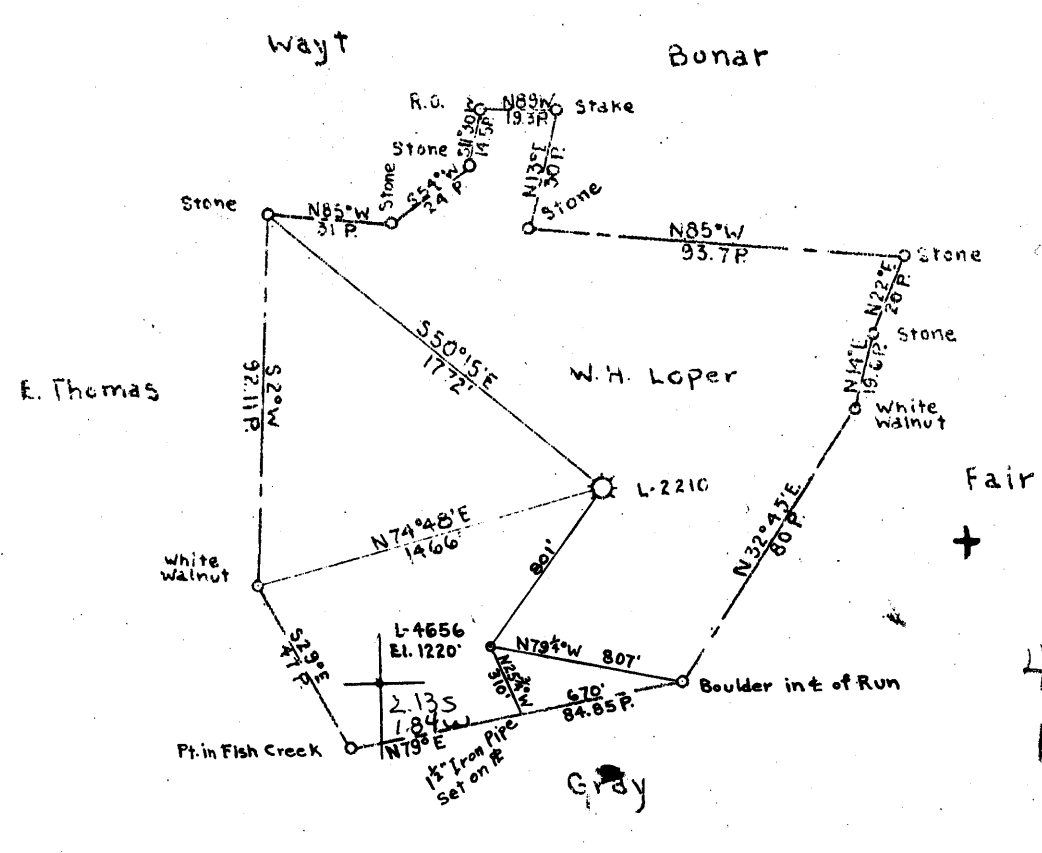

4.835 ✓  
1.78W  
1.80W

COAL OWNED BY M.A. Hanna Coal Co.

NEW LOCATION...   
 DRILL DEEPER...   
 ABANDONMENT...

025-28

COMPANY The Manufacturers Light & Heat Co.  
 ADDRESS 800 Union Trust Bldg., Pittsburgh 19, Pa.  
 FARM ~~W. Walton~~ M. WALTON  
 TRACT \_\_\_\_\_ ACRES 104 LEASE NO. L-4736  
 WELL (FARM) NO. 2 SERIAL NO. L-4656  
 ELEVATION (SPIRIT LEVEL) 1220'  
 QUADRANGLE Cameron SC  
 COUNTY Marshall DISTRICT Liberty  
 ENGINEER Robert M. Meill  
 ENGINEER'S REGISTRATION NO. 361-E (J.F.)  
 FILE NO. \_\_\_\_\_ DRAWING NO. Y-25-369  
 DATE April 1961 SCALE 1" = 800'

**STATE OF WEST VIRGINIA**  
 DEPARTMENT OF MINES  
 OIL AND GAS DIVISION  
 CHARLESTON

**WELL LOCATION MAP**

FILE NO. MARS-417

+ DENOTES LOCATION OF WELL ON UNITED STATES TOPOGRAPHIC MAPS, SCALE 1 TO 62,500. LATITUDE AND LONGITUDE LINES BEING REPRESENTED BY BORDER LINES AS SHOWN.

- DENOTES ONE INCH SPACES ON BORDER LINE OF ORIGINAL TRACING.

