


39°47'30"

LATITUDE 39 ° 50 ' 1

LONGITUDE 80 ° 35

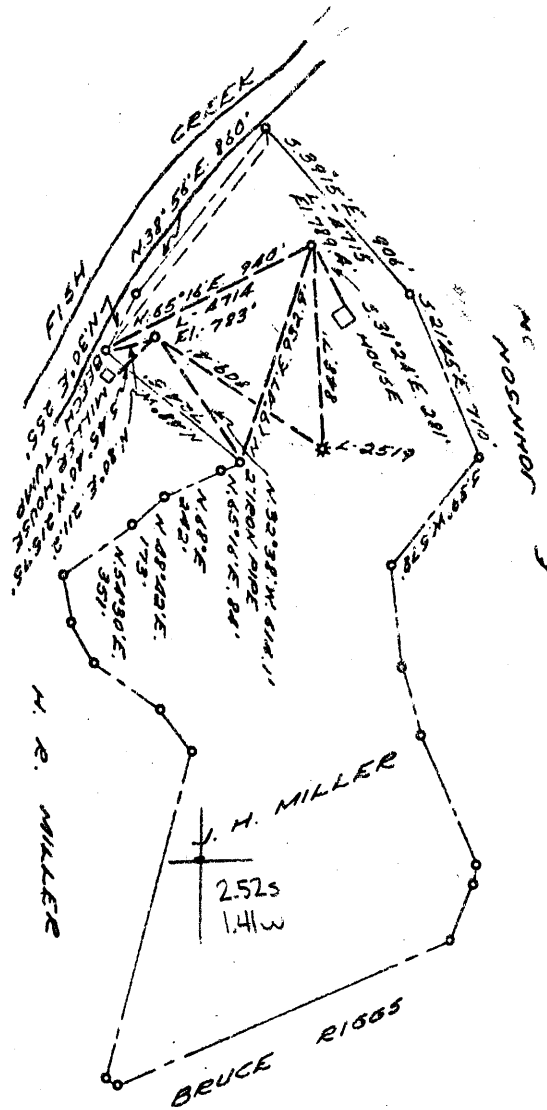

COAL OWNED BY _____

NEW LOCATION... FOR STORAGE

DRILL DEEPER...

ABANDONMENT...

0-25-28

COMPANY THE MANUFACTURERS LIGHT & HEAT
 ADDRESS 800 UNION TRUST BLDG. PGH. PA.
 FARM J. H. MILLER
 TRACT _____ ACRES 81 LEASE NO. 2296
 WELL (FARM) NO. 4 SERIAL NO. 4715
 ELEVATION (SPIRIT LEVEL) 789.4'
 QUADRANGLE CAMERON SC
 COUNTY MARSHALL DISTRICT LIBERTY
 ENGINEER Robert M. Heill
 ENGINEER'S REGISTRATION NO. 361-E. (J.F.)
 FILE NO. _____ DRAWING NO. Y-25-564
 DATE 11 JUNE 52 SCALE 1" = 800'

STATE OF WEST VIRGINIA
 DEPARTMENT OF MINES
 OIL AND GAS DIVISION
 CHARLESTON

WELL LOCATION MAP

FILE NO. MARS-465

+ DENOTES LOCATION OF WELL ON UNITED STATES TOPOGRAPHIC MAPS, SCALE 1 TO 62,500. LATITUDE AND LONGITUDE LINES BEING REPRESENTED BY BORDER LINES AS SHOWN.

— DENOTES ONE INCH SPACES ON BORDER LINE OF ORIGINAL TRACING.