


LATITUDE 40 0 00  
39°57'30"

LONGITUDE 80 0 30'

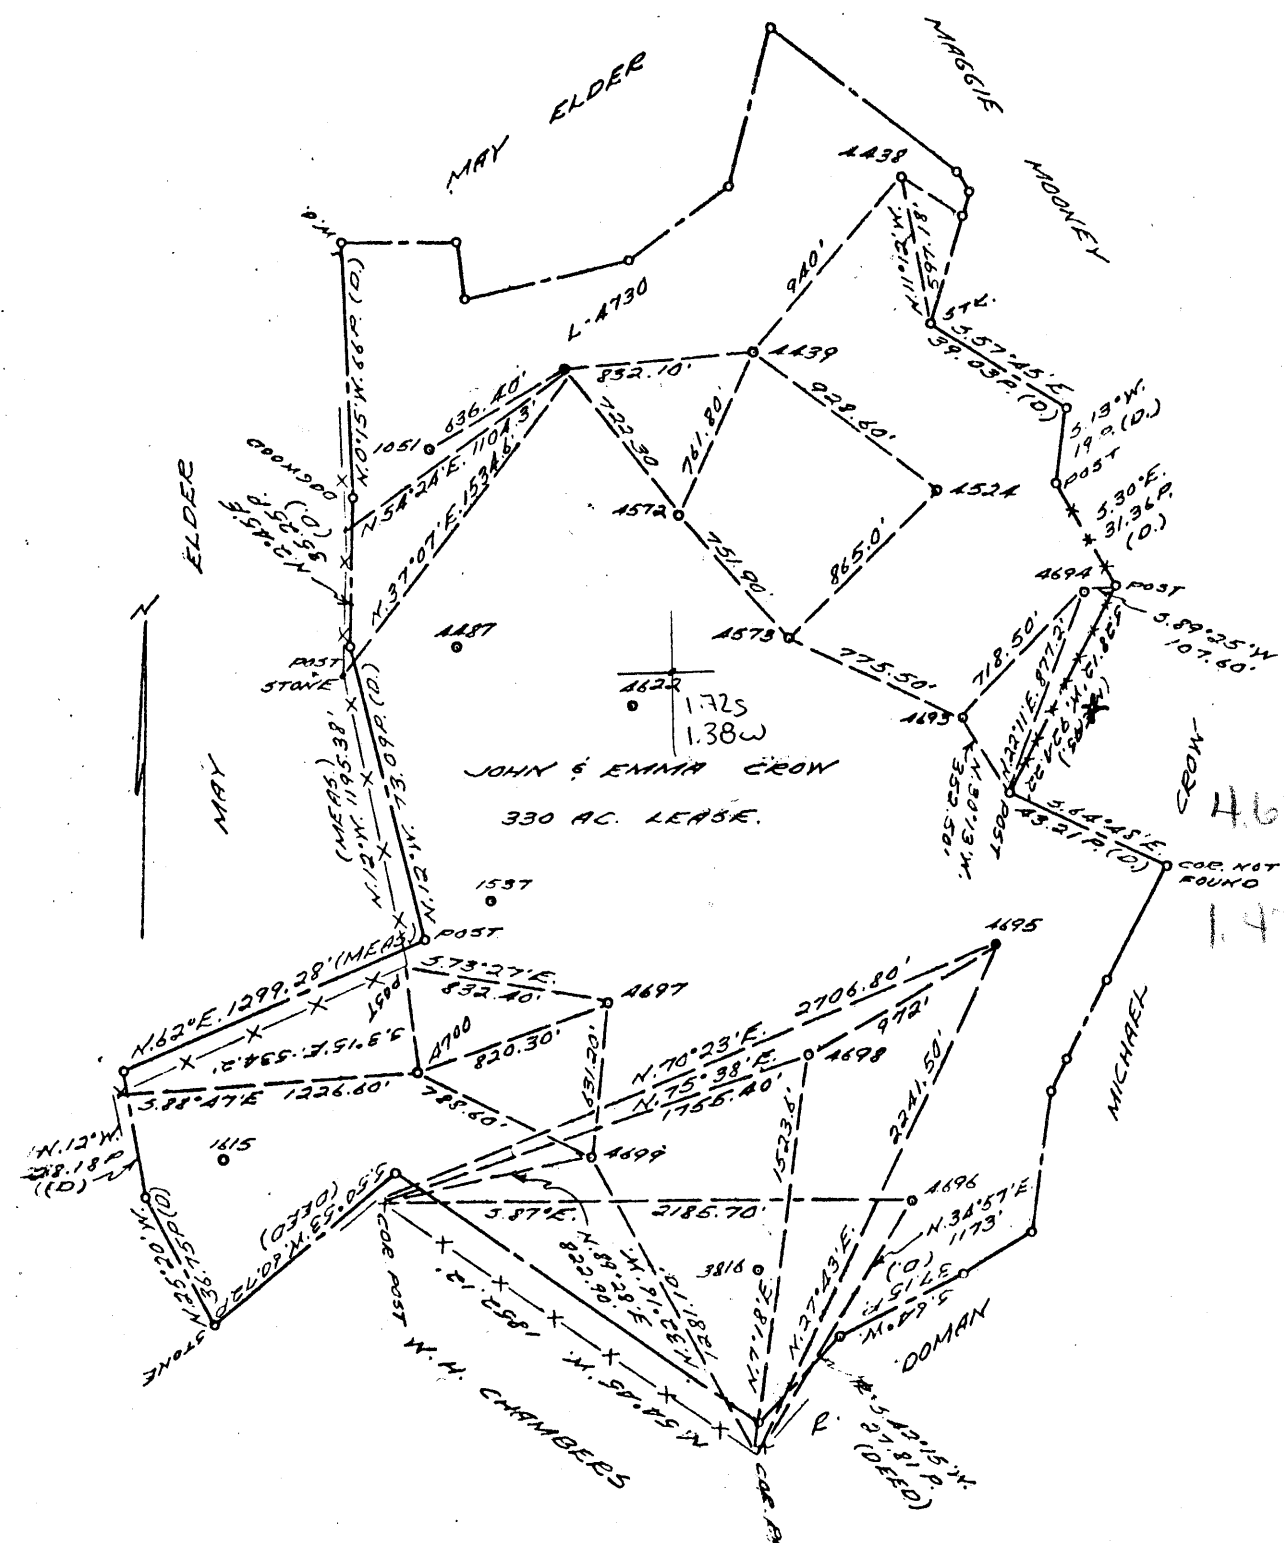

COAL OWNED BY \_\_\_\_\_

NEW LOCATION...  FOR STORAGE

DRILL DEEPER...

ABANDONMENT...

0-25-10

COMPANY THE MANUFACTURERS LIGHT & HEAT

ADDRESS 800 UNION TRUST BLDG, PGH. PA.

FARM JOHN AND EMMA CROW

TRACT \_\_\_\_\_ ACRES 330 LEASE No. 2900

WELL (FARM) No. 13 SERIAL No. 4695

ELEVATION (SPIRIT LEVEL) 1148.55'

QUADRANGLE CAMERON NE

COUNTY MARSHALL DISTRICT WEBSTER

ENGINEER John A. London (D.G.)

ENGINEER'S REGISTRATION No. 12710

FILE No. \_\_\_\_\_ DRAWING No. Y-25-577

DATE 20 JUNE, 62 SCALE 1" = 800'

STATE OF WEST VIRGINIA  
DEPARTMENT OF MINES  
OIL AND GAS DIVISION  
CHARLESTON

WELL LOCATION MAP

FILE No. MARS-472

+ DENOTES LOCATION OF WELL ON UNITED STATES TOPOGRAPHIC MAPS, SCALE 1 TO 62,500, LATITUDE AND LONGITUDE LINES BEING REPRESENTED BY BORDER LINES AS SHOWN.

- DENOTES ONE INCH SPACES ON BORDER LINE OF ORIGINAL TRACING.