


LATITUDE 39° 47' 30"

A

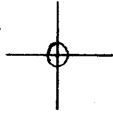

03° 43' 08" LONGITUDE

7.5 OGIS topo location

7.5' 10C 1.15S ✓ 15' 10C _____
 1.77W (calc.) _____

Company _____

Farm _____

Quad GLEN EASTON 7 1/2'


County WARSHALL

District MEADE

Plan. 1080 ± (TOPO)

WELL LOCATION MAP

File No. 051-620

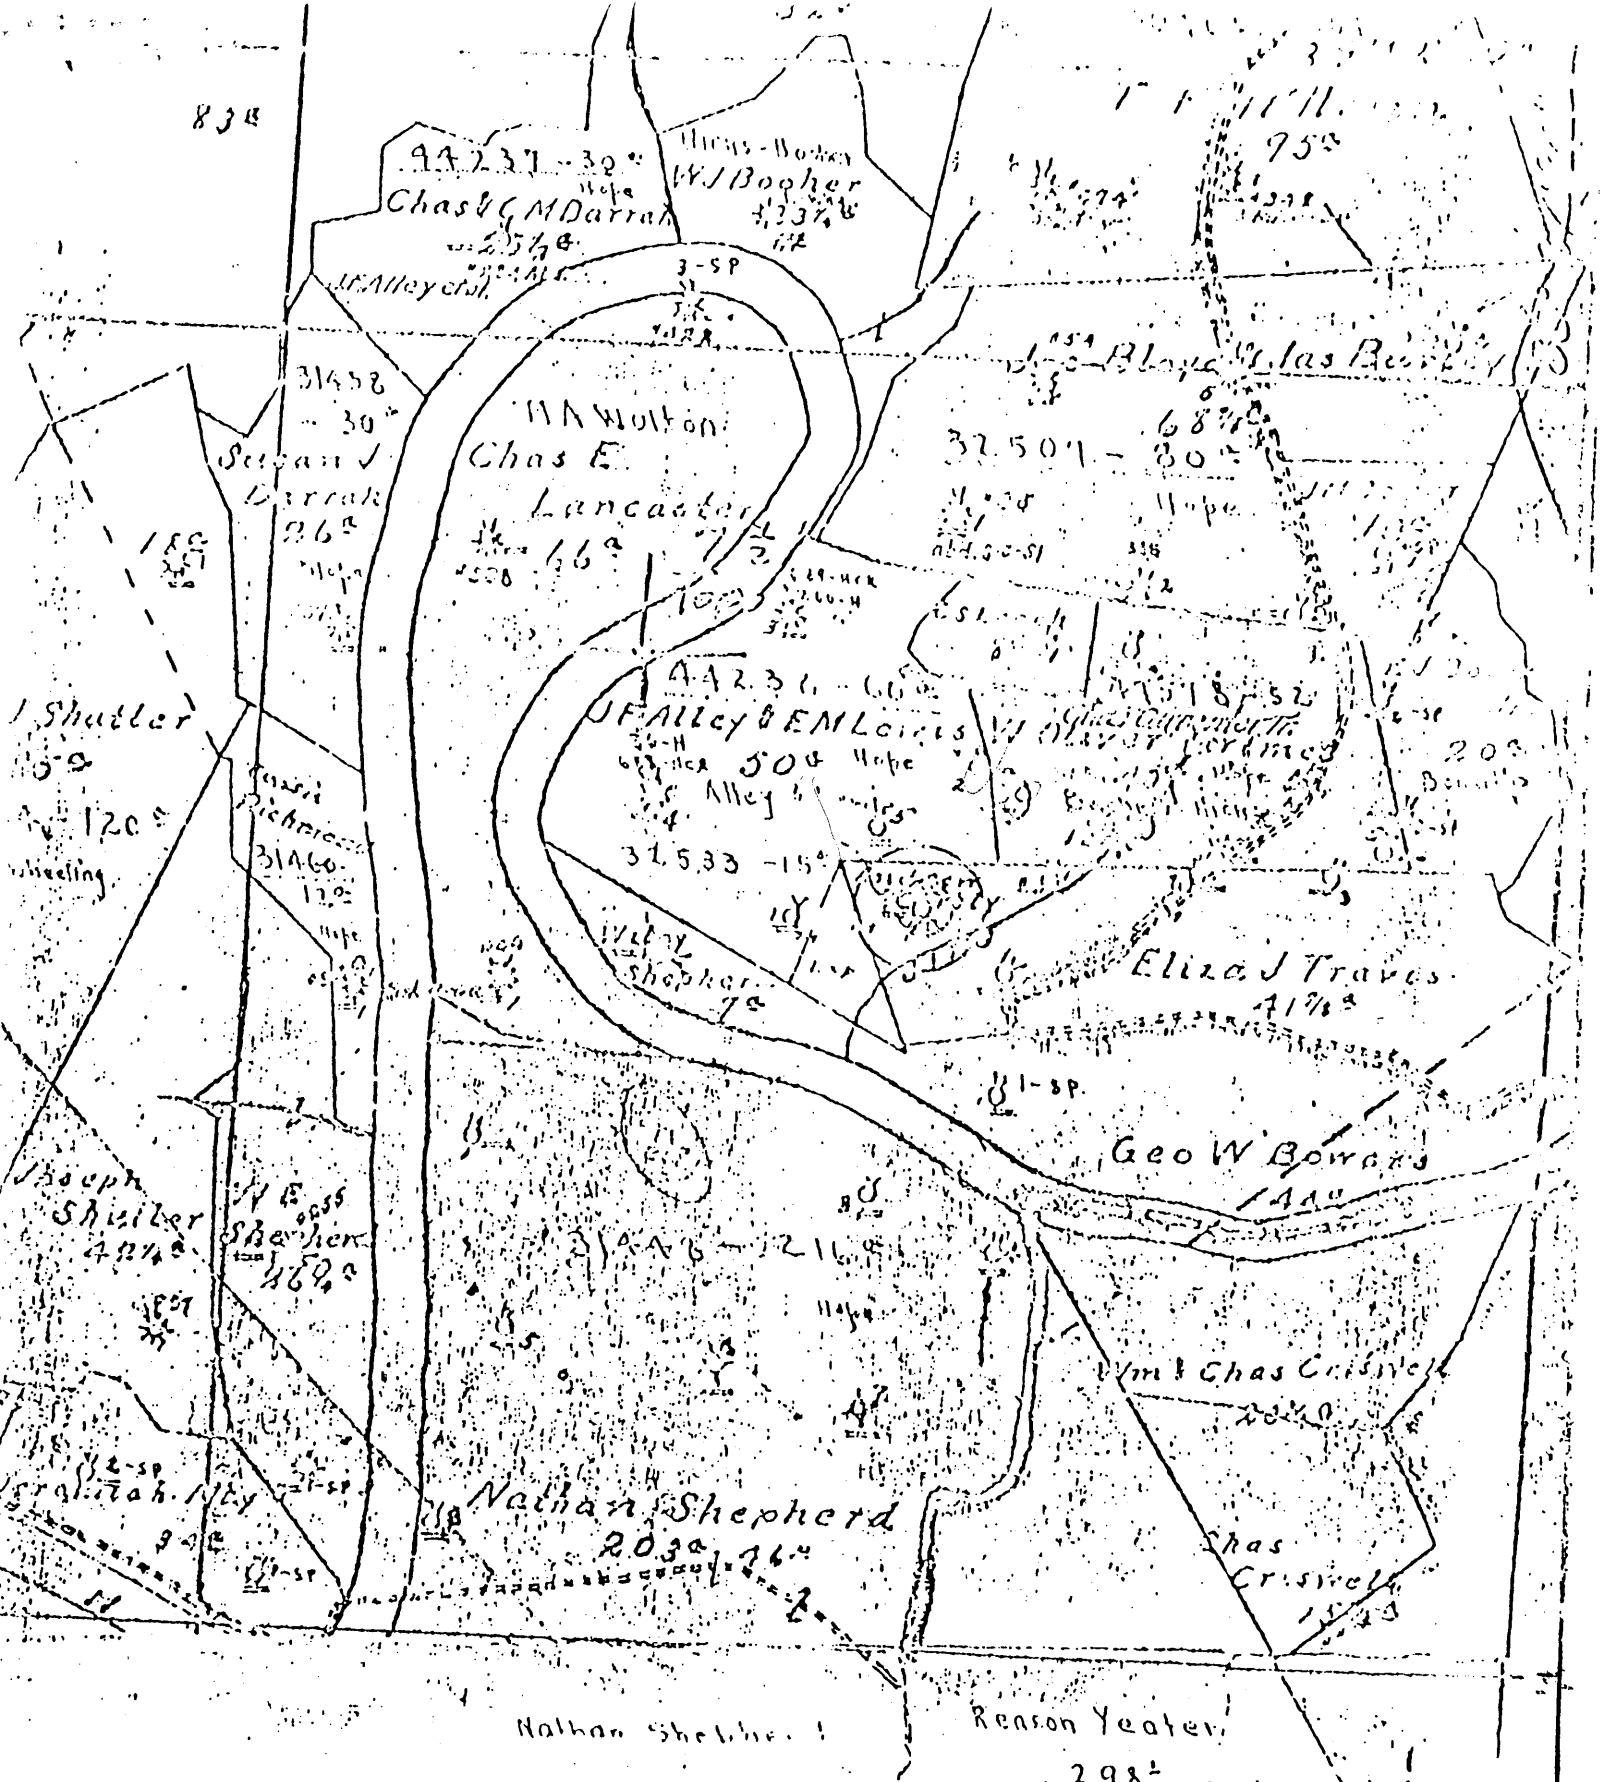

(+) DENOTES LOCATION OF WELL ON UNITED STATES TOPOGRAPHIC MAPS
 FORM IV-6
 (10-70)
 103 N 23 211



DATE Jan 5 1972
 OPERATOR'S WELL NO. 1272
 API WELL NO. 47-051-0620
 STATE COUNTY PERMIT

STATE OF WEST VIRGINIA
 DEPARTMENT OF MINES
 OIL AND GAS DIVISION

WELL TYPE: OIL GAS LIQUID INJECTION WASTE DISPOSAL
 (IF "GAS", PRODUCTION STORAGE DEEP CHALLOW
 LOCATION: ELEVATION _____ WATER SHED Fish Creek
 DISTRICT Meade COUNTY Marshall
 QUADRANGLE Glen Easton 7 1/2
 SURFACE OWNER _____ ACREAGE _____
 OIL & GAS ROYALTY OWNER _____ LEASE NO. _____ LEASE ACREAGE _____
 PROPOSED WORK: DRILL CONVERT DRILL DEEPER REDRILL FRACTURE OR STIMULATE PLUG OFF OLD FORMATION PERFORATE NEW FORMATION OTHER PHYSICAL CHANGE IN WELL (SPECIFY) _____
 PLUS AND ABANDON CLEAN OUT AND REPLUG
 TARGET FORMATION _____ ESTIMATED DEPTH _____
 WELL OPERATOR Conzoll Company DESIGNATED AGENT James A. Crown
 ADDRESS P. O. Box 1588 ADDRESS P. O. Box 1588
Parkersburg, WV 26101 Parkersburg, WV 26101

Harlow (Serial - 2)

56-620

NO. 1

SOUTH PENN OIL COMPANY—COMPLETION

SERIAL NO. _____ FARM Anderson Cobly WELL NO. 2
 ELEVATION _____ N. 23 S. _____ E. _____ W. 2
 LEASE NO. 32533 ACRES 1.5
 WATERS OF _____
 DISTRICT Mende COUNTY Marshall STATE W. Va.
 DRILLING COMMENCED 6/27/02 COMPLETED 9/26/02 DEPTH 2732

BANDS	TOP	BOTTOM	ELEV. TOP	CASING
PERM. COAL XXXXXX	709	716		10" 1281'
Big Injun	1832	2031		8" 1100'
Stray Sand	2672	2679		6" 1924'
Gordon Sand	2703	2731		5" 2291'
				PACKERS AND DEPTH SET

INITIAL PROD. 50 Bbls SAND Gordon DEPTH _____
 GAS TEST _____
 SHOT 9/26/02 QUARTS 40 " Gordon " 2705
 REMARKS _____
 REPORTED BY G. H. KING NINEVEN DISTRICT