

LATITUDE 39° 45' 00"

9

LONGITUDE 85° 42' 30"



7.5 OGIS topo location

7.5' loc 1.375 ✓ 15' loc _____
 0.16 w (calc.) _____

Company _____

Farm _____

Quad WILEYVILLE 7 1/2'

County MARSHALL


District MEADE

WELL LOCATION MAP

File No. 051-1663

LATITUDE 39.50'

LONGITUDE 80.35'

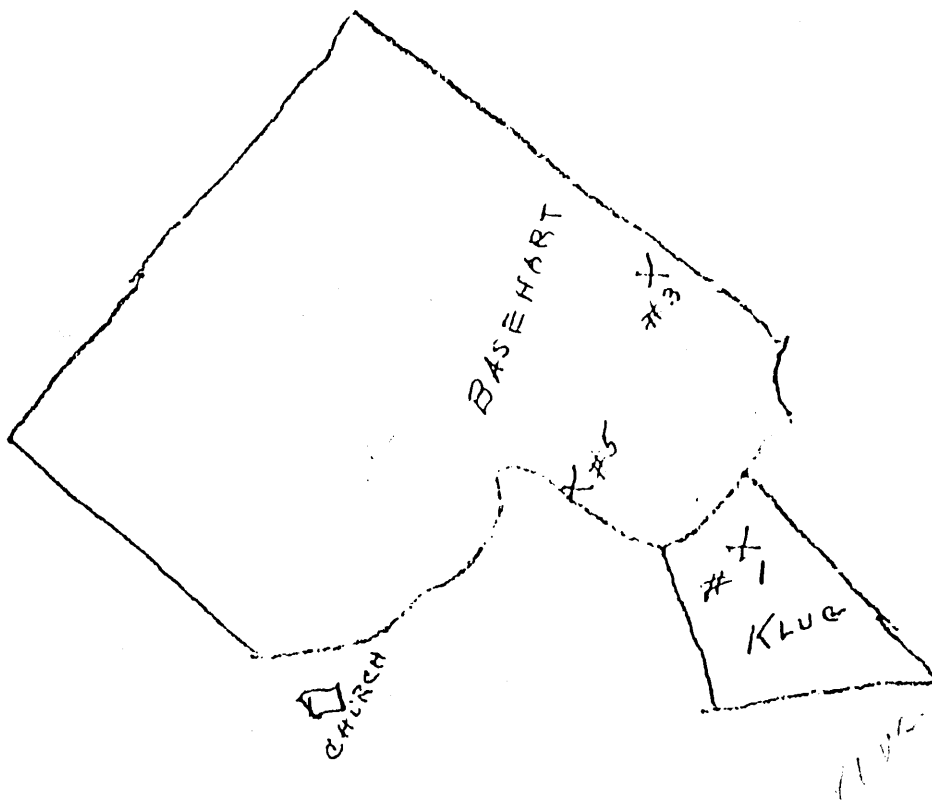

FILE NO. _____
 DRAWING NO. _____
 SCALE 1" = 660'
 MINIMUM DEGREE OF ACCURACY _____
 PROVEN SOURCE OF ELEVATION _____

I THE UNDERSIGNED, HEREBY CERTIFY THAT THIS PLAT IS CORRECT TO THE BEST OF MY KNOWLEDGE AND BELIEF AND SHOWS ALL THE INFORMATION REQUIRED BY LAW AND THE REGULATIONS ISSUED AND PRESCRIBED BY THE DEPARTMENT OF MINES.
 (SIGNED) _____
 R.P.E. _____ L.L.S. _____

PLACE SEAL HERE

+) DENOTES LOCATION OF WELL ON UNITED STATES TOPOGRAPHIC MAPS
 FORM IV-6
 8-78



DATE May 4, 1979
 OPERATOR'S WELL NO. #3
 API WELL NO. _____
47 - 051 - 0663
 STATE COUNTY PERMIT

STATE OF WEST VIRGINIA
 DEPARTMENT OF MINES

OIL AND GAS DIVISION

WELL TYPE: OIL GAS LIQUID INJECTION _____ WASTE DISPOSAL _____
 (IF "GAS", PRODUCTION _____ STORAGE _____ DEEP SHALLOW _____
 LOCATION: ELEVATION 1350 WATER SHED Whitstone
 DISTRICT Mude COUNTY Marshall
 QUADRANGLE Cameron
 SURFACE OWNER McGowan Footscapfel ACREAGE 10
 OIL & GAS ROYALTY OWNER Anna Klug Heine LEASE ACREAGE 10
 LEASE NO. _____
 PROPOSED WORK: DRILL _____ CONVERT _____ DRILL DEEPER _____ REDRILL _____ FRACTURE OR STIMULATE _____ PLUG OFF OLD FORMATION PERFORATE NEW FORMATION _____ OTHER PHYSICAL CHANGE IN WELL (SPECIFY) none
 PLUG AND ABANDON _____ CLEAN OUT AND REPLUG _____
 TARGET FORMATION _____ ESTIMATED DEPTH 3109
 WELL OPERATOR Paul J. Klug DESIGNATED AGENT Ernestine J. Klug
 ADDRESS Brooklyn, W. Va. 26055 ADDRESS Brooklyn, W. Va. 26055