


4705100746P

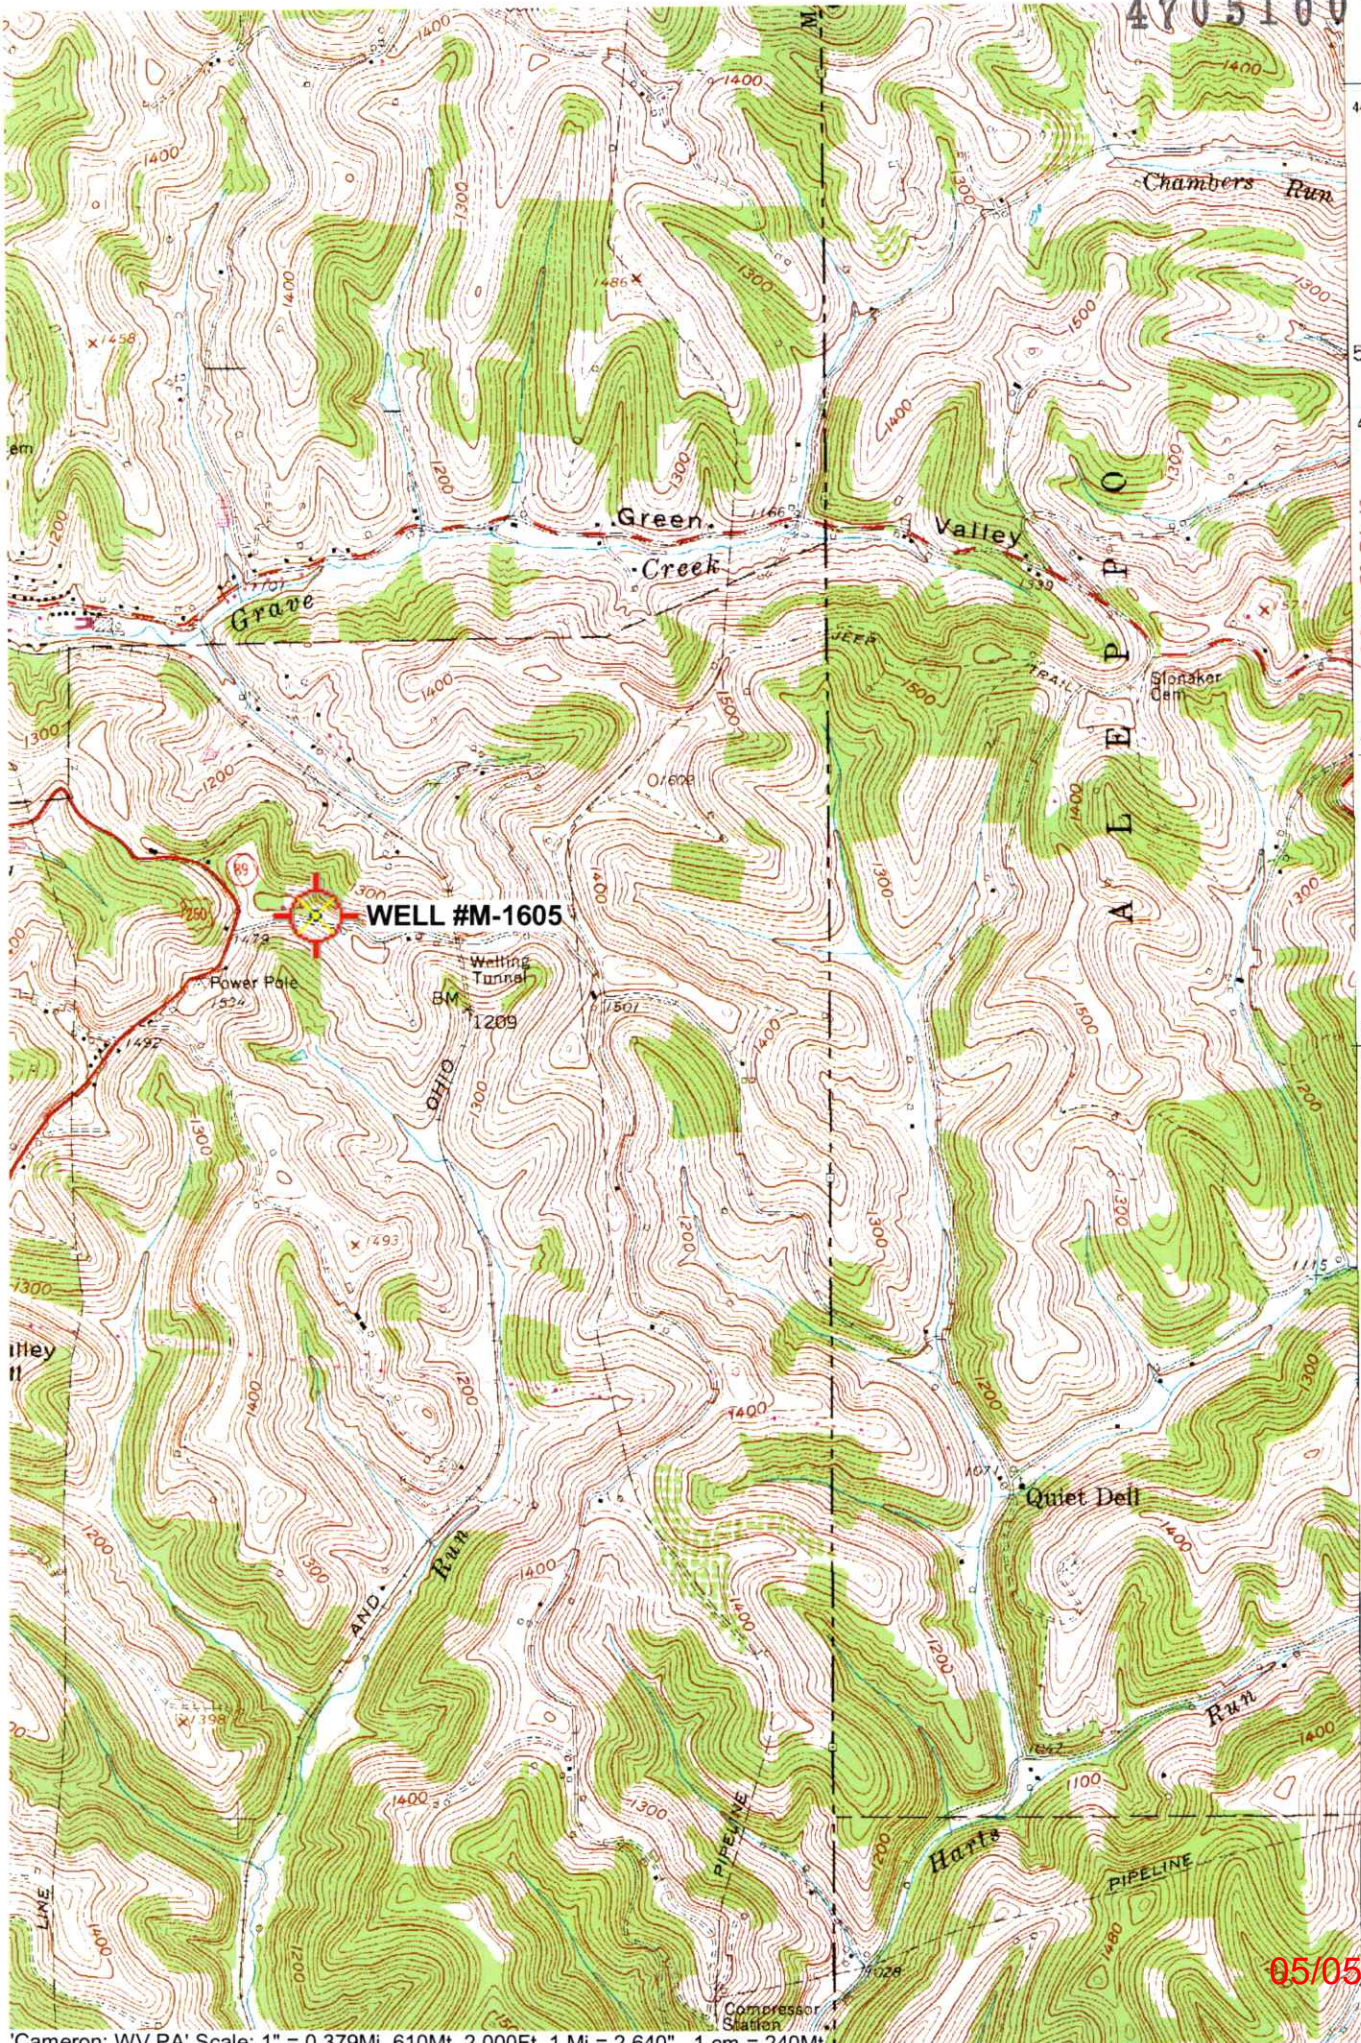

9.2 MI. TO P.A. 18  
(NEW FREEPORT)  
4963 IV SW

05/05/2023

WW-7  
8-30-06

4705100746 P



West Virginia Department of Environmental Protection  
Office of Oil and Gas

WELL LOCATION FORM: GPS

API: 47-051-00746 WELL NO.: M-1605

FARM NAME: W.A. DOWLER

RESPONSIBLE PARTY NAME: WEST VIRGINIA LAND RESOURCES INC.

COUNTY: MARSHALL DISTRICT: LIBERTY

QUADRANGLE: CAMERON WV, PA

SURFACE OWNER: RUTH E. BROWN (C/O RUTH E. RIGGLE)

ROYALTY OWNER: \_\_\_\_\_

UTM GPS NORTHING: 4,407,613 m

UTM GPS EASTING: 539,514 m GPS ELEVATION: 451 m (1479')

The Responsible Party named above has chosen to submit GPS coordinates in lieu of preparing a new well location plat for a plugging permit or assigned API number on the above well. The Office of Oil and Gas will not accept GPS coordinates that do not meet the following requirements:


- Datum: NAD 1983, Zone: 17 North, Coordinate Units: meters, Altitude: height above mean sea level (MSL) – meters.
- Accuracy to Datum – 3.05 meters
- Data Collection Method:

Survey grade GPS  : Post Processed Differential \_\_\_\_\_  
Real-Time Differential

Mapping Grade GPS \_\_\_\_\_ : Post Processed Differential \_\_\_\_\_  
Real-Time Differential \_\_\_\_\_

4. Letter size copy of the topography map showing the well location.

I the undersigned, hereby certify this data is correct to the best of my knowledge and belief and shows all the information required by law and the regulations issued and prescribed by the Office of Oil and Gas.

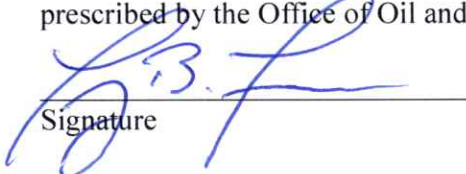  
Signature

Professional Surveyor  
Title

APRIL 14, 2023  
Date

RECEIVED  
Office Of Oil and Gas  
APR 27 2023  
WV Department of  
Environmental Protection

05/05/2023