


1) Attach a photo copy of the location of the well on a 7.5 minute Quadrangle with the corresponding Longitude and Latitude.  
 2) Designate the location of the well with the symbol(+).

+ 7.5" Tick

LITTLETON  
 WEST VIRGINIA  
 7.5 MINUTE SER  
 NE/4 LITTLETON

0.785  
 1.95 W

80° 30' 4100'

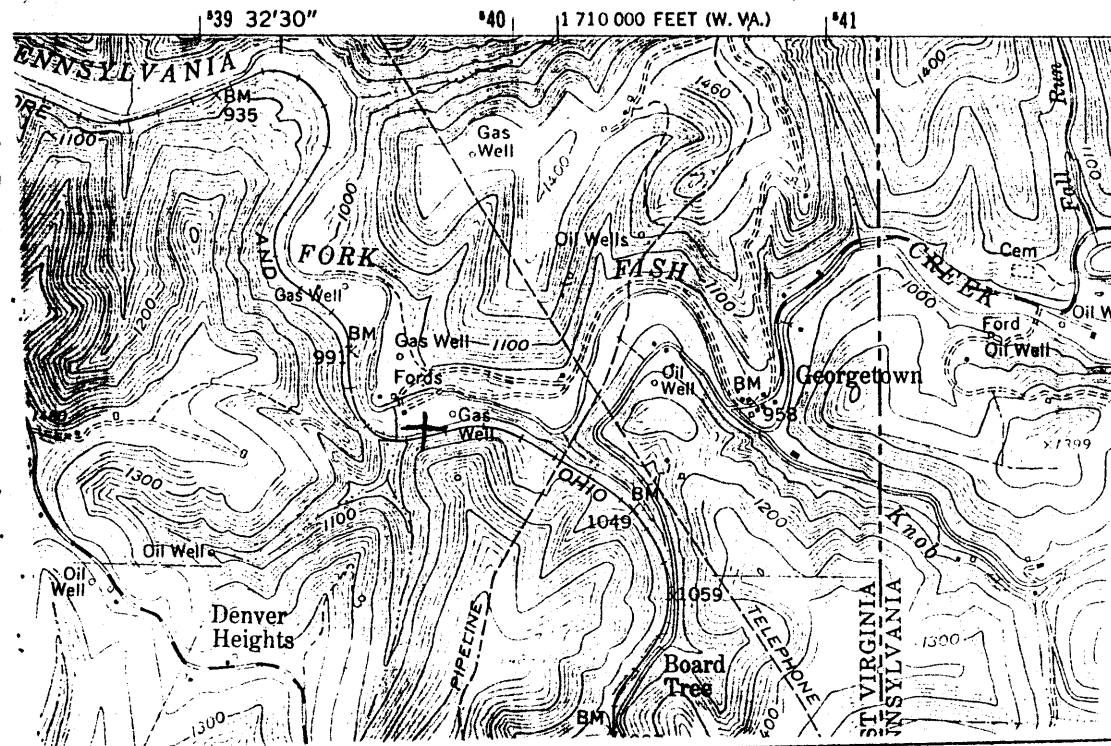

I, the undersigned, hereby certify that this plat is correct to the best of my knowledge and belief.

SIGNED [Signature]  
 TITLE VICE-PRESIDENT

DATE MARCH 15, 1993  
 OPERATORS WELL NO. 4393  
 API WELL NO. 051-0810-N

STATE OF WEST VIRGINIA  
 DEPARTMENT OF ENERGY  
 OIL AND GAS DIVISION

WELL TYPE: OIL    GAS X LIQUID INJECTION    WASTE DISPOSAL     
 (IE "GAS" PRODUCTION X STORAGE    DEEP    SHALLOW X)

LOCATION: ELEVATION 975 WATER SHED FISH CREEK  
 DISTRICT LIBERTY COUNTY MARSHALL  
 QUADRANGLE LITTLETON 15 NE

SURFACE OWNER I. HART ACREAGE     
 OIL & GAS ROYALTY OWNER    LEASE ACREAGE     
 LEASE NO.   

PRODUCING FORMATION GORDON TOTAL DEPTH 3087

WELL OPERATOR CHELSEA OIL & GAS CO. INC. DESIGNATED AGENT AL ANDERSON  
 ADDRESS BOX 1145 ADDRESS 901 WEST MAIN ST  
BRIDGEPORT WV 26330 BRIDGEPORT WV 26330

STATE OF WEST VIRGINIA  
DIVISION OF ENVIRONMENTAL PROTECTION  
SECTION OF OIL AND GAS

WELL REGISTER ASSIGNMENT

This API Number 47- 51-00810, issued to CHELSEA OIL & GAS, INC is evidence of permission to operate the well that is referenced at the location described on the attached plat, subject to the provisions of Chapters 22 and 22B of the West Virginia Code of 1931, as amended, and all rules and regulations promulgated thereunder. The name and telephone number of the Oil and Gas Inspector for this well is RANDAL MICK -  
304-986-3324.

Spills or emergency discharges must be reported to 1-800-654-3312.

Failure to abide by all statutory and regulatory provisions governing all duties and operations hereunder may result in suspension or revocation of your permits and in addition may result in civil and/or criminal penalties.

The enclosed WR-35 must be completed by you and returned to this office. In addition annual production reports must be submitted on this well and failure to do so may require you to plug the well.

Theodore M. Streit  
Chief

By:   
\_\_\_\_\_

Title: \_\_\_\_\_

Operator's Well No: 4393

Farm Name: HART, I.

API Well Number : 47- 51-00810 N

Date Issued : 01/27/94