


LATITUDE 39° 50' 00"


11,025'

LONGITUDE 80° 35' 00"

NORTH

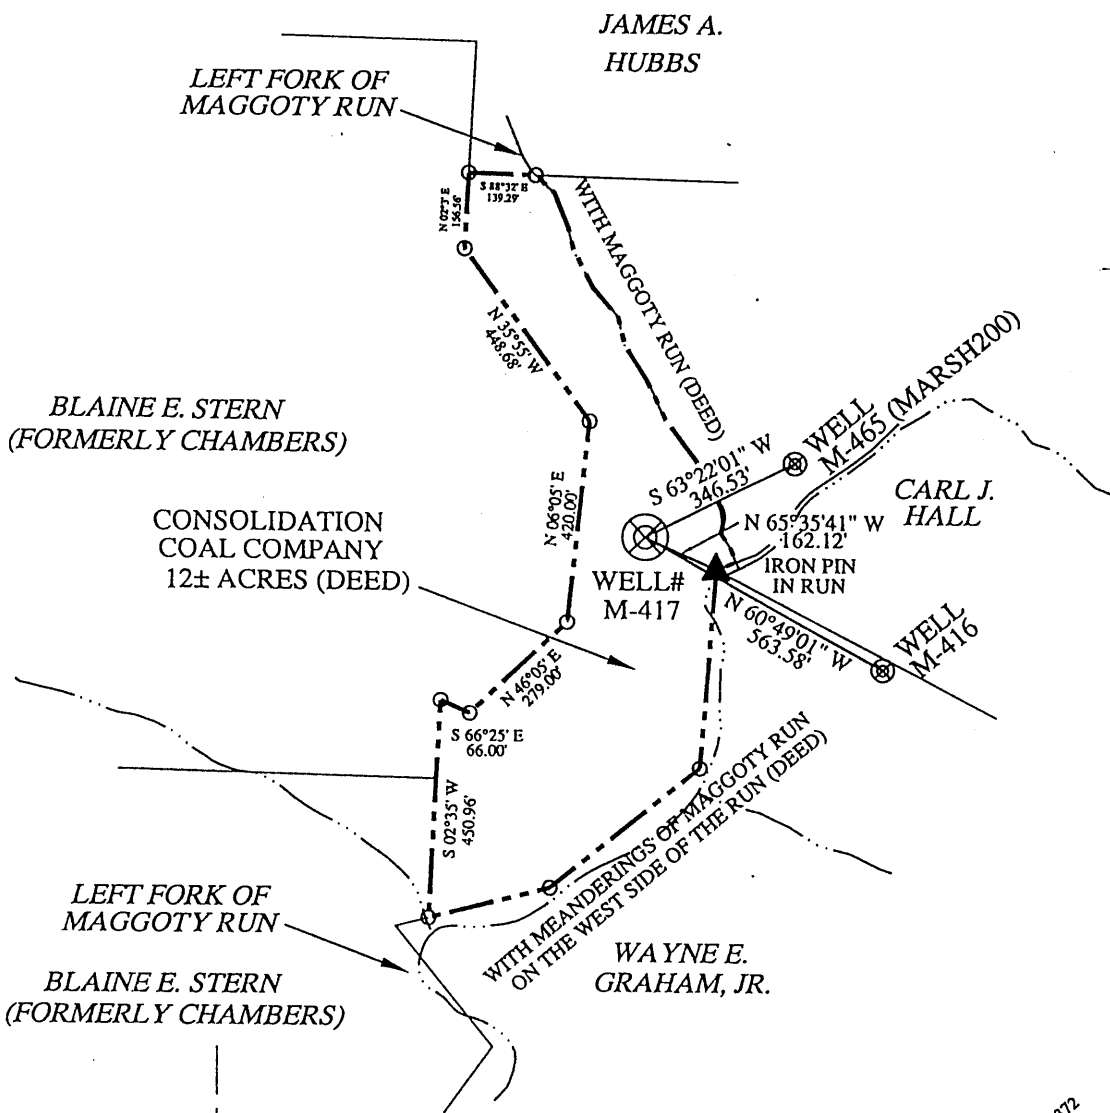

NOTE: DUE TO INSUFFICIENT METES AND BOUNDS DESCRIPTION FOR THE SUBJECT PROPERTY, ADJOINING PROPERTY DEED DESCRIPTIONS WERE PARTIALLY USED TO DESCRIBE THE PARCEL.

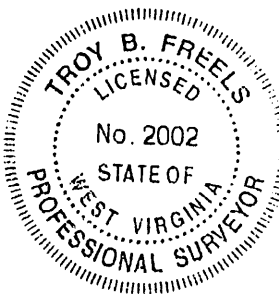

(+) DENOTES LOCATION OF WELL ON UNITED STATES TOPOGRAPHIC MAPS.

DATE MAY 5, 20 03
 OPERATORS WELL NO. M-417

API WELL NO. 47 - 51 - 0909P
 STATE COUNTY PERMIT
Was 051 70451

MINIMUM DEGREE OF ACCURACY: 1 / 2500 FILE NO.: M-420.DWG
 SCALE: 1" = 400'
 PROVEN SOURCE OF ELEVATION: COMPANY NETWORK TIED INTO U.S.G.S.

STATE OF WEST VIRGINIA
 DIVISION OF ENVIRONMENTAL PROTECTION
 OFFICE OF OIL AND GAS



WELL TYPE: OIL GAS LIQUID INJECTION WASTE DISPOSAL "GAS" PRODUCTION STORAGE DEEP SHALLOW

LOCATION: ELEVATION: 1051.45' WATERSHED: LEFT FORK OF MAGGOTY RUN

DISTRICT: LIBERTY COUNTY: MARSHALL QUADRANGLE: CAMERON, WV 7.5'

SURFACE OWNER: CONSOLIDATION COAL COMPANY ACREAGE: 12± ACRES (DEED)

ROYALTY OWNER: _____ LEASE ACREAGE: _____

PROPOSED WORK: _____ LEASE NO.: _____

DRILL: _____ CONVERT: _____ DRILL DEEPER: _____ REDRILL: _____ FRACTURE OR STIMULATE: _____ PLUG OFF OLD: _____

FORMATION: _____ PERFORATE NEW FORMATION: _____ PLUG AND ABANDON: CLEAN OUT AND REPLUG: _____ OTHER: _____

PHYSICAL CHANGE IN WELL (SPECIFY): _____ TARGET FORMATION: NONE

ESTIMATED DEPTH: _____

WELL OPERATOR: CONSOLIDATION COAL CO. / MCELROY COAL CO. DESIGNATED AGENT: ROGER E. DUCKWORTH 6/13/2003
1 BRIDGE ST. MONONGAH, WV 26554 1 BRIDGE ST. MONONGAH WV 26554

COUNTY NAME MARS
 PERMIT 0909P