

WW-7
8-30-06



West Virginia Department of Environmental Protection
Office of Oil and Gas

WELL LOCATION FORM: GPS

API: 47-051-00930 WELL NO.: MH20

FARM NAME: Consolidation Coal Company

RESPONSIBLE PARTY NAME: Erika Whetstone

COUNTY: Marshall DISTRICT: Liberty

QUADRANGLE: Littleton

SURFACE OWNER: Consolidation Coal Company

ROYALTY OWNER: Consolidation Coal Company

UTM GPS NORTHING: 4399912.79

UTM GPS EASTING: 539431.79 GPS ELEVATION: 939.38'

The Responsible Party named above has chosen to submit GPS coordinates in lieu of preparing a new well location plat for a plugging permit or assigned API number on the above well. The Office of Oil and Gas will not accept GPS coordinates that do not meet the following requirements:

- 1. Datum: NAD 1983, Zone: 17 North, Coordinate Units: meters, Altitude: height above mean sea level (MSL) – meters.
- 2. Accuracy to Datum – 3.05 meters
- 3. Data Collection Method:

Survey grade GPS : Post Processed Differential

Real-Time Differential

Mapping Grade GPS : Post Processed Differential

Real-Time Differential

- 4. **Letter size copy of the topography map showing the well location.**

I the undersigned, hereby certify this data is correct to the best of my knowledge and belief and shows all the information required by law and the regulations issued and prescribed by the Office of Oil and Gas.


Erika J. Whetstone
Signature

Permitting Supervisor, CNX Gas
Title

9/17/15
Date

Received
Office of Oil & Gas
OCT 01 2015

10/23/2015

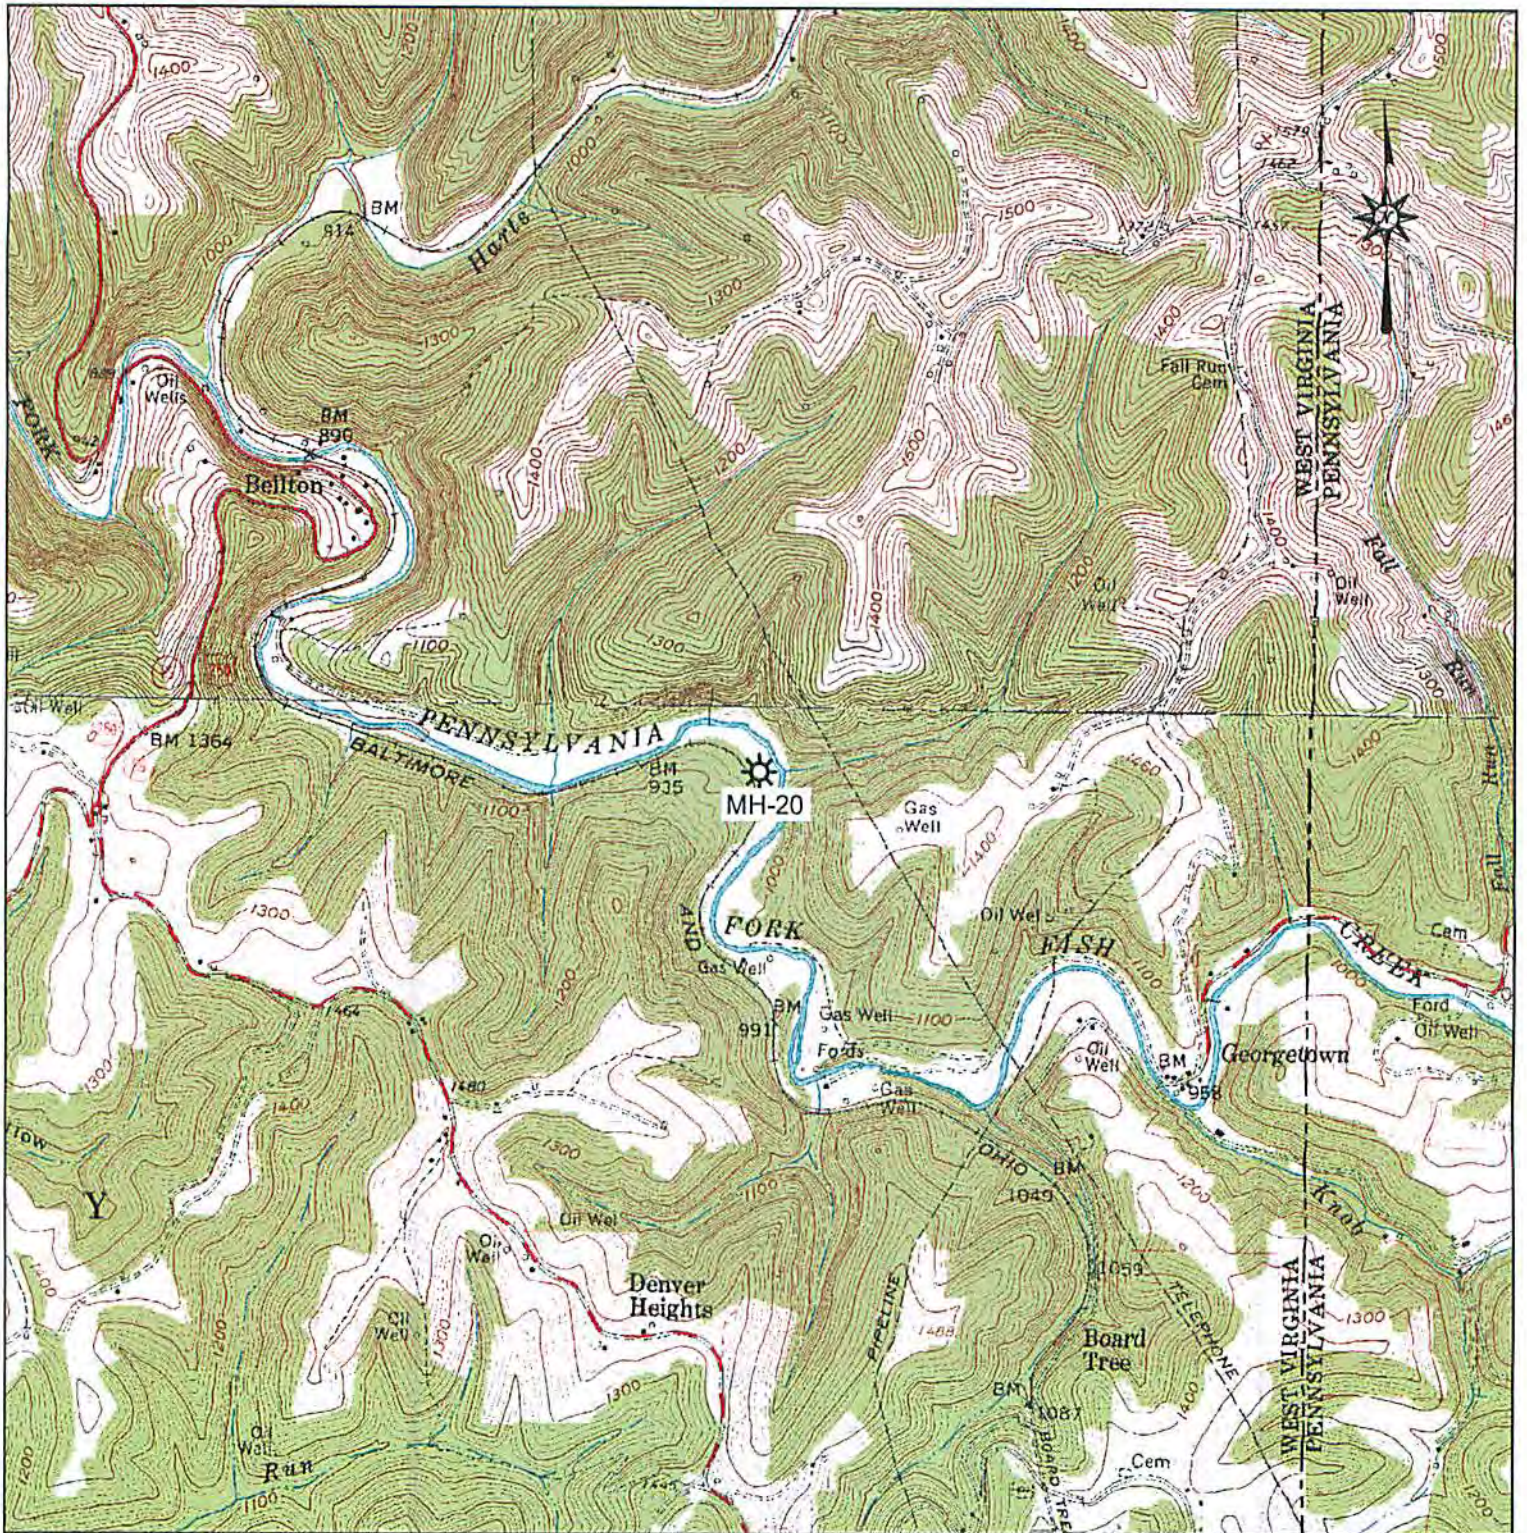


Blue Mountain Inc.
 10125 MASON DIXON HIGHWAY
 BURTON, WV 26562
 PHONE: (304) 662-6486

PREPARED FOR:
 CNX GAS COMPANY LLC
 200 EVERGREENE DRIVE
 WAYNESBURG, PA 15370

COORDINATES:
 UTM 17-NAD83: N:4399912.79
 (METERS) E:539431.79
 NAD27, WV NORTH: N:456289.667
 (FEET) E:1707595.977
 EL:939.38

Office of Oil & Gas
 Received
 OCT 01 2015
MH-20
LOCATION MAP
MARSHALL COUNTY
LIBERTY DISTRICT
WEST VIRGINIA

TOPO QUAD: LITTLETON, WV
 SCALE: 1" = 2000'
 DATE: SEPTEMBER 17, 2015