


## West Virginia Department of Environmental Protection Office of Oil and Gas

WELL LC	CATION FORM: GPS	•
<sub>API:</sub> 4705101027	WELL NO.:_	4N
FARM NAME: Donald Way		
RESPONSIBLE PARTY NAME:	CNX	
COUNTY: Marshall	DISTRICT: Wa	ashington
QUADRANGLE: Powhatar		
SURFACE OWNER: Donald	l Wayt	
ROYALTY OWNER: Donald		
UTM GPS NORTHING: 4411	061.50	
UTM GPS EASTING: 52096	8.02 GPS ELEVAT	TION: 1276.25
The Responsible Party named above preparing a new well location plat for above well. The Office of Oil and Othe following requirements:  1. Datum: NAD 1983, Zon height above mean sea leader to Datum - 3.4  3. Data Collection Method Survey grade GPS _ X : Post P	For a plugging permit or assigned of as will not accept GPS coordinates: 17 North, Coordinate Units: mevel (MSL) – meters.  105 meters  105 meters	API number on the tes that do not meet
Real-7	Γime Differential X	RECEIVED Office of Oil and Gas
Mapping Grade GPS: Pos	st Processed Differential	DEC 1 0 2020
	al-Time Differential	WV Department of Environmental Protection
4. Letter size copy of the I the undersigned, hereby certify this belief and shows all the information prescribed by the Office of Oil and	required by law and the regulation	knowledge and
Manufloor Signature	Project MANAGER Title	<u>λ-3-20</u> Date 03/19/2021

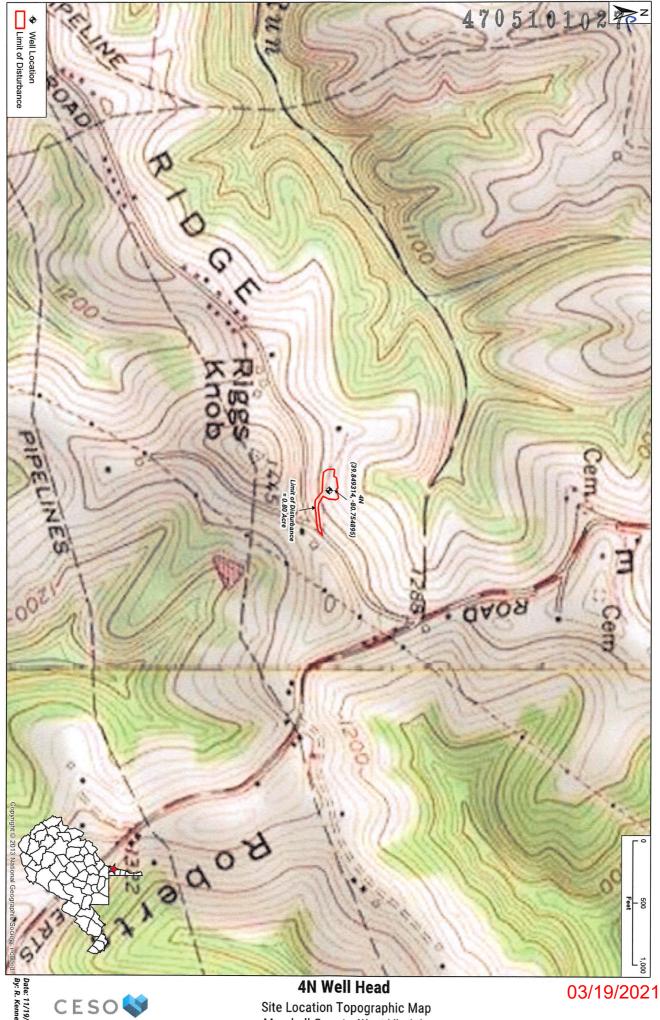

Site Location Topographic Map Marshall County. West Virginia