
STATE OF WEST VIRGINIA DEPARTMENT OF ENVIRONMENTAL PROTECTION OFFICE OF OIL AND GAS

AFFIDAVIT OF PLUGGING AND FILLING WELL

AFFIDAVIT SHOULD BE IN TRIPLICATE, one copy mailed to the Department, one copy to be retained by the Well Operator and the third copy (and extra copies if required) should be mailed to each coal operator at their respective addresses.

Farm name: RI	ussell White		Operator Well No.: MC46	Α
LOCATION: E	levation:1281.46		Quadrangle: Cameron	
	istrict: Cameron		County: Marshall	
			39 _{Deg.} <u>52</u> _{Min.} 0	4.92 Sec
			80 Deg. 34 Min.	
			Degiwiin	
Well Type: OIL	GAS <u>X</u>			
Company <u>C</u>	onsolidation Co	or Own	er1 Bridge Street Mono	ngah, WV 26554
		Coal O	perator	
Agent D	avid Roddy	or Own		
Permit Issued	Date 09/24/20			
STATE OF WES	ST VIRGINIA.	А	FFIDAVIT	
County of Mono	ongalia ss:			
Mark A. Wilson	and	Matthew A. Year	slev boing first d	uly sworn according to law depose
				were employed by the above named
well operator, an	nd participated in the	work of plugging a	nd filling the above well say th	nat said work was commenced on
the 3rd	_ day of <u>August</u>	, 20 <u>20</u> , and the	well was plugged and filled in	n the following manner:
TYPE	FROM	TO	PIPE REMOVED	LEFT
Lateral	50'	Lateral		
Expanding	50'	Surface		
7" Casing	0	510'	0'	510'
9 5/8" Casing	0	42'	0	42'
	monument: ^{77" of 7" casir} npleted on the <u>4th</u>	ng with company name, well #, day ofAugust	API #, and date cemented and	that the work of plugging and filling
			, 20 <u>20</u> .	
And further de	eponents saith not.	may, B	Vito,	NOTARY PUBLIC OFFICIAL SEA THOMAS J SULLIVAN
		Manhan A.	Jamela	State of West Virginia My Commission Expires September 15, 2022 52 Canterbury Dr Clarksburg, WV 26
Sworn and su	bscribe before me thi	is 1000 day of	Aug , 20,20,	Sz cancrody or clairsourg, wy zo
My commission e	expires: 09 luz l	n	Notary Public	<u>ک</u> .
Affidavit reviewe	d by the Office of Oil	and Gas:	in Vicherton	Title: Oil & Gas Inspector

Plugging Report for MSHA

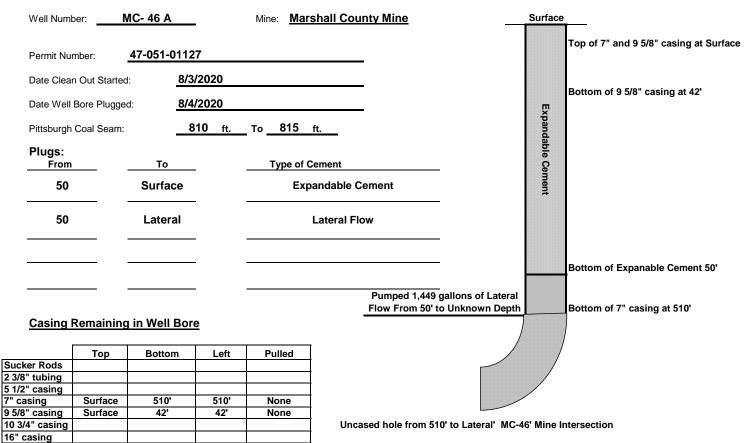

Lateral	1,449	gal
Econofill		gal
Mud Flush		gal
Other		
Est. Top Thix		ft
Did Cement Circ.	Yes	

105

Comments:

7" Fiberglass

Cement: Expandable

Caving: Extreme Moderate Normal Lost Circulation: Extreme Moderate Normal 3 Not Apply Difficulty in Removing Casing: Extreme Moderate Normal Debris in Well Bore: Wood Other: Hole Fill / Unknown Steel

466.48

815

gal

Surface Elevation (Surveyed) 1281.48 Bottom of Coal Structure (Map) Difference

WEST VIRGINIA

FORM WR-38 (Affidavit of Plugging)

DEPARTMENT OF ENVIRONMENTAL PROTECTION **OIL AND GAS WELLS DIVISION**

AFFIDAVIT OF PLUGGING AND FILLING WELL

AFFIDAVIT SHOULD BE MADE IN TRIPLICATE, one copy mailed to the Division, one copy to be retained by the Well Operator and the third copy (and extra copies if required) should be mailed to each coal operator at their respective addresses.

CONSOLIDATION COAL CO. Coal Operator or Owner 1 BRIDGE STREET MONONGAH, WV 26554 Address CONSOLIDATION COAL CO. **Coal Operator or Owner** 1 BRIDGE STREET MONONGAH, WV 26554 Address RUSSELL WHITE Lease or Property Owner 3905 BREEZEWAY, CT SEABROOK, TX 77586 Address

CONSOLIDATION COAL CO. Name of Well Operator 1 BRIDGE STREET MONONGAH, WV 26554 **Complete Address** CAMERON, WV-PA 7.5' Well Location **CAMERON** District MARSHALL County -46 (Access) Well No. RUSSELL L. WHITE JR Farm

STATE INSPECTOR SUPERVISING PLUGGING

AFFIDAVIT

STATE OF WEST VIRGINIA,

County of MONONGALIA ss: Mark A. Wilson and MATTHEW A. YEARSLEY being first duly sworn according to law depose and say that they are experienced in the work of plugging and filling oil and gas wells and were employed by Consolidation Coal Company well operator, and participated in the work of plugging and filling the above well, that said work was commenced on the 3RD of August, 2020, Year and that the well was plugged in the following manner:

Sand or Zone Record	Filling Material	Casing/Tubing Size	Casing Pulled	Casing Left In
Formation				
Logged access hole fro	om surface to bottom of 7" casing at 510".	7" Steel Casing	0'	510'
	" casing by pulling 150% of string weight.			
	ccessful. Tripped in the hole with 3 1/2" Drill	9 5/8" Steel Casing	0'	42'
	,449 gallons of Lateral Cement in the			
	op of the cement plug at 50' the following			
	ns of Expandable Cement from 50' to			
	irculate at surface. Pumped a total of 1,554			
	e total calculated volume. Left 510' of 7" 510'. Left 42' of 9 5/8" from surface to 42'.			
casing norn surface to	510. Left 42 019 5/8 11011 Sunace to 42.			
Coal Seams		Decorintion of Monumo	m t	
	(810' – 815')	Description of Monument		
<u>Pittsburgh</u>		77" of 7" casing w/ company name, well number,		
		permit number and date cemented stated on 7"		
		casing. Well marker will be attached to cement		
		plug at ground level.		

... and that the work of plugging and filling said well was completed on the 4th of August, 2020

And further deponents saith not.

anh A with Mark A. Wilson

Matthew A Vearsley

Sworn to and subscribed before me this 10th day of Ave, 2020

Notary Public

Permit No. 47-051-01127 Well No. MC-46 (Access) Latitude: 39° 52' 04.92"N Longitude: 80° 34' 05.82"W

My commission expires: Og lis los

