


470510 1139P



35' 36 37 (LITTLETON) LITTLETON 6.1 MI. 4863 11 NE 539 32'30" RECEIVED Office of Oil and Gas 54

SCALE 1:24 000

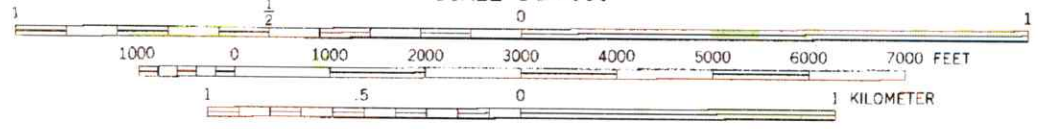

CONTOUR INTERVAL 20 FEET
NATIONAL GEODETIC VERTICAL DATUM OF 1929

1 MILE FEB 27 2023

WV Department of Environmental Protection

04/07/2023



0°17'
5 MILS

'Cameron; WV,PA' Scale: 1" = 0.379Mi 610Mt 2,000Ft, 1 Mi = 2.640" , 1 cm = 240Mt

4705101139P

WW-7
8-30-06



West Virginia Department of Environmental Protection
Office of Oil and Gas

WELL LOCATION FORM: GPS

API: 47-051-01139 WELL NO.: MC-17P

FARM NAME: JOHN CHAMBERS

RESPONSIBLE PARTY NAME: WEST VIRGINIA LAND RESOURCES INC.

COUNTY: MARSHALL DISTRICT: LIBERTY

QUADRANGLE: CAMERON WV, PA

SURFACE OWNER: JOHN W. CHAMBERS

ROYALTY OWNER: _____

UTM GPS NORTHING: 4,404,688 m (1450')

UTM GPS EASTING: 538,448 m GPS ELEVATION: 442 m

The Responsible Party named above has chosen to submit GPS coordinates in lieu of preparing a new well location plat for a plugging permit or assigned API number on the above well. The Office of Oil and Gas will not accept GPS coordinates that do not meet the following requirements:


- Datum: NAD 1983, Zone: 17 North, Coordinate Units: meters, Altitude: height above mean sea level (MSL) – meters.
- Accuracy to Datum – 3.05 meters
- Data Collection Method:

Survey grade GPS : Post Processed Differential _____
Real-Time Differential

Mapping Grade GPS _____ : Post Processed Differential _____
Real-Time Differential _____

- Letter size copy of the topography map showing the well location.**

I the undersigned, hereby certify this data is correct to the best of my knowledge and belief and shows all the information required by law and the regulations issued and prescribed by the Office of Oil and Gas.

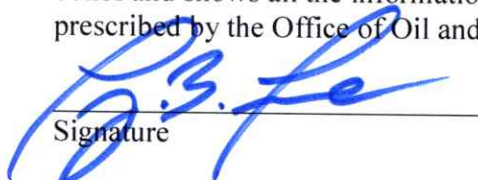
Signature

Professional Surveyor
Title

JANUARY 27, 2023
Date

RECEIVED
Office of Oil and Gas

FEB 27 2023

WV Department of
Environmental Protection

04/07/2023