

WW-7
8-30-06



West Virginia Department of Environmental Protection
Office of Oil and Gas

WELL LOCATION FORM: GPS

API: 47-051-01142 WELL NO.: MC-21P

FARM NAME: FRED QUIGLEY / PAUL & SANDRA HIERONIMUS

RESPONSIBLE PARTY NAME: WEST VIRGINIA LAND RESOURCES INC.

COUNTY: MARSHALL DISTRICT: LIBERTY

QUADRANGLE: CAMERON WV, PA

SURFACE OWNER: PAUL D. & SANDRA D. HIERONIMUS

ROYALTY OWNER: _____

UTM GPS NORTHING: 4,407,175 m (1476')

UTM GPS EASTING: 540,854 m GPS ELEVATION: 450 m

The Responsible Party named above has chosen to submit GPS coordinates in lieu of preparing a new well location plat for a plugging permit or assigned API number on the above well. The Office of Oil and Gas will not accept GPS coordinates that do not meet the following requirements:


- Datum: NAD 1983, Zone: 17 North, Coordinate Units: meters, Altitude: height above mean sea level (MSL) – meters.
- Accuracy to Datum – 3.05 meters
- Data Collection Method:

Survey grade GPS : Post Processed Differential _____
Real-Time Differential

Mapping Grade GPS _____ : Post Processed Differential _____
Real-Time Differential _____

4. Letter size copy of the topography map showing the well location.

I the undersigned, hereby certify this data is correct to the best of my knowledge and belief and shows all the information required by law and the regulations issued and prescribed by the Office of Oil and Gas.

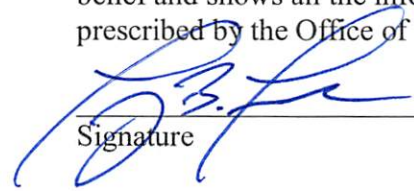

Signature

Professional Surveyor

Title

FEBRUARY 28, 2021

Date

RECEIVED
Office of Oil and Gas
APR 8 2021
WV Department of
Environmental Protection

11/05/2021



4410
50'
4409
4408
4406
4405
47'30"
4404


5.2 MI. TO P.A. 16

(NEW FREEPORT)
4963 IN SW

RECEIVED
Office of Oil and Gas
APR 8 2021
WV Department of
Environmental Protection
Compressor
Station

11/05/2021

4705101142

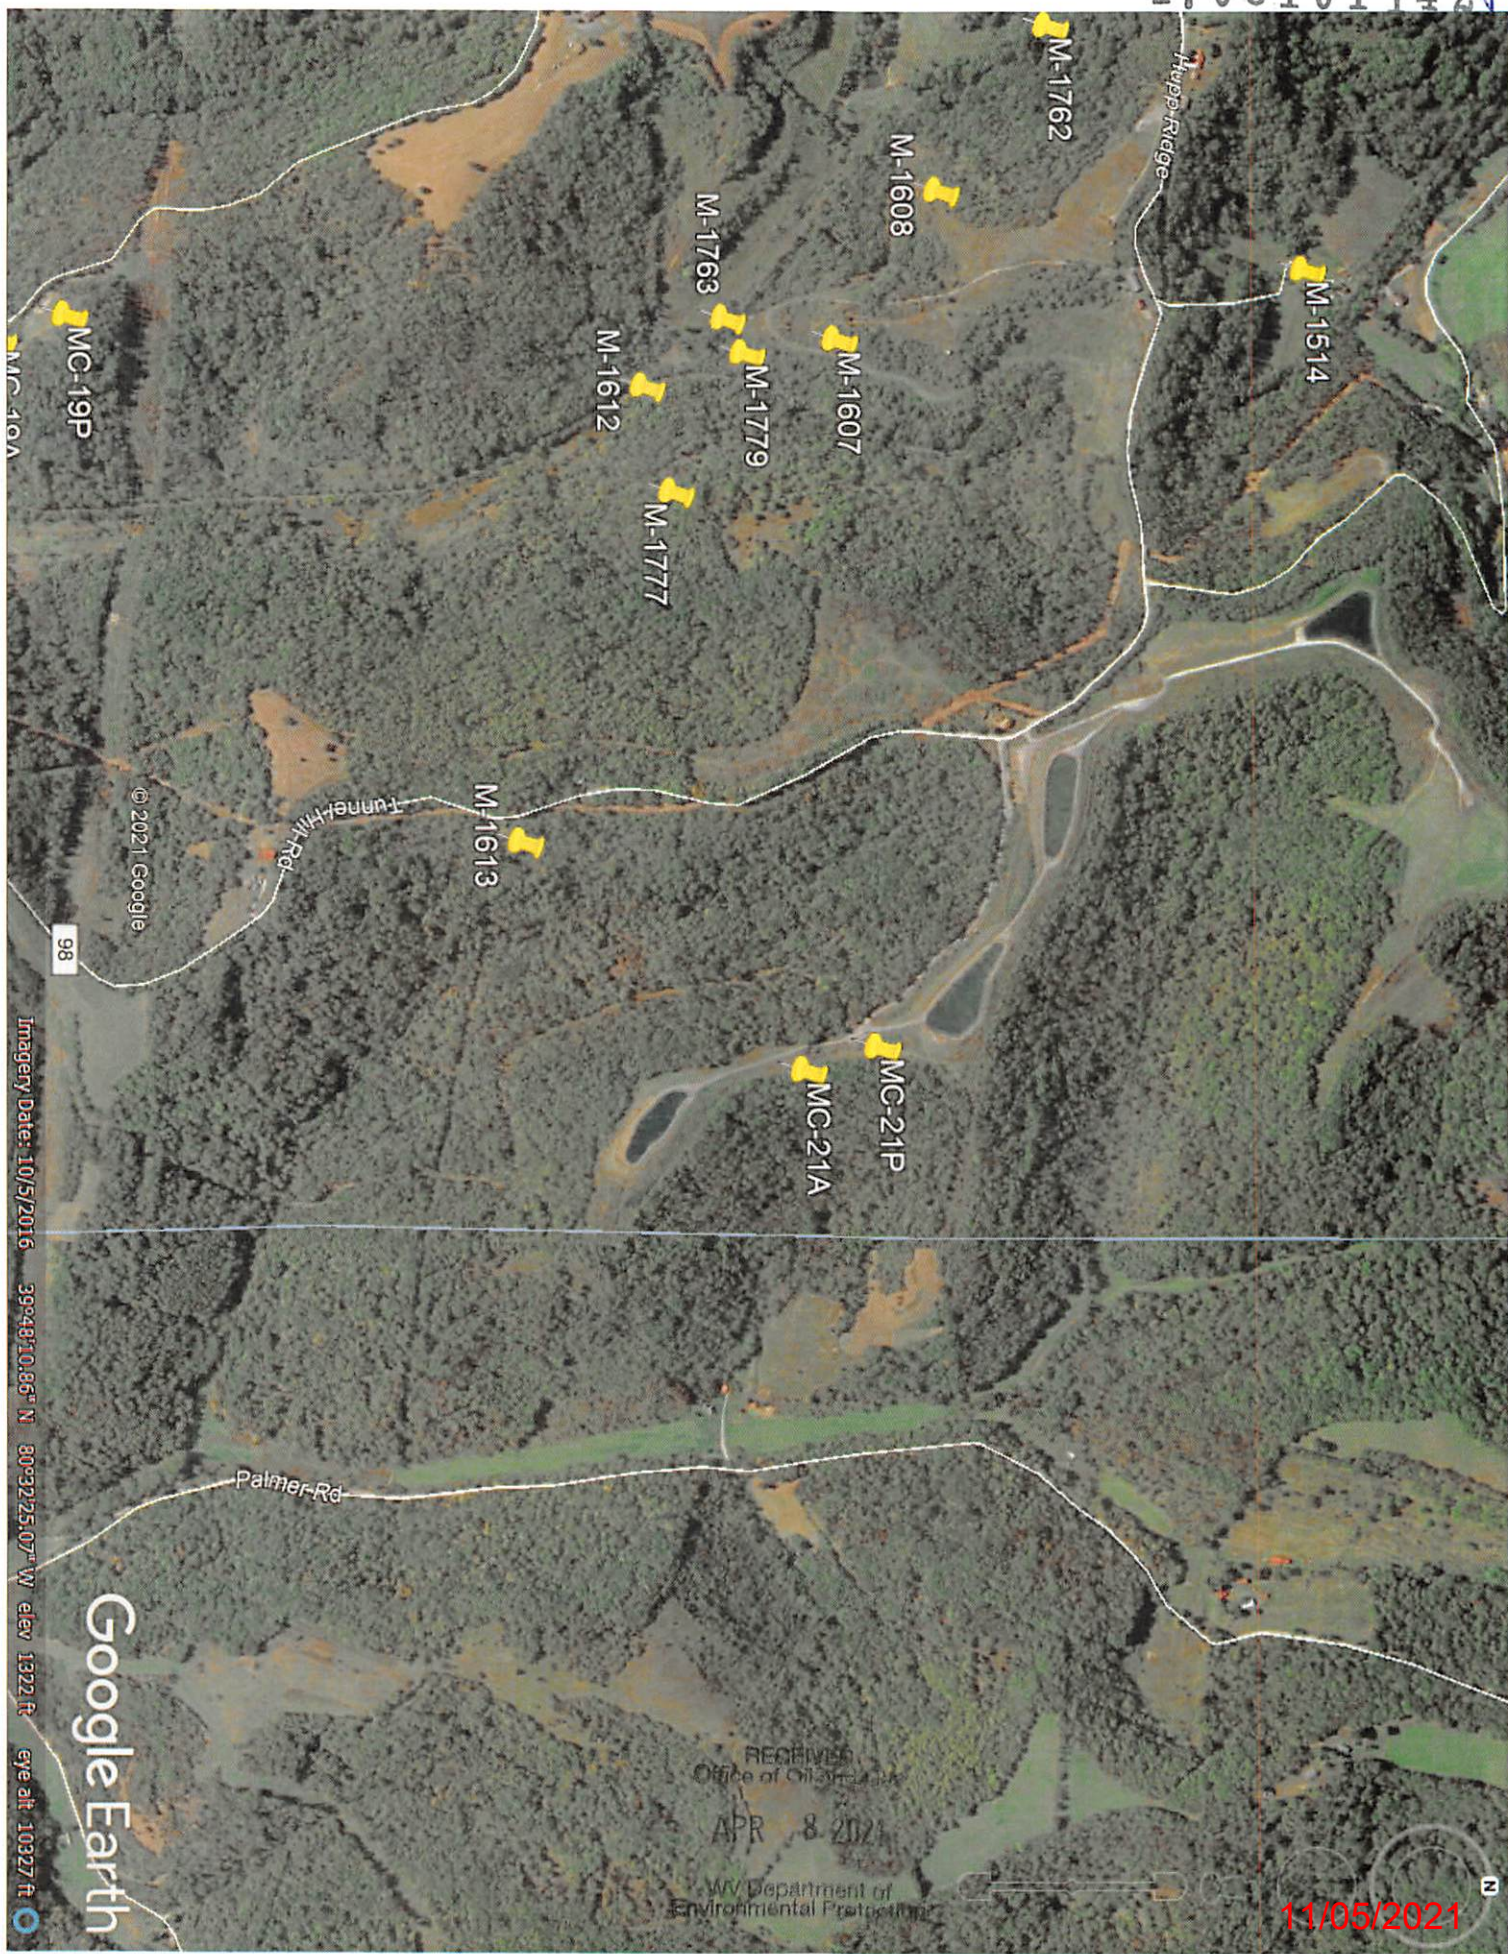

MC-19A
 MC-19P
 © 2021 Google
 98
 Imagery Date: 10/5/2016 39°48'10.86" N 80°32'25.07" W elev 1322 ft eye alt 10327 ft

Palmer-Rd
 Google Earth

RECEIVED
 Office of Oil and Gas
 APR 8 2021
 WV Department of
 Environmental Protection

11/05/2021