APR 25 2024



WV Department of Environmental Protection

West Virginia Department of Environmental Protection Office of Oil and Gas WELL LOCATION FORM: GPS

API: 47-051-01224 WELL NO.: Neehouse #1			
FARM NAME: Neehouse			
RESPONSIBLE PARTY NAME: EQT Production Company			
COUNTY: Marshall		_ DISTRICT:	Veb <u>ster</u>
QUADRANGLE: Majorsville 7.5'			
SURFACE OWNER: Leo W. Neehouse			
ROYALTY OWNER:			
UTM GPS NORTHING: 4418858			
UTM GPS EASTING:	536471	GPS ELEVATION	N: 371 m (1219 ft)
The Responsible Party named above has chosen to submit GPS coordinates in lieu of preparing a new well location plat for a plugging permit or assigned API number on the above well. The Office of Oil and Gas will not accept GPS coordinates that do not meet the following requirements: 1. Datum: NAD 1983, Zone: 17 North, Coordinate Units: meters, Altitude: height above mean sea level (MSL) – meters. 2. Accuracy to Datum – 3.05 meters 3. Data Collection Method: Survey grade GPS: Post Processed Differential Real-Time Differential Mapping Grade GPS: Post Processed Differential Real-Time Differential 4. Letter size copy of the topography map showing the well location. Ithe undersigned, hereby certify this data is correct to the best of my knowledge and belief and shows all the information required by law and the regulations issued and prescribed by the Office of Oil and Gas. Signature			
Signature	7	Title	<u> </u>

Topo Quad: Majorsville 7.5'

1" = 2000' Scale:

County:

Marshall

RECEIVED Office Of Oil and Gas

Date:


October 12, 2023

District:

Webster

APR 25 2024

304-44-W-23 Project No:

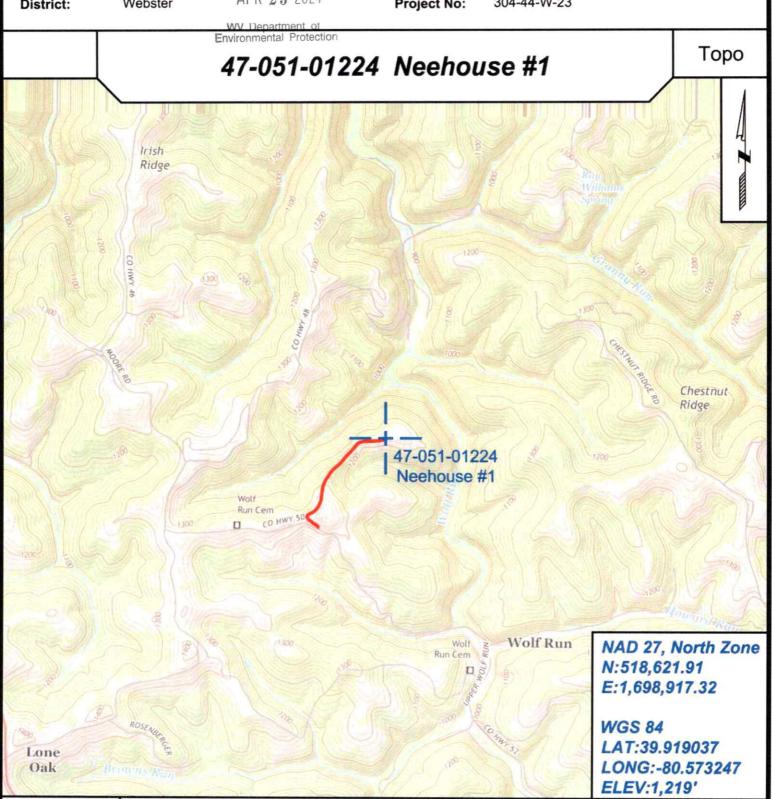



SURVEYING AND MAPPING SERVICES PERFORMED BY:

ALLEGHENY SURVEYS, INC.

237 Birch River Road Birch River, WV 26610 PH: (304) 649-8606 FAX: (304) 649-8608

PREPARED FOR:

EQT Production Company

400 Woodcliff Drive Canonsburg, PA 15317 06/07/2024