



Blue Mountain Engineering
 11023 MASON DIXON HIGHWAY
 BURTON, WV 26562
 PHONE: (304) 662-6486

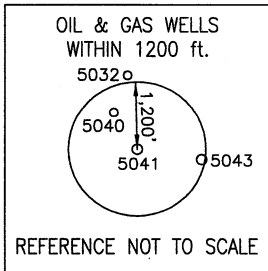

FILE #: 5041
 DRAWING #: 5041
 SCALE: 1" = 300'
 MINIMUM DEGREE OF ACCURACY: 1/2500
 PROVEN SOURCE OF ELEVATION: U.S.G.S. MONUMENT THOMAS 1498.81'

I, THE UNDERSIGNED, HEREBY CERTIFY THAT THIS PLAT IS CORRECT TO THE BEST OF MY KNOWLEDGE AND BELIEF AND SHOWS ALL THE INFORMATION REQUIRED BY LAW AND THE REGULATIONS ISSUED AND PRESCRIBED BY THE DEPARTMENT OF ENVIRONMENTAL PROTECTION.
 Signed: _____
 R.P.E.: _____ L.L.S.: P.S. No. 2000

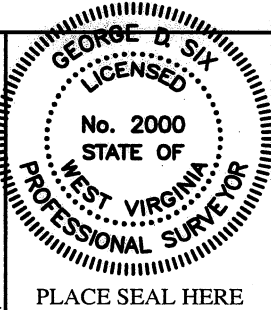

(+) DENOTES LOCATION OF WELL ON UNITED STATES TOPOGRAPHIC MAPS WVDEP
 OFFICE OF OIL & GAS
 601 57TH STREET
 CHARLESTON, WV 25304




DATE: JUNE 13, 2011
 OPERATOR'S WELL #: 5041
 API WELL #: 47 STATE 51 COUNTY PERMIT 01513P

Well Type: Oil Waste Disposal Production Deep
 Gas Liquid Injection Storage Shallow

WATERSHED: UNNAMED TRIBUTARY TO NORTH FORK OF GRAVE CREEK ELEVATION: 1329.78'
 COUNTY/DISTRICT: MARSHALL/CAMERON QUADRANGLE: CAMERON, WV-PA
 SURFACE OWNER: RANDY & REEDA WHYTE ACREAGE: 45.46±
 OIL & GAS ROYALTY OWNER: _____ ACREAGE: _____
 DRILL CONVERT DRILL DEEPER REDRILL FRACTURE OR STIMULATE
 PLUG OFF OLD FORMATION PERFORATE NEW FORMATION PLUG & ABANDON
 CLEAN OUT & REPLUG OTHER CHANGE (SPECIFY): _____
 TARGET FORMATION: NONE ESTIMATED DEPTH: _____

WELL OPERATOR CONSOL PENNSYLVANIA COAL COMPANY LLC DESIGNATED AGENT DON TETER / DOUG DINGER
 Address 192 CRABAPPLE ROAD Address 1525 PLEASANT GROVE ROAD, BOX J
 City WIND RIDGE State PA Zip Code 15380 City CLAYSVILLE State PA Zip Code 15323

51-01513P

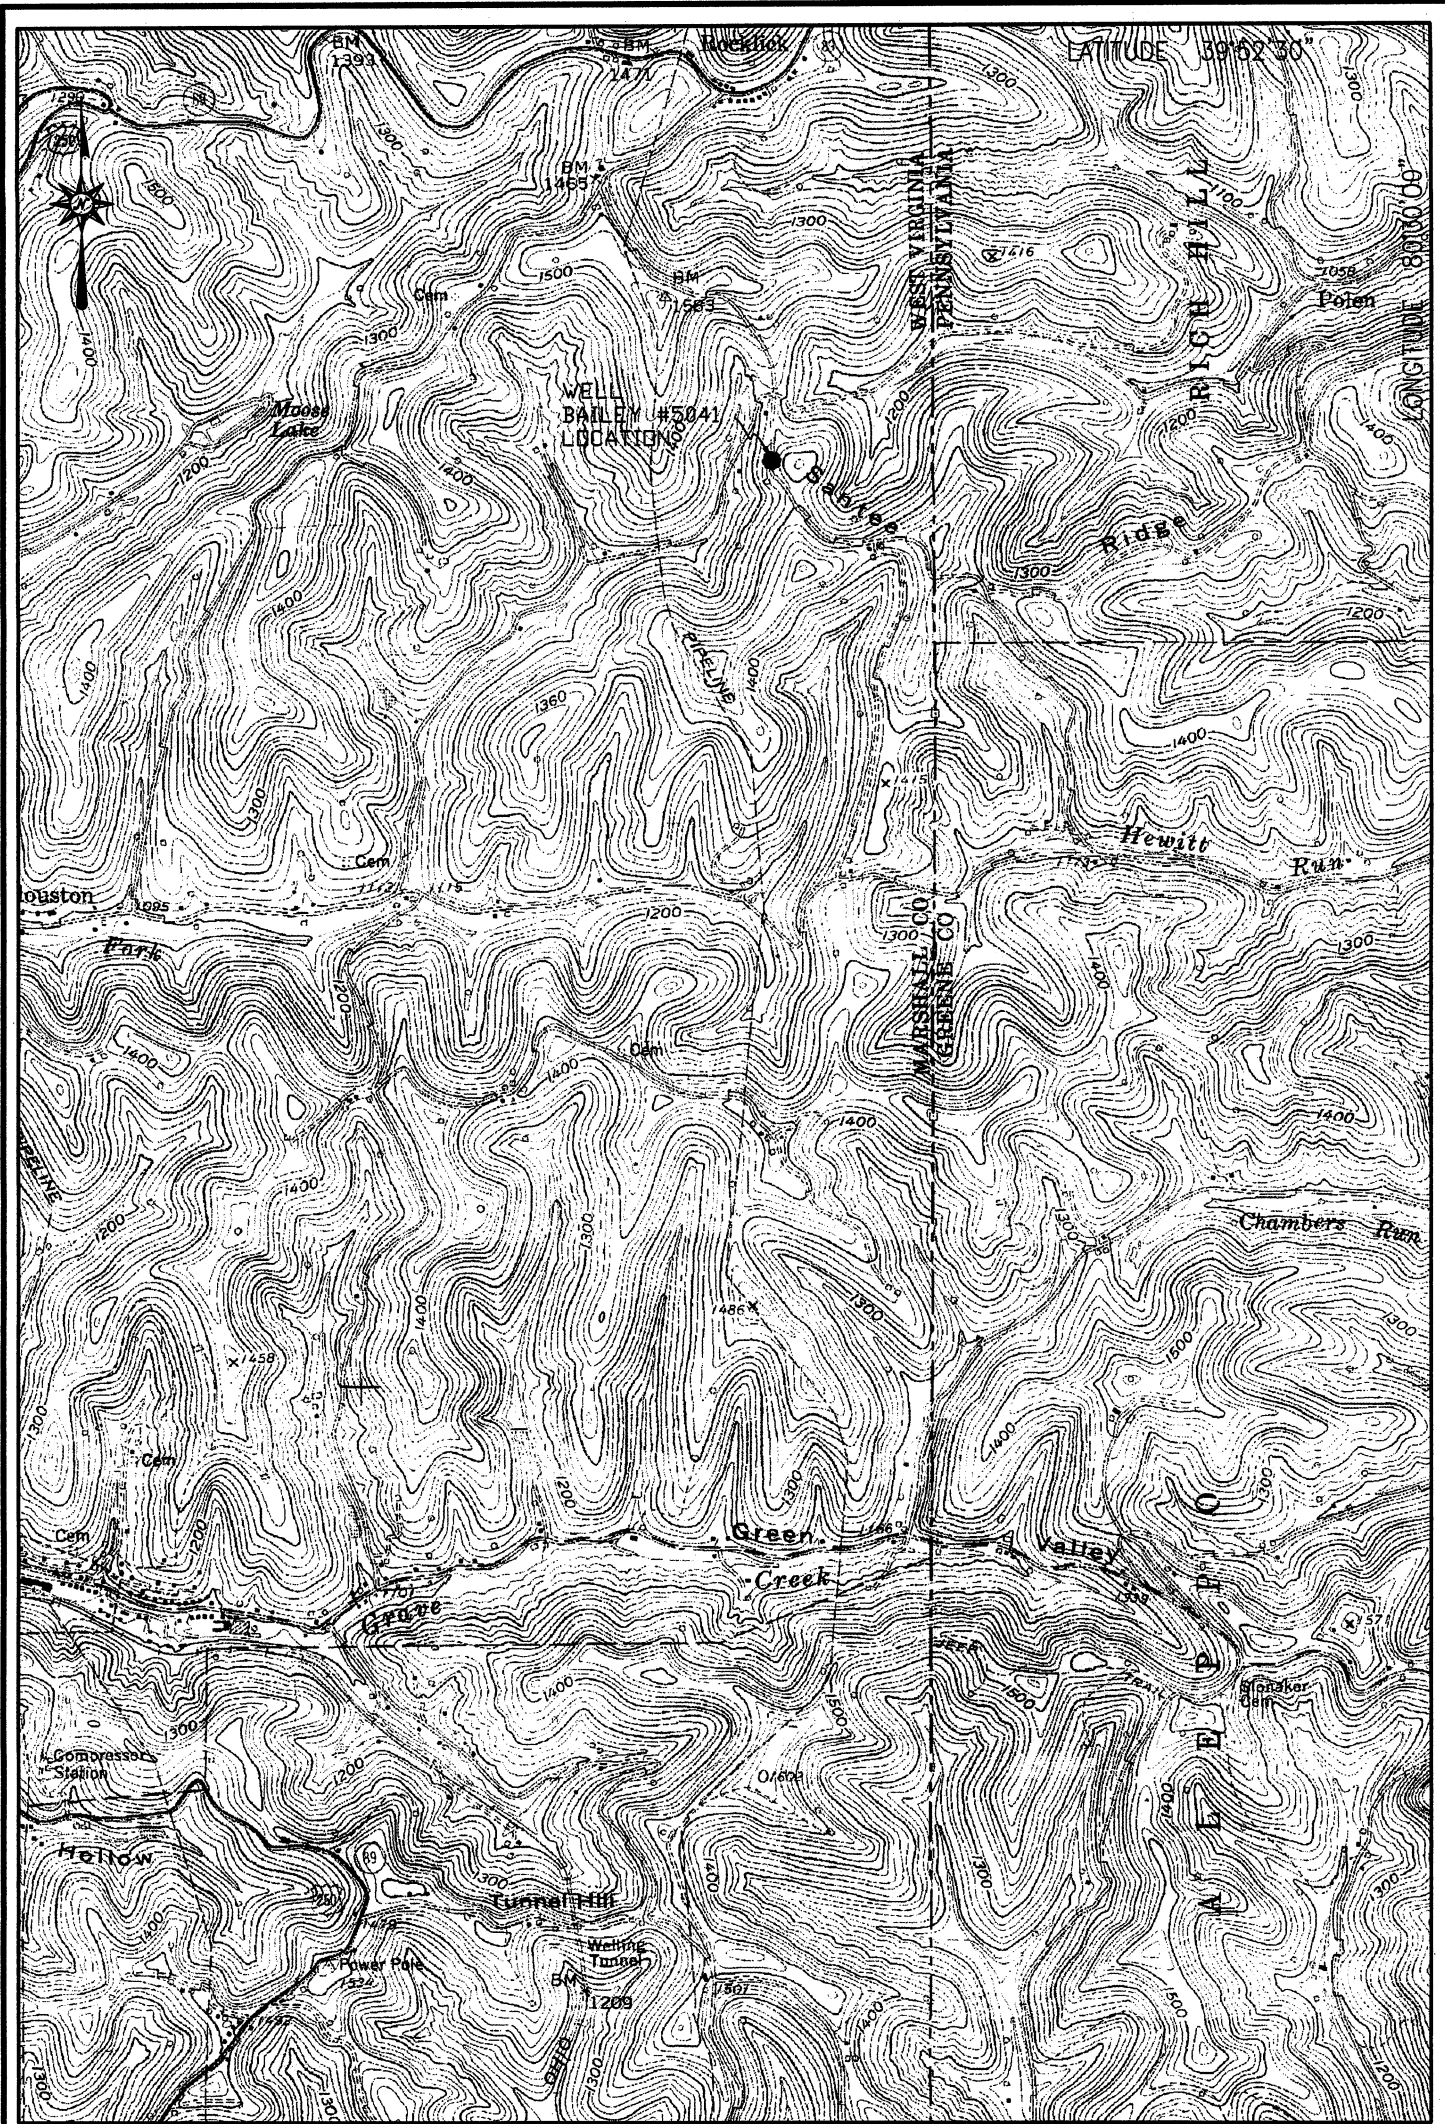

WELL #5041

CAMERON, WV-PA, U.S.G.S. 7.5 QUADRANGLE

SCALE 1" = 2000'

0' 2000' 4000' 6000'



12/23/2011