


Well is located on topo map 13,689' feet south of Latitude: 40° 02' 30"

Well is located on topo map 10,038' feet west of Longitude: 80° 30' 00"

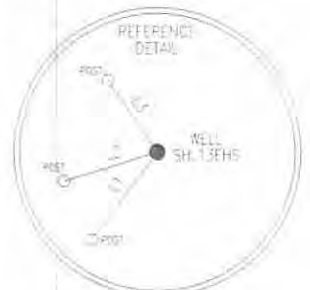

LINE	BEARING	DISTANCE
L1	S 37°06'48" W	236.18'
L2	S 73°09'26" W	211.48'
L3	N 34°30'14" W	189.17'

APPROX LANDING POINT	
UTM 17-NAD83	N:4428102.82 E:538996.40
NAD27, WV NORTH	N:548819.13 E:1707742.87

- NOTES:
- There are no water wells or developed springs within 250' of proposed well.
  - There are no existing buildings within 625' of proposed well.
  - Proposed well is greater than 100' from perennial stream, wetland, pond, reservoir or lake.
  - There are no native trout streams within 300' of proposed well.
  - Proposed well is greater than 1000' from surface/groundwater intake or public water supply.
  - It is not the purpose or intention of this plat to represent surveyed locations of the surface or mineral parcels depicted hereon. The location of the boundary lines, as shown, are based on record deed descriptions, field evidence found and/or tax map position, unless otherwise noted.

AS DRILLED BOTTOM HOLE LOCATION (BHL)	PERMITTED BOTTOM HOLE LOCATION (BHL)
UTM 17-NAD83 N:4429534.83 E:537947.32	UTM 17-NAD83 N:4429534.46 E:537957.88
NAD27, WV NORTH N:553575.92 E:1704348.77	NAD27, WV NORTH N:553574.12 E:1704383.39

PERMITTED SURFACE HOLE LOCATION (SHL)
UTM 17-NAD83 N:4428319.94 E:539637.04
NAD27, WV NORTH N:549496.40 E:1709826.68


AS DRILLED SURFACE HOLE LOCATION (SHL)
UTM 17-NAD83 N:4428319.85 E:539637.07
NAD27, WV NORTH N:549496.11 E:1709826.78

**LEGEND**

- TOP MAP POINT
- WELL
- ALL ARE POINTS UNLESS OTHERWISE NOTED
- WATER SOURCE
- LEASE NUMBER BASED (ON ATTACHED WW-6A1)
- MINERAL TRACT BOUNDARY
- PARCEL LINES
- WELL REFERENCE
- PROPOSED HORIZONTAL WELL
- ROAD
- STREAM CENTER LINE
- AS DRILLED

WELLS WITHIN 3000'

- EXISTING WELLS
- PROPOSED WELLS

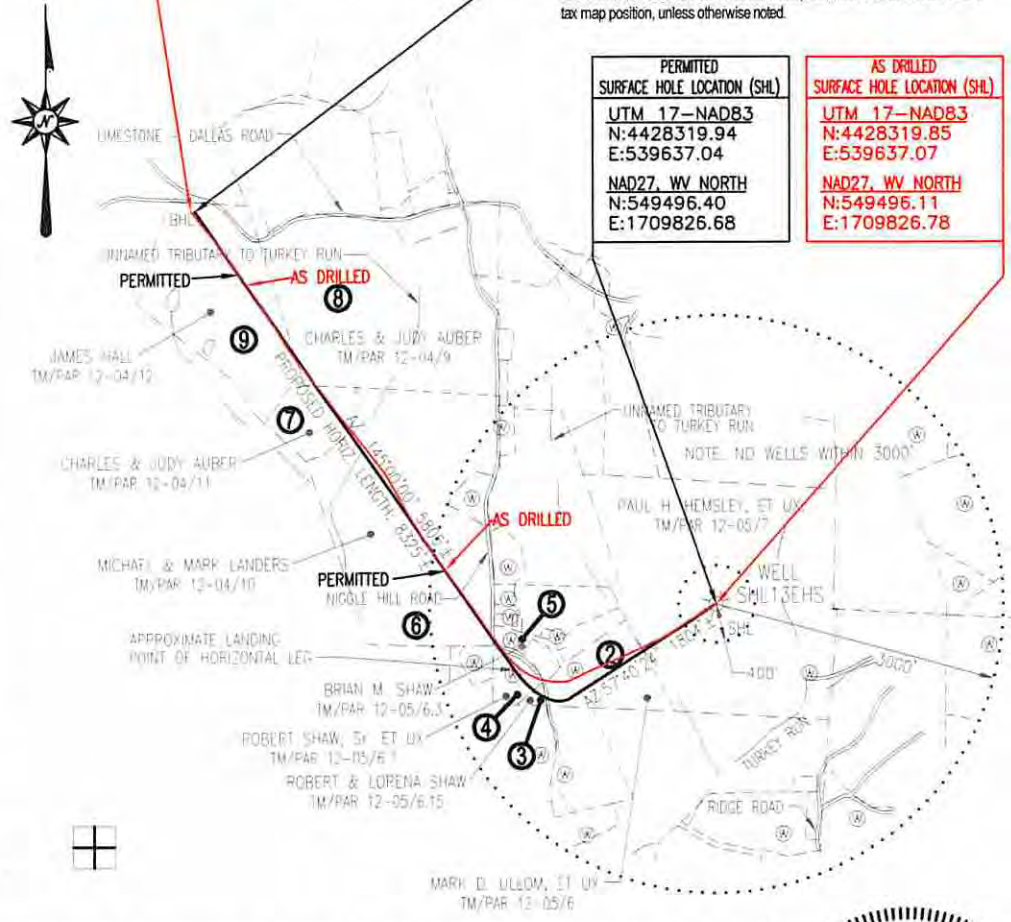

**Blue Mountain Inc.**  
11023 MASON DIXON HIGHWAY  
BURTON, WV 26562  
PHONE: (304) 662-6486

FILE #: SHL13EHS-AS DRILLED  
DRAWING #: SHL13EHS-AS DRILLED  
SCALE: 1" = 2000'  
MINIMUM DEGREE OF ACCURACY: 1/2500  
PROVEN SOURCE OF ELEVATION: U.S.G.S. MONUMENT THOMAS 1498.81'

I, THE UNDERSIGNED, HEREBY CERTIFY THAT THIS PLAT IS CORRECT TO THE BEST OF MY KNOWLEDGE AND BELIEF AND SHOWS ALL THE INFORMATION REQUIRED BY LAW AND THE REGULATIONS ISSUED AND PRESCRIBED BY THE DEPARTMENT OF ENVIRONMENTAL PROTECTION.

Signed: [Signature]  
R.P.E.: \_\_\_\_\_ L.L.S.: P.S. No. 2000



(+) DENOTES LOCATION OF WELL ON UNITED STATES TOPOGRAPHIC MAPS WVDEP  
OFFICE OF OIL & GAS  
601 57TH STREET  
CHARLESTON, WV 25304



DATE: OCTOBER 2, 2014  
OPERATOR'S WELL #: SHL13EHS-AS DRILLED  
API WELL #: 47 51  
STATE COUNTY PERMIT

Well Type:  Oil  Waste Disposal  Production  Deep  
 Gas  Liquid Injection  Storage  Shallow

WATERSHED: TURKEY RUN ELEVATION: 1288.25'  
COUNTY/DISTRICT: MARSHALL / SAND HILL QUADRANGLE: VALLEY GROVE, WV 7.5'  
SURFACE OWNER: PAUL H. & ANNETTE A. HEMSLEY ACREAGE: 121.65±  
OIL & GAS ROYALTY OWNER: SEE ATTACHED WW-6A1 ACREAGE: 393.282±

DRILL  CONVERT  DRILL DEEPER  REDRILL  FRACTURE OR STIMULATE   
PLUG OFF OLD FORMATION  PERFORATE NEW FORMATION  PLUG & ABANDON   
CLEAN OUT & REPLUG  OTHER CHANGE  (SPECIFY): \_\_\_\_\_

TARGET FORMATION: MARCELLUS ESTIMATED DEPTH: TVD: 6781'± TMD: 13521'±

WELL OPERATOR NOBLE ENERGY INC. DESIGNATED AGENT STEVEN M. GREEN  
Address 333 TECHNOLOGY DRIVE, SUITE 116 Address 500 VIRGINIA STREET EAST, UNITED CENTER SUITE 590  
City CANONSBURG State PA Zip Code 15317 City CHARLESTON State WV Zip Code 25301

10/31/2014