



---

**west virginia** department of environmental protection

---

Office of Oil and Gas  
601 57th Street SE  
Charleston, WV 25304  
(304) 926-0450  
(304) 926-0452 fax

Earl Ray Tomblin, Governor  
Randy C. Huffman, Cabinet Secretary  
[www.dep.wv.gov](http://www.dep.wv.gov)

May 02, 2016

**FINAL INSPECTION REPORT**

**Well Permit Cancelled**

GASTAR EXPLORATION USA, INC.,

The FINAL INSPECTION REPORT for the CANCELLED permit, API Well Number: 47-5101697, issued to GASTAR EXPLORATION USA, INC., and listed below has been received in this office. The permit has been cancelled as of 4/27/2016.


James Martin  
Chief

Operator: GASTAR EXPLORATION USA, INC.  
Operator's Well No: BLAKE NO. 2H  
Farm Name: BUNGARD, WILBERT H. , ET AL  
**API Well Number: 47-5101697**  
Date Issued: 01/16/2014

Date Cancelled: 04/27/2016

Promoting a healthy environment.

05/06/2016

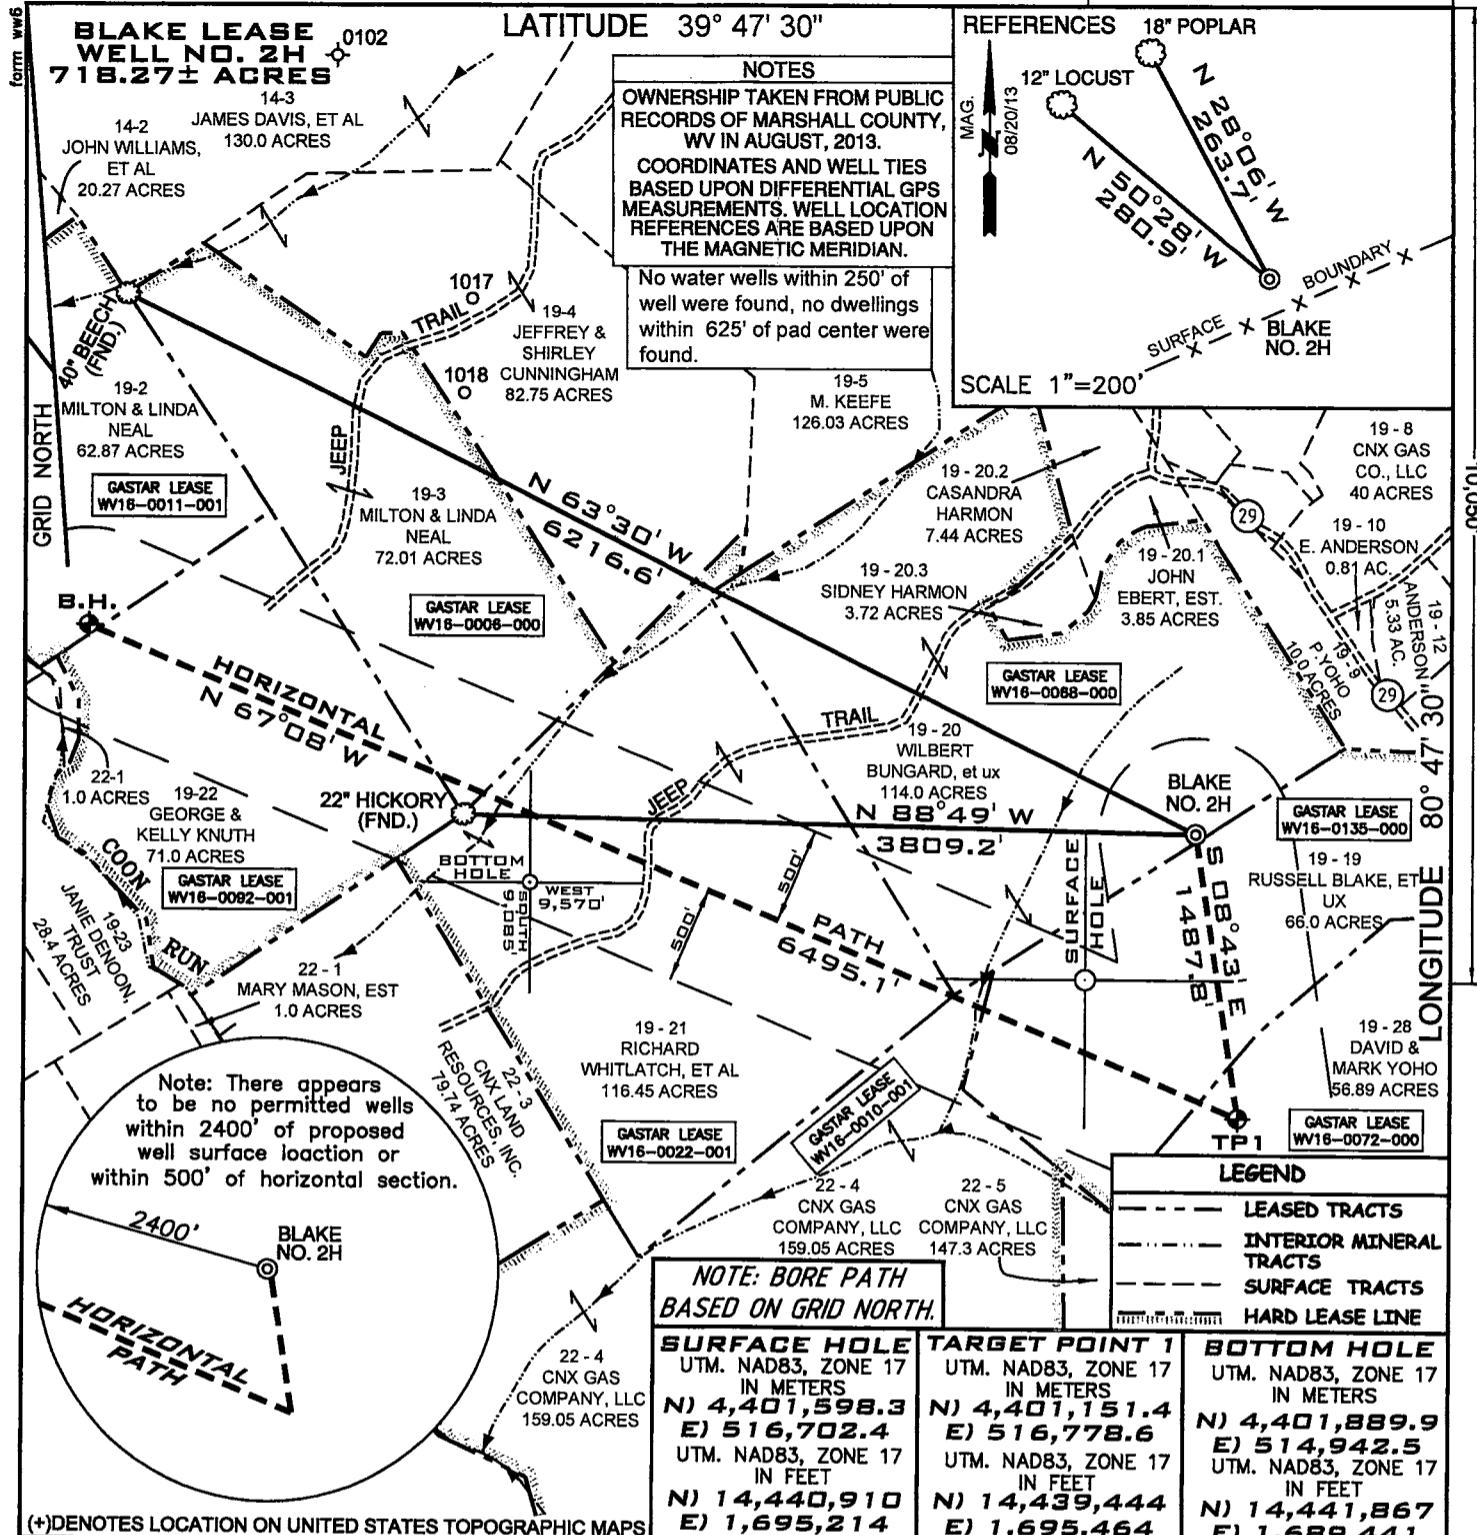

FILE NUMBER W0120321 (WB1-70)

DRAWING NUMBER BLAKE\_WP\_2H


SCALE 1" = 1000'

MINIMUM DEGREE OF ACCURACY 1/200

PROVEN SOURCE OF ELEVATION SUBMETER MAPPING  
GRADE GPS

I, THE UNDERSIGNED, HEREBY CERTIFY THAT THIS PLAT IS CORRECT TO THE BEST OF MY KNOWLEDGE AND BELIEF AND SHOWS ALL THE INFORMATION REQUIRED BY LAW AND THE REGULATIONS ISSUED AND PRESCRIBED BY THE DEPARTMENT OF ENVIRONMENTAL PROTECTION

P.S. 2122 *Jonathan N. White*

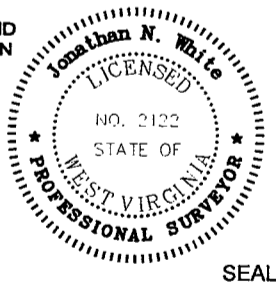

WVDEP  
OFFICE OF OIL & GAS  
601 57TH STREET  
CHARLESTON, WV 25304

DATE: AUGUST 23, 2013

OPERATORS WELL NO. BLAKE NO. 2H  
API WELL NO. CANCELLED  
47-051-01697 H6A  
STATE COUNTY PERMIT

LOCATION ELEVATION 1326' WATERSHED (HUC 10) FRENCH CREEK - OHIO RIVER (UNDEFINED)

DISTRICT FRANKLIN COUNTY MARSHALL

QUADRANGLE POWHATAN POINT 7.5' LEASE NUMBER WV16-0006-000, WV16-0072-000, WV16-0022-001, WV16-0092-001, WV16-0011-001, WV16-0135-000, WV16-0068-000, WV16-0010-001

SURFACE OWNER WIBERT H. BUNGARD, ET UX ACREAGE 114.0

OIL & GAS ROYALTY OWNER RUSSELL BLAKE, ET AL LEASE ACREAGE 718.27

PROPOSED WORK: DRILL  CONVERT  DRILL DEEPER  REDRILL  FRACTURE OR STIMULATE  PLUG OFF OLD FORMATION   
PERFORATE NEW FORMATION  OTHER PHYSICAL CHANGE (SPECIFY) \_\_\_\_\_

TARGET FORMATION MARCELLUS PLUG & ABANDON  CLEAN OUT & REPLUG   
ESTIMATED DEPTH 6511' + Horizontal Leg

WELL OPERATOR GASTAR EXPLORATION USA, INC. DESIGNATED AGENT MICHAEL McCOWN  
ADDRESS 229 W MAIN STREET, SUITE 301 CLARKSBURG WV, 26301 ADDRESS 229 W MAIN STREET, SUITE 301 CLARKSBURG WV, 26301

COUNTY NAME PERMIT

0506/2016