
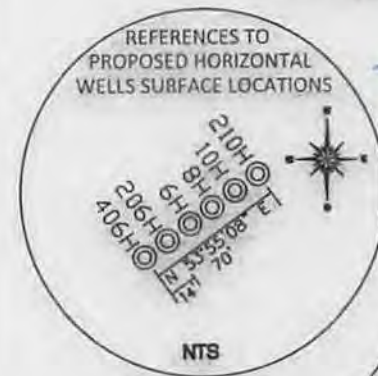
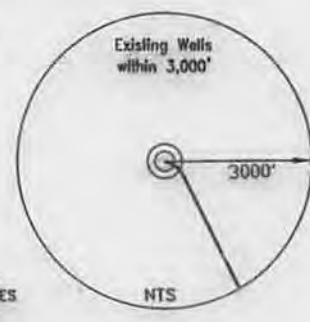


TOP HOLE (UTM NAD 83) N) 4418629.2 E) 532734.6	A MICHAEL R. MAGERS ET UX 15-14-7.2 LEASE NUMBER 8 1.05 AC
BOTTOM HOLE (UTM NAD 83) N) 4416767.5 E) 533758.2	B MICHAEL R. AND DANK S. MAGERS 15-14-7.3 LEASE NUMBER 9 3.389 AC
	C GNDY KAY McNIER 15-14-13.3 LEASE NUMBER 10 1.816 AC

NO WATER WELLS WERE FOUND WITHIN 250' OF THE CENTER OF WELL PAD

- 1 N 89°17'42" W 962'
- 2 S 86°57'13" W 942'
- 3 S 30°49'59" W 685'

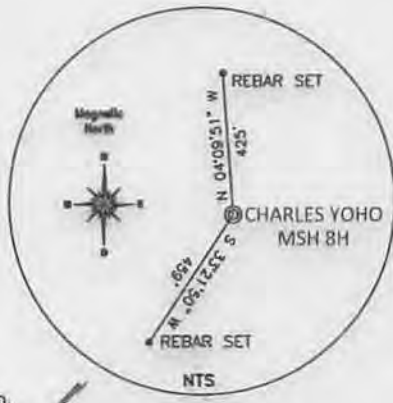

REFERENCE NOTES
Boundaries as shown taken from deeds, tax maps and field locations. A full boundary survey is not expressed nor implied. All bearings are based on true north. Ownership taken from public records Marshall County, West Virginia JUNE 2013
State Plane Coordinates & NAD 83 Lat/Long by differential submeter mapping grade GPS
Drafted by: E.A.M.

FILE #: CHE 119
DRAWING #: 2276
SCALE: PLAT - 1" = 1200'
TICK MARK - 1" = 2000'
MINIMUM DEGREE OF ACCURACY: 1/200
PROVEN SOURCE OF ELEVATION: SUBMETER MAPPING GRADE GPS

I, THE UNDERSIGNED, HEREBY CERTIFY THAT THIS PLAT IS CORRECT TO THE BEST OF MY KNOWLEDGE AND BELIEF AND SHOWS ALL THE INFORMATION REQUIRED BY LAW AND THE REGULATIONS ISSUED AND PRESCRIBED BY THE DEPARTMENT OF ENVIRONMENTAL PROTECTION.
Signed: _____
L.L.S. #2124 : Ernest J. Benchek III



(+) DENOTES LOCATION OF WELL ON UNITED STATES TOPOGRAPHIC MAPS WYDEP
OFFICE OF OIL & GAS
601 57TH STREET
CHARLESTON, WV 25304

Well Type: Oil Waste Diposal Production Deep
 Gas Liquid Injection Storage Shallow

WATERSHED: WHEELING CREEK
COUNTY/DISTRICT: MARSHALL/WEBSTER
SURFACE OWNER: DOROTHY L. YOHO
OIL & GAS ROYALTY OWNER: DOROTHY L. YOHO
LEASE NUMBERS: _____

DATE: OCTOBER 16, 2013
OPERATOR'S WELL #: CHARLES YOHO MSH 8H
API WELL #: 47 51 01736 H6A
STATE COUNTY PERMIT

ASBUILT ELEVATION: 1330'
QUADRANGLE: MAJORSVILLE, WV
ACREAGE: 84.25 +/-
ACREAGE: 439.65 +/-

DRILL CONVERT DRILL DEEPER REDRILL FRACTURE OR STIMULATE
PLUG OFF FORMATION PERFORATE NEW FORMATION PLUG & ABANDON
CLEAN OUT & REPLUG OTHER CHANGE (SPECIFY): _____

TARGET FORMATION: MARCELLUS
ESTIMATED DEPTH: TVD: 6,663' TMD: 13,448'
WELL OPERATOR: CHESAPEAKE APPALACHIA, LLC
DESIGNATED AGENT: ERIC GILLESPIE
ADDRESS: PO BOX 18496
ADDRESS: PO BOX 6070
CITY: OKLAHOMA CITY STATE: OK ZIP CODE: 73154-0496
CITY: CHARLESTON STATE: WV ZIP CODE: 25301

SURFACE HOLE DEC. LAT: 39.917049
SURVEYED LAT: 39° 55' 01.4"

WELL NAME: CHARLES YOHO MSH 8H
QUAD: MAJORSVILLE WV

