

West Virginia Department of Environmental Protection  
Office of Oil & Gas

**WELL LOCATION FORM: GPS**

API: 47- 051 - 1764 WELL NO: MND99 V

FARM NAME: Centurial Products

RESPONSIBLE PARTY NAME: \_\_\_\_\_

COUNTY: Marshall DISTRICT: Franklin

QUADRANGLE: Powhatan Point 7.5'

SURFACE OWNER: Consolidation Coal Co./Murray Energy

ROYALTY OWNER: Consolidation Coal Co./Murray Energy

UTM GPS NORTHING: 4,410,361

UTM GPS EASTING: 518,299 GPS ELEVATION: (1191')  
363 m.

The Responsible Party named above has chosen to submit GPS coordinates in lieu of preparing a new well location plat for a plugging permit on the above well. The Office of Oil & Gas will not accept GPS coordinates that do not meet the following requirements:

1. Datum: NAD 1983, Zone:17 North, Coordinate Units: meters, Altitude: height above mean sea level (MSL) - meters.
2. Accuracy to Datum - 3.05 meters
3. Data Collection Method:

Survey Grade GPS	<input type="checkbox"/>	Post Processed Differential	<input type="checkbox"/>
		Real-Time Differential	<input type="checkbox"/>
Mapping Grade GPS	<input checked="" type="checkbox"/>	Post Processed Differential	<input checked="" type="checkbox"/>
		Real-Time Differential	<input type="checkbox"/>

RECEIVED  
Office of Oil and Gas  
OCT 12 2018  
WV Dept. of Env. Protection

I the undersigned, hereby certify this data is correct to the best of my knowledge and belief and shows all the information required by law and the regulations issued and prescribed by the Office of Oil and Gas.

Diane White Diane C. White  
Signature

Designated Agent  
Title


August 14, 2018  
Date

47-051-01764P

SUBJECT WELL  
MND99 V  
47-051-01764

OCT 19 2018

Office of  
WV Depart  
Environmental Protection

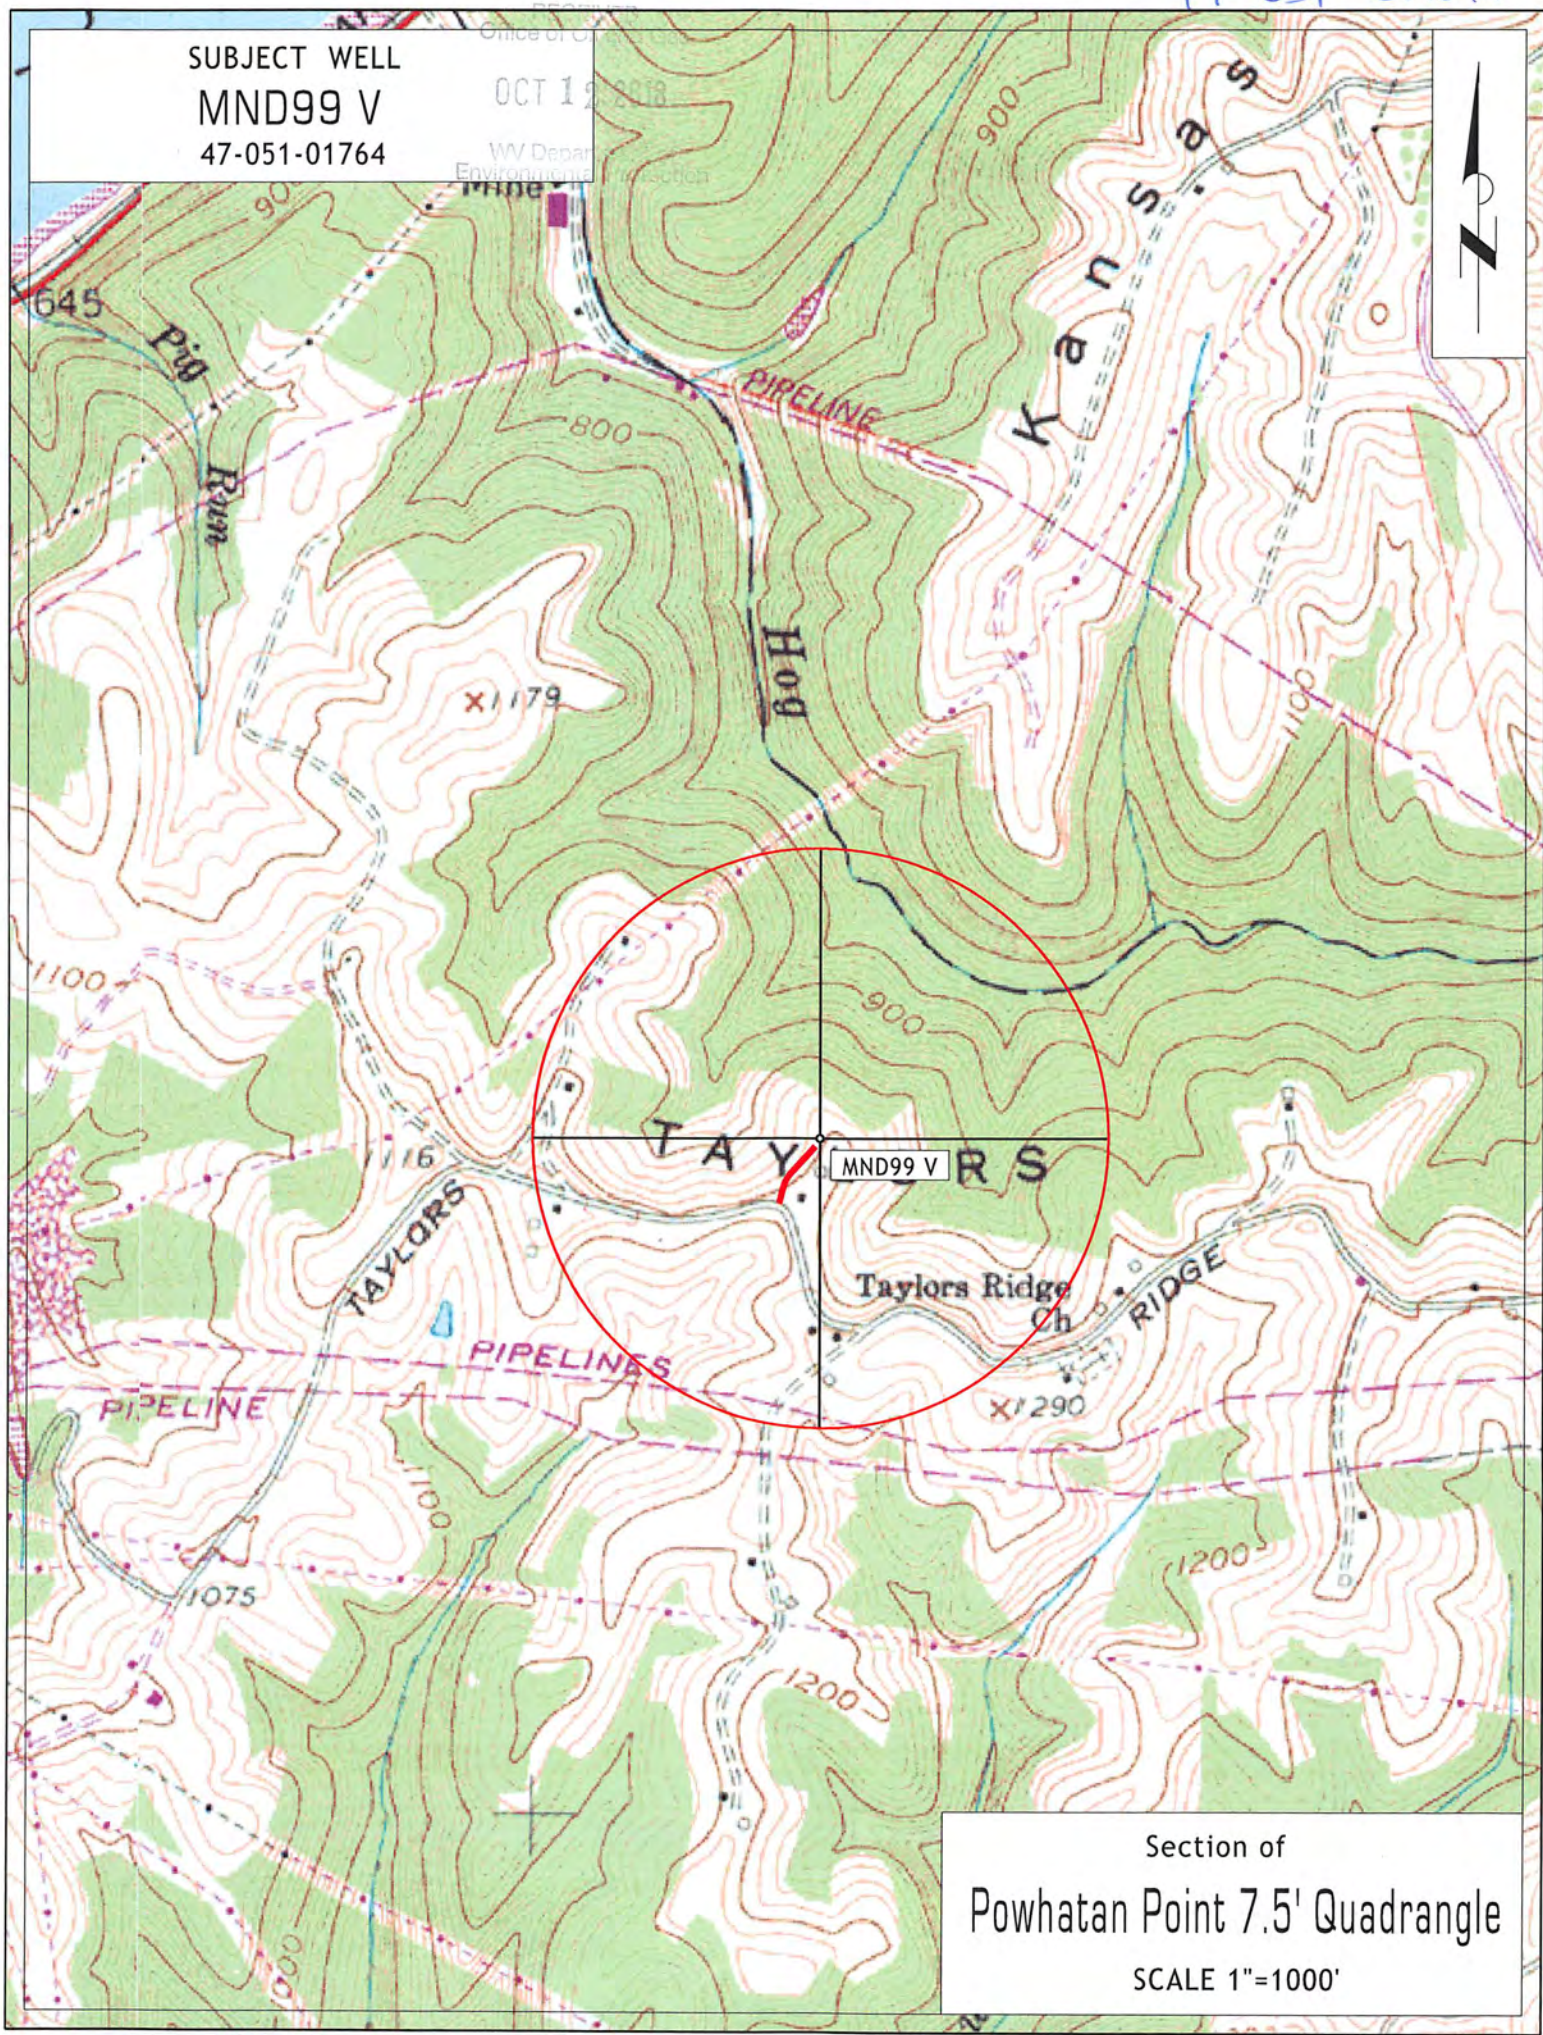

Section of  
Powhatan Point 7.5' Quadrangle  
SCALE 1"=1000'