


FILE #: MAJ6HHSU-AS DRILLED
 DRAWING #: MAJ6HHSU-AS DRILLED
 SCALE: 1" = 2000'
 MINIMUM DEGREE OF ACCURACY: 1/2500
 PROVEN SOURCE OF ELEVATION: U.S.G.S. MONUMENT THOMAS 1498.81'

I, THE UNDERSIGNED, HEREBY CERTIFY THAT THIS PLAT IS CORRECT TO THE BEST OF MY KNOWLEDGE AND BELIEF AND SHOWS ALL THE INFORMATION REQUIRED BY LAW AND THE REGULATIONS ISSUED AND PRESCRIBED BY THE DEPARTMENT OF ENVIRONMENTAL PROTECTION.

Signed: *George D. Six*
 R.P.E.: _____ L.L.S.: P.S. No. 2000

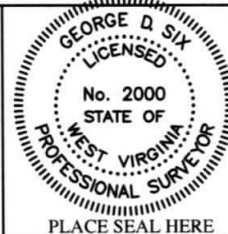

(+) DENOTES LOCATION OF WELL ON UNITED STATES TOPOGRAPHIC MAPS WVDEP
 OFFICE OF OIL & GAS
 601 57TH STREET
 CHARLESTON, WV 25304

DATE: JULY 22, 2019
 OPERATOR'S WELL #: MAJ6HHSU-AS DRILLED
 API WELL #: 47 51 02010
 STATE COUNTY PERMIT

Well Type: Oil Waste Disposal Production Deep Gas Liquid Injection Storage Shallow

WATERSHED: WHEELING CREEK ELEVATION: 1367.87'
 COUNTY/DISTRICT: MARSHALL / WEBSTER QUADRANGLE: MAJORSVILLE, WV 7.5'
 SURFACE OWNER: CNX LAND, LLC ACREAGE: 95.23±
 OIL & GAS ROYALTY OWNER: CNX GAS COMPANY LLC ACREAGE: 1679.35±

DRILL CONVERT DRILL DEEPER REDRILL FRACTURE OR STIMULATE PLUG OFF OLD FORMATION
 PERFORATE NEW FORMATION PLUG & ABANDON CLEAN OUT & REPLUG OTHER CHANGE

(SPECIFY): _____

TARGET FORMATION: POINT PLEASANT ESTIMATED DEPTH: TVD: 11,850± TMD: 18,223±
 WELL OPERATOR CNX GAS COMPANY LLC DESIGNATED AGENT CHRIS TURNER
 Address 1000 CONSOL ENERGY DRIVE Address 1 DOMINION DRIVE
 City CANONSBURG State PA Zip Code 15317 City JANE LEW State WV Zip Code 26378

BHL is located on topo map 12,487 feet south of Latitude: 39° 57' 30"
 SHL is located on topo map 8,601 feet south of Latitude: 39° 57' 30"
 BHL is located on topo map 7,574 feet west of Longitude: 80° 30' 00"
 SHL is located on topo map 1,913 feet west of Longitude: 80° 32' 30"

RECEIVED
 Office of Oil and Gas
 AUG 27 2019
 WV Department of Environmental Protection

MAJ6HHSU

PAGE 2 OF 2

AS DRILLED PLAT

| | SURFACE OWNER | DIST-TM/PAR |
|----|----------------------------------|-------------|
| A | CNX LAND, LLC | 15-5/13 |
| B | CONSOLIDATION COAL COMPANY | 15-5/14 |
| C | ROBERT R. RIGGLE | 15-5/34.1 |
| D | CONSOL MINING COMPANY LLC | 15-5/39 |
| E | ROBERT R. RIGGLE ET UX | 15-5/35 |
| F | MT HOPE CEMETERY ASSOC | 15-5/36 |
| G | MT HOPE CEMETERY | 15-5/37.1 |
| H | ALBERT J. PACZEWSKI JR. ET UX | 15-5/37 |
| J | BOARD OF EDUCATION | 15-5/38 |
| K | DANFORD & DEBORAH A. O'BRIAN | 15-4/14 |
| L | ELIZABETH ANN CAIN - LIFE | 15-4/14.2 |
| M | ELIZABETH ANN CAIN - LIFE | 15-4/14.1 |
| N | CNX LAND, LLC | 15-5/12 |
| P | ALBERT J. PACZEWSKI, JR. ET UX | 15-5/40 |
| Q | BRIAN K. & MARY MILLIKEN TRUST | 15-5/43.1 |
| R | BRIAN K. & MARY MILLIKEN - TRUST | 15-5/43 |
| S | CHARLES ALBERT WITSBERGER II | 15-5/44 |
| T | RANDALL B. SCHMIDT | 15-5/41 |
| U | RANDALL B. SCHMIDT | 15-5/41.1 |
| V | MIKE ROSS INC | 15-5/42 |
| W | RANDALL B. SCHMIDT | 15-11/10 |
| X | TIM M. TURLEY & TAMMY JENKINS | 15-5/48 |
| Y | CNX LAND, LLC | 15-11/12 |
| Z | CNX LAND, LLC | 15-11/11 |
| AA | ROGER D. MCCrackEN ET AL | 15-11/21 |
| BB | MICHAEL S. RIGGLE | 15-11/20 |
| CC | MICHAEL S. RIGGLE | 15-11/19 |
| DD | DAVID L. KINNEY ET AL | 15-11/9 |

| | LESSOR | DIST-TM/PAR |
|-----------------|--|----------------------|
| 1 | ELMER AND OTA HARTLEY | 15-5/13 |
| 2 | HAZEL SAMMONS | P/O 15-5/14 |
| 3 | THOMAS J. AND RUTH ELDER | 15-5/37 15-5/40 |
| 4 | ELLSWORTH H. AND BESSIE E. HARSH MILDRED HARSH PAUL HARSH CATHERINE H. AND GEORGE E. MCCARRIAN SHERE E. AND BARBARA HARSH JOHN A. AND LUCILLE HARSH | 15-5/12 |
| 5 | SANDRA C. KOONTZ DRY RIDGE RESOURCES, LLC MARTHA KAY AND CHARLES D. HILL | 15-5/41 15-5/41.1 |
| 6 | SANDRA C. KOONTZ DRY RIDGE RESOURCES LLC MARTHA KAY AND CHARLES D. HILL | 15-11/10 |
| 7, 16 | AUGUST W. CHAMBERS, ET AL CHESTNUT HOLDINGS | P/O 15-11/21 |
| 8 | MARGARET MORAN | 15-11/11 |
| 9, 18 19, 20 | MARGARET MORAN | P/O 15-11/12 |
| 10 | MICHAEL S. RIGGLE | 15-11/20 |
| 11 | H. B. CHAMBERS AUGUST AND BESSIE CHAMBERS GAIL DOLAN | 15-5/39 |
| 12 | ROBERT R. AND DONNA S. RIGGLE | 15-5/34.1 |
| 13 | ROBERT R. AND DONNA S. RIGGLE | 15-5/35 |
| 14 | BRIAN K. AND MARY LYNN MILLIKEN JAY K. AND PATRICIA L. WALLACE SARA JANE WALLACE | P/O 15-5/43 |
| 15 | J. L. AND ELIZABETH V. CROW | 15-5/42 |
| 17 | MICHAEL S. RIGGLE | 15-11/19 |
| 21 | DAVID L. AND RAYMOND P. KINNEY | 15-11/9 |
| 22A, 22B | CAROL L. COOPER & DALES GITTINGS, CO TRUSTEES OF THE MOUNT HOPE CEMETERY ASSOCIATION VIRGINIA M. BLAKE AND LAURENCE F. PARSONS | P/O 15-5/36 |
| 23 | MOUNT HOPE CEMETERY ASSOCIATION | 15-5/37.1 |
| 24 | ELLSWORTH H. AND THELMA L. SCHERICH JACKIE L. FRYE RICHARD P. AND MARY LEE BARTO SCOTT DOUGLAS REED ROBERT B. ELLIOTT TIERRA OIL COMPANY | 15-4/14 |
| 25 | JACKIE L. FRYE RICHARD P. AND MARY LEE BARTO SCOTT DOUGLAS REED ROBERT B. ELLIOTT TIERRA OIL COMPANY ELIZABETH ANN CAIN(LIFE TENANT) AND JACK A. AND NANCY C. CAIN(REMAINDERMEN) | 15-4/14.2 |
| 26 | JACKIE L. FRYE RICHARD P. AND MARY LEE BARTO SCOTT DOUGLAS REED ROBERT B. ELLIOTT TIERRA OIL COMPANY ELIZABETH ANN CAIN(LIFE TENANT) AND JACK A. AND NANCY C. CAIN(REMAINDERMEN) | 15-4/14.1 |
| 27A, 27B | THOMAS J. AND RUTH L. ELDER THE BOARD OF EDUCATION OF MARSHALL CO. | P/O 15-5/38 |
| 28 | THE BOARD OF EDUCATION OF MARSHALL CO. | P/O 15-5/43 |
| 29 | BRIAN K. AND MARY LYNN MILLIKEN | 15-5/43.1 |
| 30 | J. L. AND ELIZABETH V. CROW | P/O 15-5/44 |
| 31 | DORCAS DOMAN, FRANCIS E. DOMAN AND JUNE DOMAN | 15-5/48 |

AS-DRILLED
SURFACE HOLE LOCATION (SHL)
UTM 17-NAD83(M)
N:4420609.55
E:538577.49
NAD83, WV NORTH
N:524290.027
E:1674492.151
LAT/LON-NAD83
LAT:39°56'04.997"
LON:80°32'54.565"

AS-DRILLED
APPROX LANDING POINT
UTM 17-NAD83(M)
N:4420892.33
E:539123.15
NAD83, WV NORTH
N:525188.062
E:1676298.226
LAT/LON-NAD83
LAT:39°56'14.079"
LON:80°32'31.513"

AS-DRILLED
BOTTOM HOLE LOCATION (BHL)
UTM 17-NAD83(M)
N:4419437.32
E:540422.57
NAD83, WV NORTH
N:520342.060
E:1680482.379
LAT/LON-NAD83
LAT:39°55'26.666"
LON:80°31'37.088"

PERMITTED
SURFACE HOLE LOCATION (SHL)
UTM 17-NAD83(M)
N:4420609.55
E:538577.49
NAD83, WV NORTH
N:524290.027
E:1674492.151
LAT/LON-NAD83
LAT:39°56'04.997"
LON:80°32'54.565"

PERMITTED
APPROX LANDING POINT
UTM 17-NAD83(M)
N:4420893.74
E:539129.56
NAD83, WV NORTH
N:525192.262
E:1676319.357
LAT/LON-NAD83
LAT:39°56'14.123"
LON:80°32'21.243"

PERMITTED
BOTTOM HOLE LOCATION (BHL)
UTM 17-NAD83(M)
N:4419435.09
E:540419.39
NAD83, WV NORTH
N:520334.930
E:1680471.820
LAT/LON-NAD83
LAT:39°55'26.595"
LON:80°32'37.222"

API WELL #: 47 51 02010
STATE COUNTY PERMIT

THRASHER


ENVIRONMENTAL CONSULTING & FIELD SERVICES
800 WHITE OAKS BOULEVARD, BRIDGEPORT WV 26330
PHONE (304) 624-4108-FAX (304) 624-7831

JULY 22, 2019

RECEIVED
Office of Oil and Gas

AUG 27 2019


WV Department of
Environmental Protection

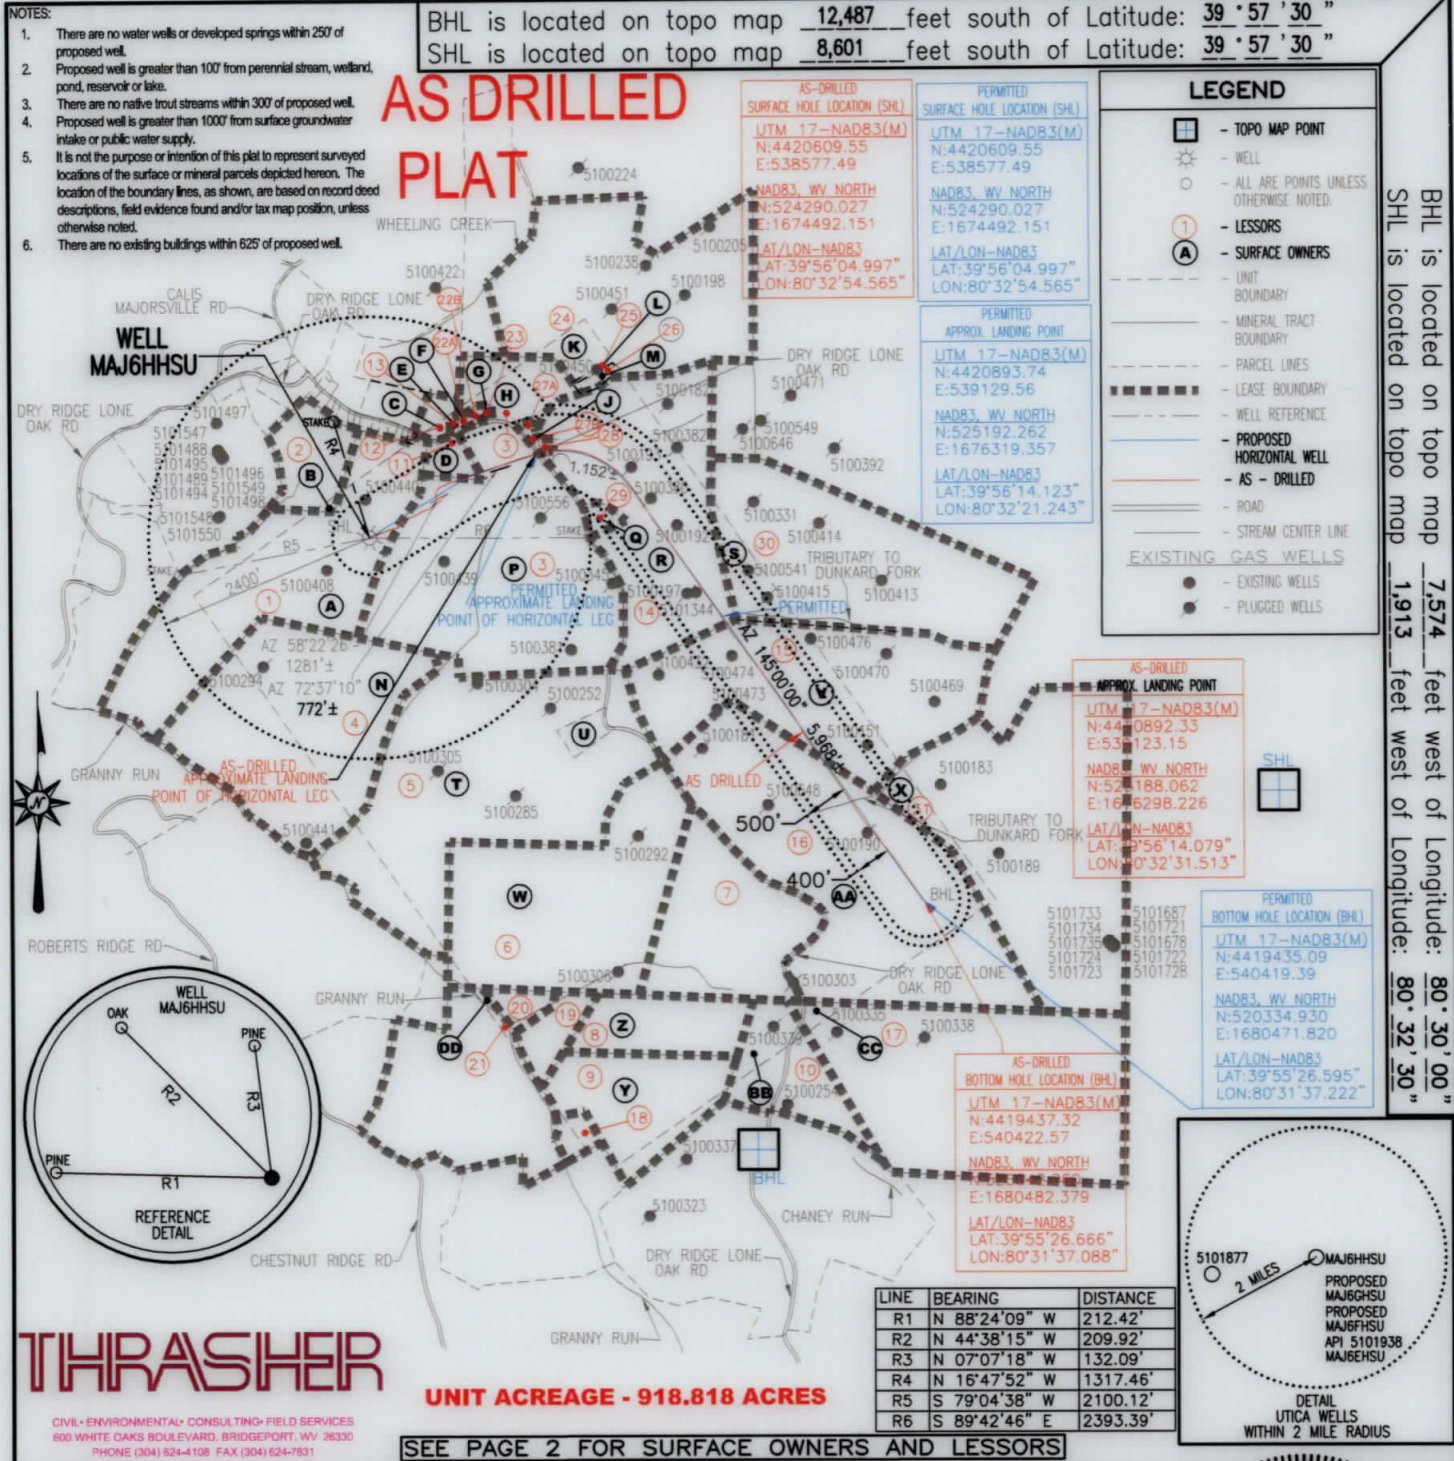

FILE #: MAJ6HHSU-AS DRILLED
 DRAWING #: MAJ6HHSU-AS DRILLED
 SCALE: 1" = 2000'
 MINIMUM DEGREE OF ACCURACY: 1/2500
 PROVEN SOURCE OF ELEVATION: U.S.G.S. MONUMENT THOMAS 1498.81'

I, THE UNDERSIGNED, HEREBY CERTIFY THAT THIS PLAT IS CORRECT TO THE BEST OF MY KNOWLEDGE AND BELIEF AND SHOWS ALL THE INFORMATION REQUIRED BY LAW AND THE REGULATIONS ISSUED AND PRESCRIBED BY THE DEPARTMENT OF ENVIRONMENTAL PROTECTION.

Signed: *George D. Six*
 R.P.E.: _____ L.L.S.: P.S. No. 2000

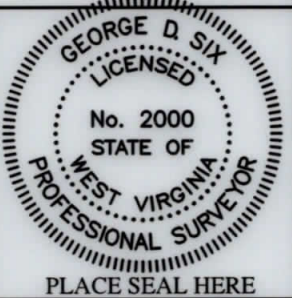

(+) DENOTES LOCATION OF WELL ON UNITED STATES TOPOGRAPHIC MAPS WVDEP
 OFFICE OF OIL & GAS
 601 57TH STREET
 CHARLESTON, WV 25304

DATE: JULY 22, 2019
 OPERATOR'S WELL #: MAJ6HHSU-AS DRILLED
 API WELL #: 47 51 02010
 STATE COUNTY PERMIT

Well Type: Oil Waste Disposal Production Deep Gas Liquid Injection Storage Shallow

WATERSHED: WHEELING CREEK ELEVATION: 1367.87'

COUNTY/DISTRICT: MARSHALL / WEBSTER QUADRANGLE: MAJORSVILLE, WV 7.5'

SURFACE OWNER: CNX LAND, LLC ACREAGE: 95.23±

OIL & GAS ROYALTY OWNER: CNX GAS COMPANY LLC ACREAGE: 1679.35±

DRILL CONVERT DRILL DEEPER REDRILL FRACTURE OR STIMULATE PLUG OFF OLD FORMATION

PERFORATE NEW FORMATION PLUG & ABANDON CLEAN OUT & REPLUG OTHER CHANGE

(SPECIFY): _____

TARGET FORMATION: POINT PLEASANT ESTIMATED DEPTH: TVD: 11,850'± TMD: 18,223'±

WELL OPERATOR: CNX GAS COMPANY LLC DESIGNATED AGENT: CHRIS TURNER
 Address: 1000 CONSOL ENERGY DRIVE Address: 1 DOMINION DRIVE
 City: CANONSBURG State: PA Zip Code: 15317 City: JANE LEW State: WV Zip Code: 26378

MAJ6HHSU

PAGE 2 OF 2

AS DRILLED PLAT

| | SURFACE OWNER | DIST-TM/PAR |
|----|----------------------------------|-------------|
| A | CNX LAND, LLC | 15-5/13 |
| B | CONSOLIDATION COAL COMPANY | 15-5/14 |
| C | ROBERT R. RIGGLE | 15-5/34.1 |
| D | CONSOL MINING COMPANY LLC | 15-5/39 |
| E | ROBERT R. RIGGLE ET UX | 15-5/35 |
| F | MT HOPE CEMETERY ASSOC | 15-5/36 |
| G | MT HOPE CEMETERY | 15-5/37.1 |
| H | ALBERT J. PACZEWSKI JR. ET UX | 15-5/37 |
| J | BOARD OF EDUCATION | 15-5/38 |
| K | DANFORD & DEBORAH A. O'BRIAN | 15-4/14 |
| L | ELIZABETH ANN CAIN - LIFE | 15-4/14.2 |
| M | ELIZABETH ANN CAIN - LIFE | 15-4/14.1 |
| N | CNX LAND, LLC | 15-5/12 |
| P | ALBERT J. PACZEWSKI, JR. ET UX | 15-5/40 |
| Q | BRIAN K. & MARY MILLIKEN TRUST | 15-5/43.1 |
| R | BRIAN K. & MARY MILLIKEN - TRUST | 15-5/43 |
| S | CHARLES ALBERT WITSBERGER II | 15-5/44 |
| T | RANDALL B. SCHMIDT | 15-5/41 |
| U | RANDALL B. SCHMIDT | 15-5/41.1 |
| V | MIKE ROSS INC | 15-5/42 |
| W | RANDALL B. SCHMIDT | 15-11/10 |
| X | TIM M. TURLEY & TAMMY JENKINS | 15-5/48 |
| Y | CNX LAND, LLC | 15-11/12 |
| Z | CNX LAND, LLC | 15-11/11 |
| AA | ROGER D. MCCrackEN ET AL | 15-11/21 |
| BB | MICHAEL S. RIGGLE | 15-11/20 |
| CC | MICHAEL S. RIGGLE | 15-11/19 |
| DD | DAVID L. KINNEY ET AL | 15-11/9 |

| | LESSOR | DIST-TM/PAR |
|----------|---|--------------|
| 1 | ELMER AND OTA HARTLEY | 15-5/13 |
| 2 | HAZEL SAMMONS | P/O 15-5/14 |
| 3 | THOMAS J. AND RUTH ELDER | 15-5/37 |
| | | 15-5/40 |
| 4 | ELLSWORTH H. AND BESSIE E. HARSH | 15-5/12 |
| | MILDRED HARSH | |
| | PAUL HARSH | |
| | CATHERINE H. AND GEORGE E. MCCARRIAN | |
| | SHERE E. AND BARBARA HARSH | |
| | JOHN A. AND LUCILLE HARSH | |
| 5 | SANDRA C. KOONTZ | 15-5/41 |
| | DRY RIDGE RESOURCES, LLC | 15-5/41.1 |
| | MARTHA KAY AND CHARLES D. HILL | |
| 6 | SANDRA C. KOONTZ | 15-11/10 |
| | DRY RIDGE RESOURCES LLC | |
| | MARTHA KAY AND CHARLES D. HILL | |
| 7, 16 | AUGUST W. CHAMBERS, ET AL | P/O 15-11/21 |
| | CHESTNUT HOLDINGS | |
| 8 | MARGARET MORAN | 15-11/11 |
| 9, 18 | MARGARET MORAN | P/O 15-11/12 |
| 19, 20 | | |
| 10 | MICHAEL S. RIGGLE | 15-11/20 |
| 11 | H. B. CHAMBERS | 15-5/39 |
| | AUGUST AND BESSIE CHAMBERS | |
| | GAIL DOLAN | |
| 12 | ROBERT R. AND DONNA S. RIGGLE | 15-5/34.1 |
| 13 | ROBERT R. AND DONNA S. RIGGLE | 15-5/35 |
| 14 | BRIAN K. AND MARY LYNN MILLIKEN | P/O 15-5/43 |
| | JAY K. AND PATRICIA L. WALLACE | |
| | SARA JANE WALLACE | |
| 15 | J. L. AND ELIZABETH V. CROW | 15-5/42 |
| 17 | MICHAEL S. RIGGLE | 15-11/19 |
| 21 | DAVID L. AND RAYMOND P. KINNEY | 15-11/9 |
| 22A, 22B | CAROLL L. COOPER & DALES GITTINGS, CO TRUSTEES OF THE MOUNT HOPE CEMETERY ASSOCIATION | P/O 15-5/36 |
| | VIRGINIA M. BLAKE AND LAURENCE F. PARSONS | |
| 23 | MOUNT HOPE CEMETERY ASSOCIATION | 15-5/37.1 |
| 24 | ELLSWORTH H. AND THELMA L. SCHERICH | 15-4/14 |
| | JACKIE L. FRYE | |
| | RICHARD P. AND MARY LEE BARTO | |
| | SCOTT DOUGLAS REED | |
| | ROBERT B. ELLIOTT | |
| | TIERRA OIL COMPANY | |
| 25 | JACKIE L. FRYE | 15-4/14.2 |
| | RICHARD P. AND MARY LEE BARTO | |
| | SCOTT DOUGLAS REED | |
| | ROBERT B. ELLIOTT | |
| | TIERRA OIL COMPANY | |
| | ELIZABETH ANN CAIN(LIFE TENANT) AND JACK A. AND NANCY C. CAIN(REMAINDERMEN) | |
| 26 | JACKIE L. FRYE | 15-4/14.1 |
| | RICHARD P. AND MARY LEE BARTO | |
| | SCOTT DOUGLAS REED | |
| | ROBERT B. ELLIOTT | |
| | TIERRA OIL COMPANY | |
| | ELIZABETH ANN CAIN(LIFE TENANT) AND JACK A. AND NANCY C. CAIN(REMAINDERMEN) | |
| 27A, 27B | THOMAS J. AND RUTH L. ELDER | P/O 15-5/38 |
| | THE BOARD OF EDUCATION OF MARSHALL CO. | |
| 28 | THE BOARD OF EDUCATION OF MARSHALL CO. | P/O 15-5/43 |
| 29 | BRIAN K. AND MARY LYNN MILLIKEN | 15-5/43.1 |
| 30 | J. L. AND ELIZABETH V. CROW | P/O 15-5/44 |
| 31 | DORCAS DOMAN, FRANCIS E. DOMAN AND JUNE DOMAN | 15-5/48 |

AS-DRILLED
SURFACE HOLE LOCATION (SHL)
UTM 17-NAD83(M)
N:4420609.55
E:538577.49
NAD83, WV NORTH
N:524290.027
E:1674492.151
LAT/LON-NAD83
LAT:39°56'04.997"
LON:80°32'54.565"

AS-DRILLED
APPROX. LANDING POINT
UTM 17-NAD83(M)
N:4420892.33
E:539123.15
NAD83, WV NORTH
N:525188.062
E:1676298.226
LAT/LON-NAD83
LAT:39°56'14.079"
LON:80°32'31.513"

AS-DRILLED
BOTTOM HOLE LOCATION (BHL)
UTM 17-NAD83(M)
N:4419437.32
E:540422.57
NAD83, WV NORTH
N:520342.060
E:1680482.379
LAT/LON-NAD83
LAT:39°55'26.666"
LON:80°31'37.088"

PERMITTED
SURFACE HOLE LOCATION (SHL)
UTM 17-NAD83(M)
N:4420609.55
E:538577.49
NAD83, WV NORTH
N:524290.027
E:1674492.151
LAT/LON-NAD83
LAT:39°56'04.997"
LON:80°32'54.565"

PERMITTED
APPROX. LANDING POINT
UTM 17-NAD83(M)
N:4420893.74
E:539129.56
NAD83, WV NORTH
N:525192.262
E:1676319.357
LAT/LON-NAD83
LAT:39°56'14.123"
LON:80°32'21.243"

PERMITTED
BOTTOM HOLE LOCATION (BHL)
UTM 17-NAD83(M)
N:4419435.09
E:540419.39
NAD83, WV NORTH
N:520334.930
E:1680471.820
LAT/LON-NAD83
LAT:39°55'26.595"
LON:80°32'37.222"

API WELL #: 47 51 02010
STATE COUNTY PERMIT

THRASHER

CIVIL • ENVIRONMENTAL • CONSULTING • FIELD SERVICES
600 WHITE OAKS BOULEVARD, BRIDGEPORT, WV 26330
PHONE (304) 624-4108 • FAX (304) 624-7831

JULY 22, 2019