WW-7	
8-30-06	



	ent of Environmental Protection of Oil and Gas
	ATION FORM: GPS
API: 4705102068	WELL NO .: MAJ10AHSU
FARM NAME: CNX Gas Con	
RESPONSIBLE PARTY NAME: C	
COUNTY: Marshall	
QUADRANGLE: Majorsville	
SURFACE OWNER: CNX Gas	Company
ROYALTY OWNER: CNX Gas	
UTM GPS NORTHING: 4418815	
UTM GPS EASTING: 539556.60	O GPS ELEVATION: 1317'
A second s	

The Responsible Party named above has chosen to submit GPS coordinates in lieu of preparing a new well location plat for a plugging permit or assigned API number on the above well. The Office of Oil and Gas will not accept GPS coordinates that do not meet the following requirements:

- Datum: NAD 1983, Zone: 17 North, Coordinate Units: meters, Altitude: height above mean sea level (MSL) – meters.
- 2. Accuracy to Datum 3.05 meters
- 3. Data Collection Method:

Survey grade GPS X : Post Processed Differential

Real-Time Differential X

Mapping Grade GPS ____: Post Processed Differential

Real-Time Differential

RECEIVED e of Oil and Gas 2027 WV Department of ronmental Protection


4. Letter size copy of the topography map showing the well location.

I the undersigned, hereby certify this data is correct to the best of my knowledge and belief and shows all the information required by law and the regulations issued and prescribed by the Office of Oil and Gas.

LOJON MANAGER Signature

4-1-22 Date 04/15/2022

4705102068P

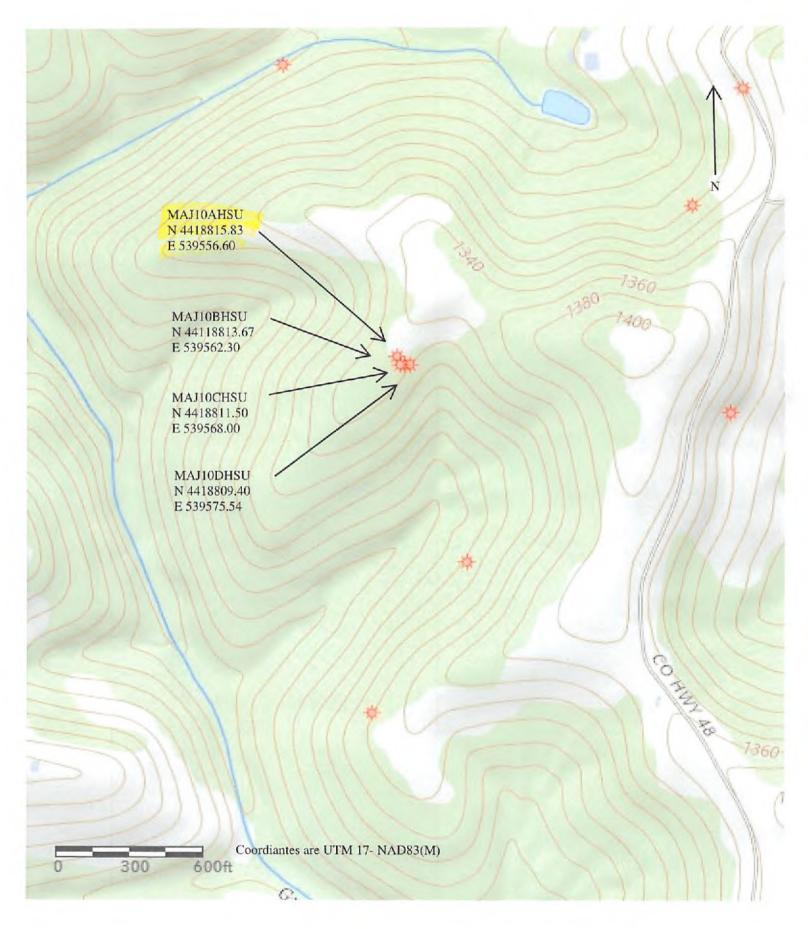

04/15/2022