


ADJOINING OWNERS TABLE		
TRACT	SURFACE OWNER	TAX PARCEL
A	CRAIG NORDBERG & CAROL NORDBERG	12-05-01
B	PHILLIP WILEY	12-04-09
C	MASON DIXON FARMS, LLC	09-21-11
D	ANORAH C. SCHOSTAG & RYAN U. SCHOSTAG	09-21-10.1
E	SARAH V. RICHMOND	12-04-08
F	RHODA C. SIVERT & CLEO M. SIVERT	12-04-07
G	KIMBERLY C. HOFFMAN & PAUL G. FOX	09-21-21
H	ELEANOR T. MILLER & JAMES B. MILLER	09-20-16
I	DAVID PAUL WEIGAND	09-20-15
J	DAVID P. WEIGAND	09-20-17.5
K	DAVID PAUL WEIGAND	09-20-09
L	ELEANOR T. MILLER & JAMES B. MILLER	09-20-08
M	JOHN G. WEIGAND JR. & MARILYN S. WEIGAND	09-20-12.2
N	ELEANOR T. MILLER & JAMES B. MILLER	09-20-9.2
O	ELEANOR T. MILLER & JAMES B. MILLER	09-20-9.1
P	JAMES MILLER, ET UX	09-20-9.6
Q	JAMES MILLER, ET UX	09-20-9.5
R	DAVID PAUL FROHNAPFEL	09-20-7.1
S	ZACHARY M. BLAIR	09-21-04
T	ZACHARY M. BLAIR	09-21-16
U	ZACHARY M. BLAIR	09-21-17
V	ZACHARY M. BLAIR	09-21-14
W	MASON DIXON FARMS, LLC	09-21-22

REVISIONS:	COMPANY:						
							
	OPERATOR'S	ARTHUR WARYCK MSH	API #		DATE: 03-24-2020		
	WELL #:	401H	47-051-02172		DRAWN BY: N. MANO		
DISTRICT:	MEADE	COUNTY:	MARSHALL	STATE:	WV	SCALE:	N/A
						DRAWING NO:	WELL LOCATION PLAT 2

**JACKSON SURVEYING
INC.**
2413 EAST PIKE ST. # 112
Clarksburg, WV 26301
304-623-5851

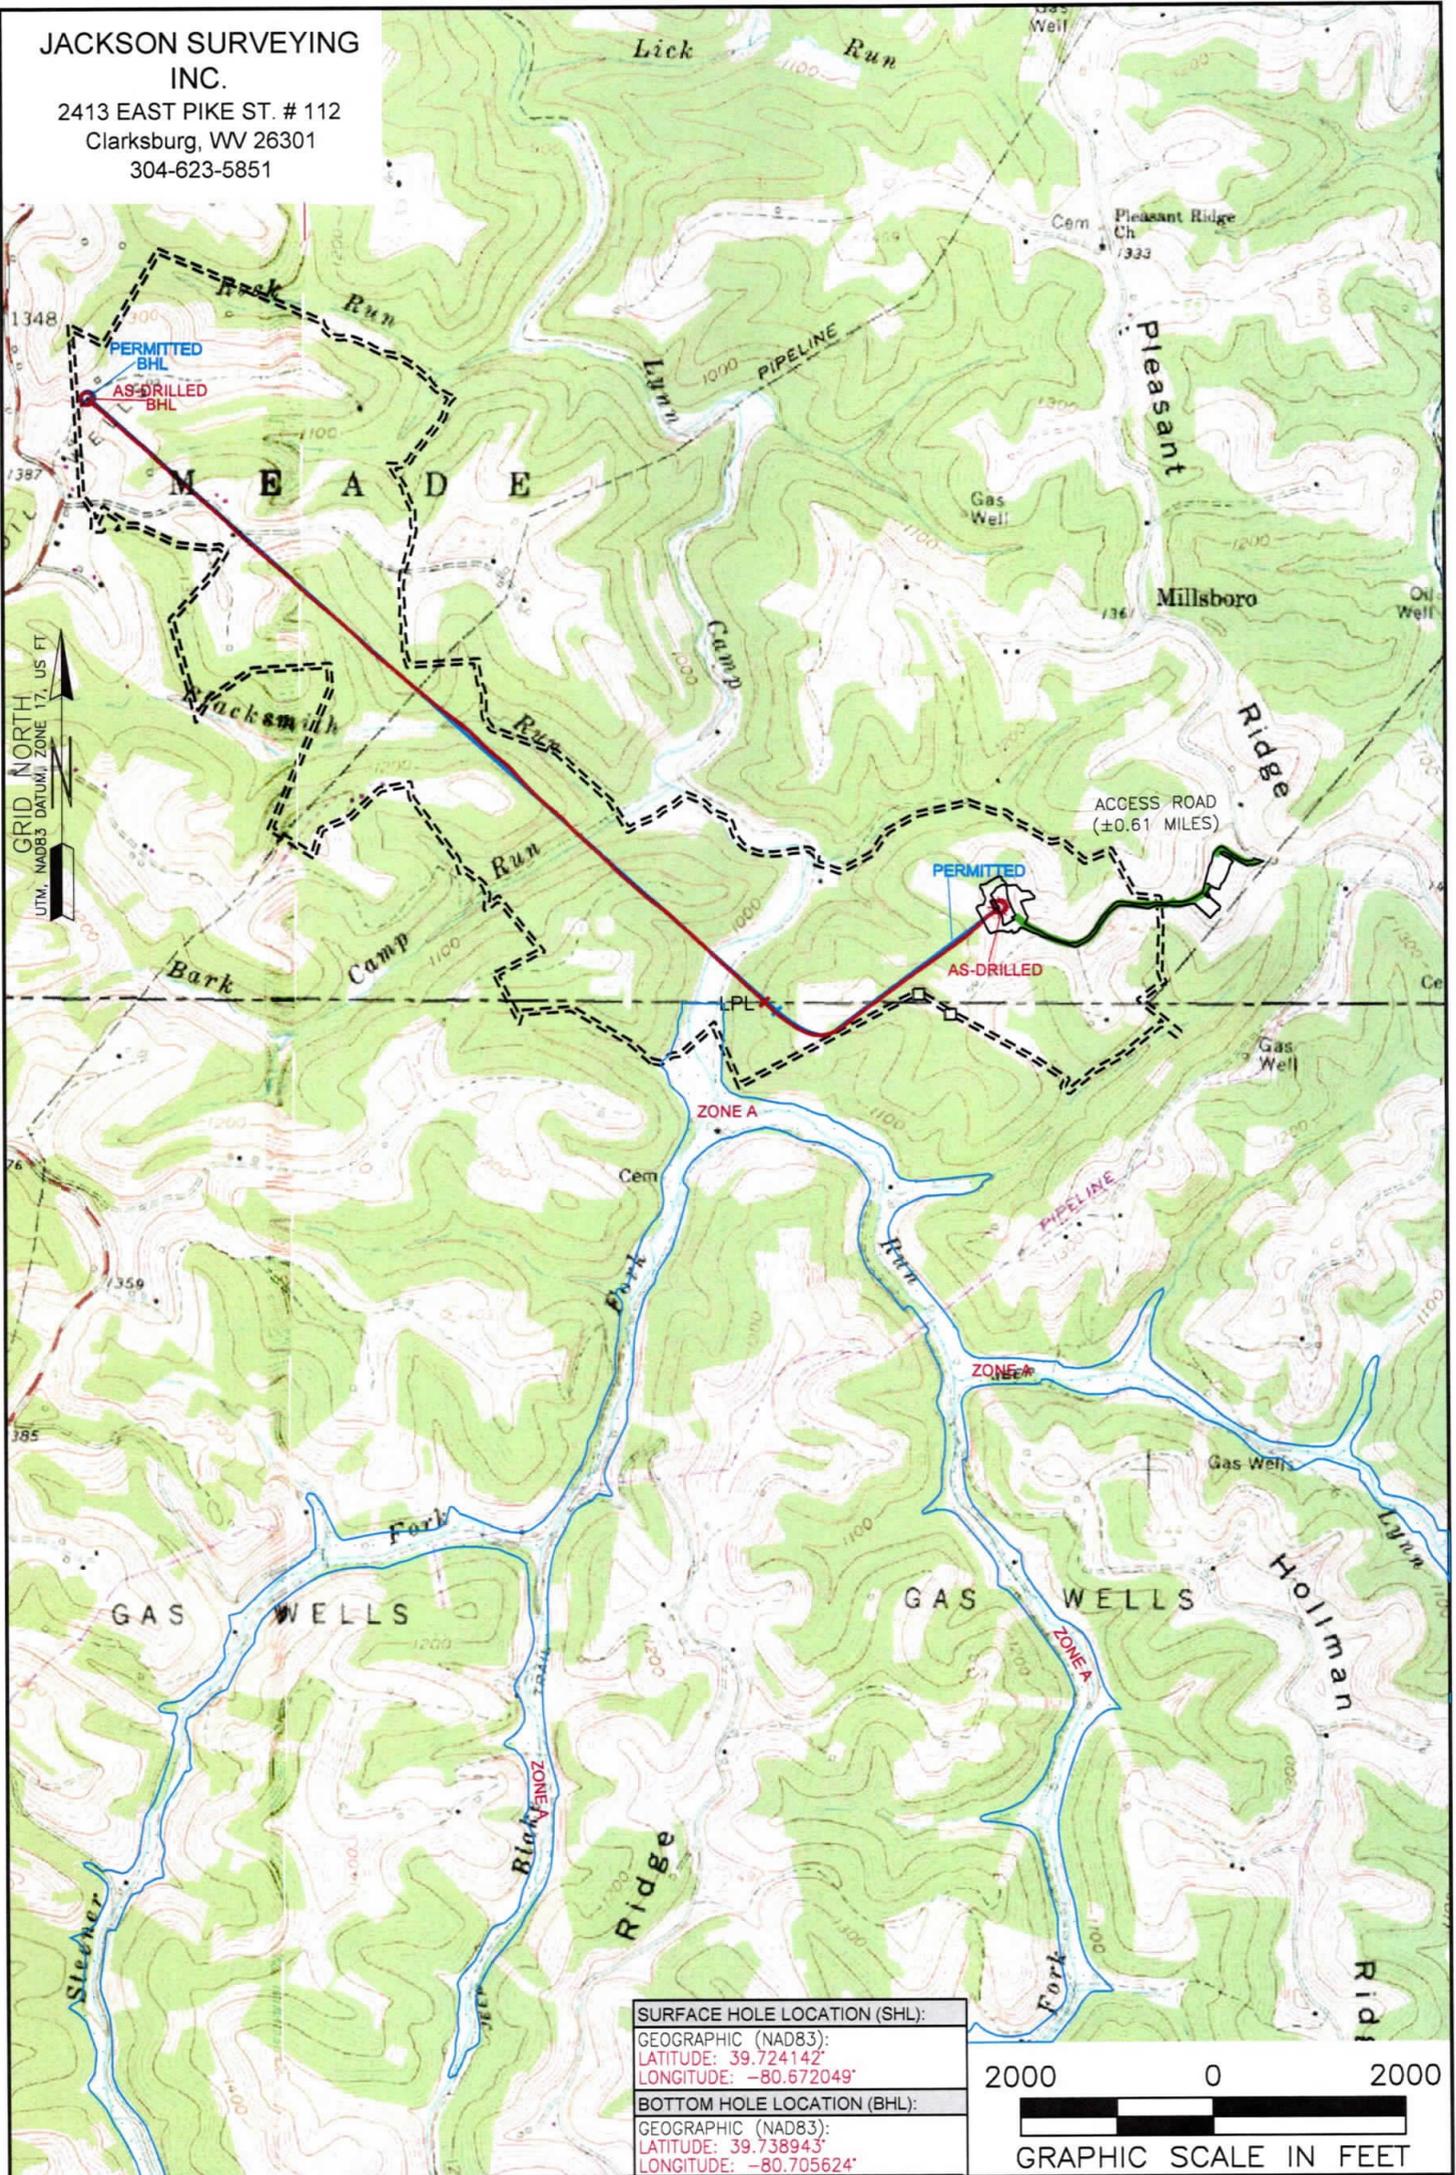

SURFACE HOLE LOCATION (SHL):
GEOGRAPHIC (NAD83):
LATITUDE: 39.724142°
LONGITUDE: -80.672049°
BOTTOM HOLE LOCATION (BHL):
GEOGRAPHIC (NAD83):
LATITUDE: 39.738943°
LONGITUDE: -80.705624°



NOTES ON SURVEY

1. SURFACE AND ROYALTY OWNER INFORMATION AND THEIR BOUNDARIES SHOWN HEREON WERE PLOTTED FROM DEEDS AND/OR TAX PARCEL MAPS PROVIDED BY CLIENT AND/OR FIELD LOCATIONS.
2. THIS PLAT DOES NOT REPRESENT A BOUNDARY SURVEY OF THE PARCELS SHOWN HEREON.
4. ALL INSETS ARE GRID NORTH UNLESS OTHERWISE DEPICTED.

LEGEND:

- PROPOSED SURFACE HOLE / BOTTOM HOLE
- ★ EXISTING / PRODUCING WELLHEAD
- LPL★ LANDING POINT LOCATION
- FLOOD PLAIN
- ACCESS ROAD
- PUBLIC ROAD
- ACCESS ROAD TO PREV. SITE
- LEASE BOUNDARY
- PROPOSED PATH

WELL OPERATOR: SWN PRODUCTION COMPANY, LLC	WELL (FARM) NAME: ARTHUR WARYCK MSH	WELL # 401H	SERIAL #
ADDRESS: 1300 FORT PIERPONT ROAD, SUITE 200	COUNTY - CODE MARSHALL - 051	DISTRICT; MEADE	
SURFACE OWNER: A. MICHAEL WARYCK & DEBORAH ELLEN WARYCK	USGS 7 1/2 QUADRANGLE MAP NAME WILEYVILLE, WV	API # 47-051-02172	