

WW-7
8-30-06



West Virginia Department of Environmental Protection
Office of Oil and Gas

WELL LOCATION FORM: GPS

API: 47-051-02314 WELL NO.: M-1514
 FARM NAME: T. C. PIPES
 RESPONSIBLE PARTY NAME: CONSOLIDATION COAL COMPANY
 COUNTY: MARSHALL DISTRICT: LIBERTY
 QUADRANGLE: CAMERON WV, PA
 SURFACE OWNER: Randy Ross
 ROYALTY OWNER: _____
 UTM GPS NORTHING: 4,407,794 m
 UTM GPS EASTING: 539,726 m GPS ELEVATION: 373 m (1223')

The Responsible Party named above has chosen to submit GPS coordinates in lieu of preparing a new well location plat for a plugging permit or assigned API number on the above well. The Office of Oil and Gas will not accept GPS coordinates that do not meet the following requirements:

1. Datum: NAD 1983, Zone: 17 North, Coordinate Units: meters, Altitude: height above mean sea level (MSL) – meters.
2. Accuracy to Datum – 3.05 meters
3. Data Collection Method:

Survey grade GPS : Post Processed Differential _____
 Real-Time Differential

Mapping Grade GPS _____ : Post Processed Differential _____
 Real-Time Differential _____

RECEIVED
Office of Oil and Gas

JAN 21 2022

WV Department of
Environmental Protection

4. **Letter size copy of the topography map showing the well location.**

I the undersigned, hereby certify this data is correct to the best of my knowledge and belief and shows all the information required by law and the regulations issued and prescribed by the Office of Oil and Gas.

Signature


Professional Surveyor

JANUARY 30, 2020

Title

Date

04/08/2022

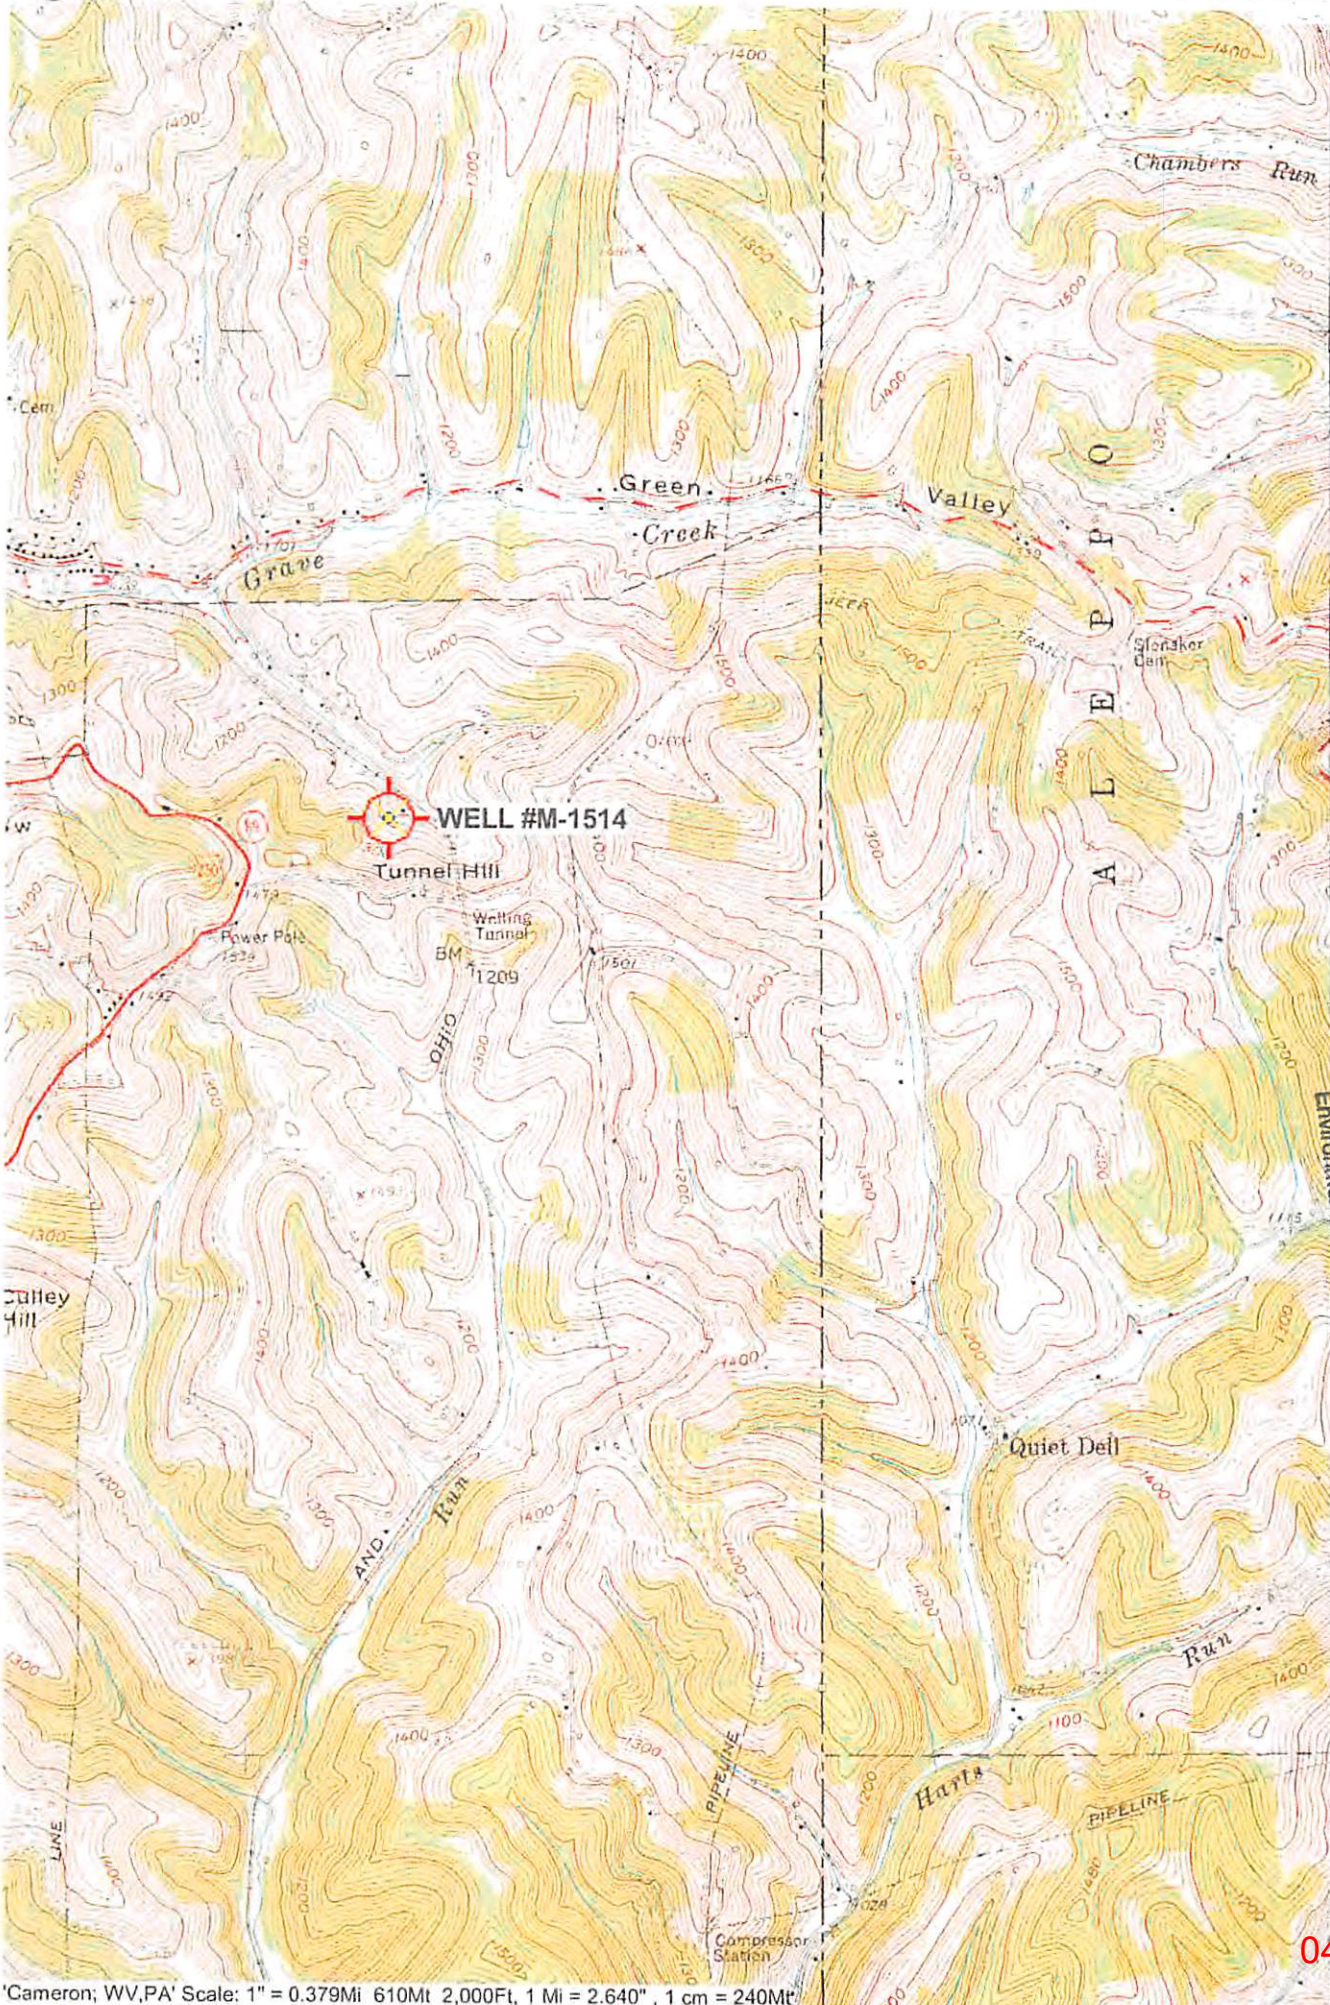

MS A 1966
1:50,000
Environmental Protection

RECEIVED
Office of Oil and Gas
JAN 21 2022

WV Department of
Environmental Protection

Office of Oil and Gas
JAN 21 2022

04/08/2022