

WW-7
8-30-06



West Virginia Department of Environmental Protection
Office of Oil and Gas
WELL LOCATION FORM: GPS

API: 47-051-02321 WELL NO.: M-1612

FARM NAME: AUGUST WENDT

RESPONSIBLE PARTY NAME: CONSOLIDATION COAL COMPANY

COUNTY: MARSHALL DISTRICT: LIBERTY

QUADRANGLE: CAMERON WV, PA

SURFACE OWNER: JOHN D. CUMPSTON ET UX.

ROYALTY OWNER: _____

UTM GPS NORTHING: 4,406,833 m

UTM GPS EASTING: 539,899 m GPS ELEVATION: 363 m (1191')

The Responsible Party named above has chosen to submit GPS coordinates in lieu of preparing a new well location plat for a plugging permit or assigned API number on the above well. The Office of Oil and Gas will not accept GPS coordinates that do not meet the following requirements:

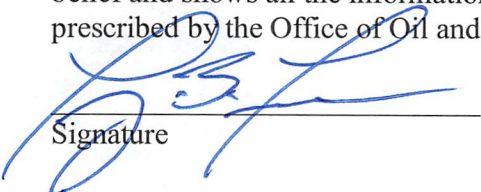
- Datum: NAD 1983, Zone: 17 North, Coordinate Units: meters, Altitude: height above mean sea level (MSL) – meters.
- Accuracy to Datum – 3.05 meters
- Data Collection Method:

Survey grade GPS : Post Processed Differential _____
Real-Time Differential

Mapping Grade GPS _____ : Post Processed Differential _____
Real-Time Differential _____

4. Letter size copy of the topography map showing the well location.

I the undersigned, hereby certify this data is correct to the best of my knowledge and belief and shows all the information required by law and the regulations issued and prescribed by the Office of Oil and Gas.

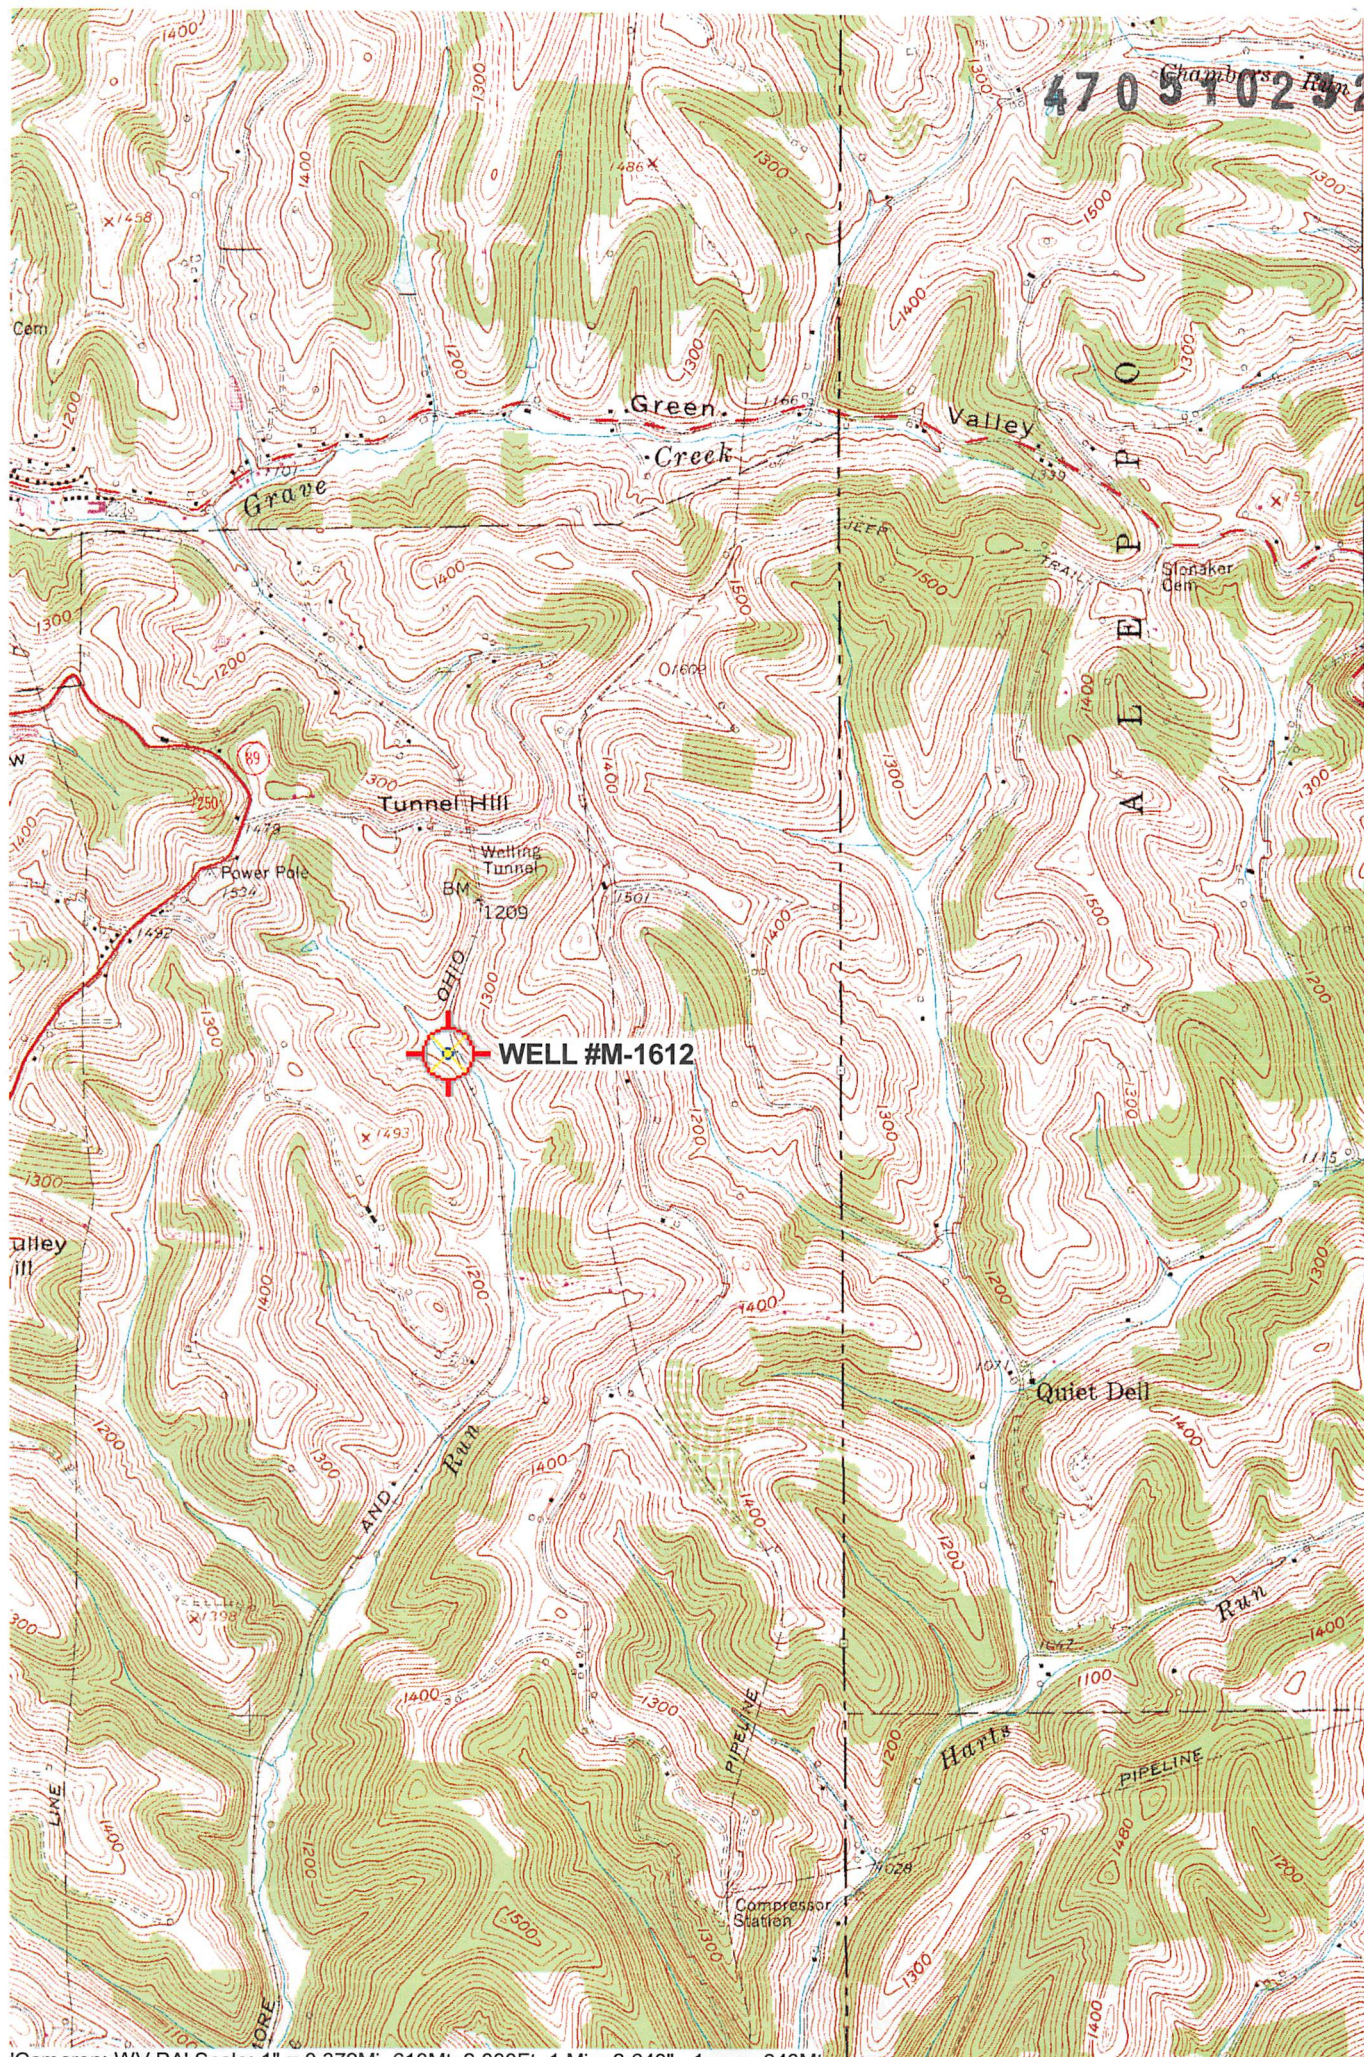

Signature

Professional Surveyor
Title

FEBRUARY 4, 2020
Date

RECEIVED
Office of Oil and Gas
FEB 18 2020
WV Department of
Environmental Protection

4705102921P



50'
4409
4408
4406
4405
47'30"
4404

(NEW FREEPORT)
4963 IV SW

9.2 MI. TO PA. 18

RECEIVED
Office of Oil and Gas
FEB 18 2020
WV Department of
Environmental Protection