


**KEITH STERN N LEASE
WELL 5HM
TUG HILL OPERATING**

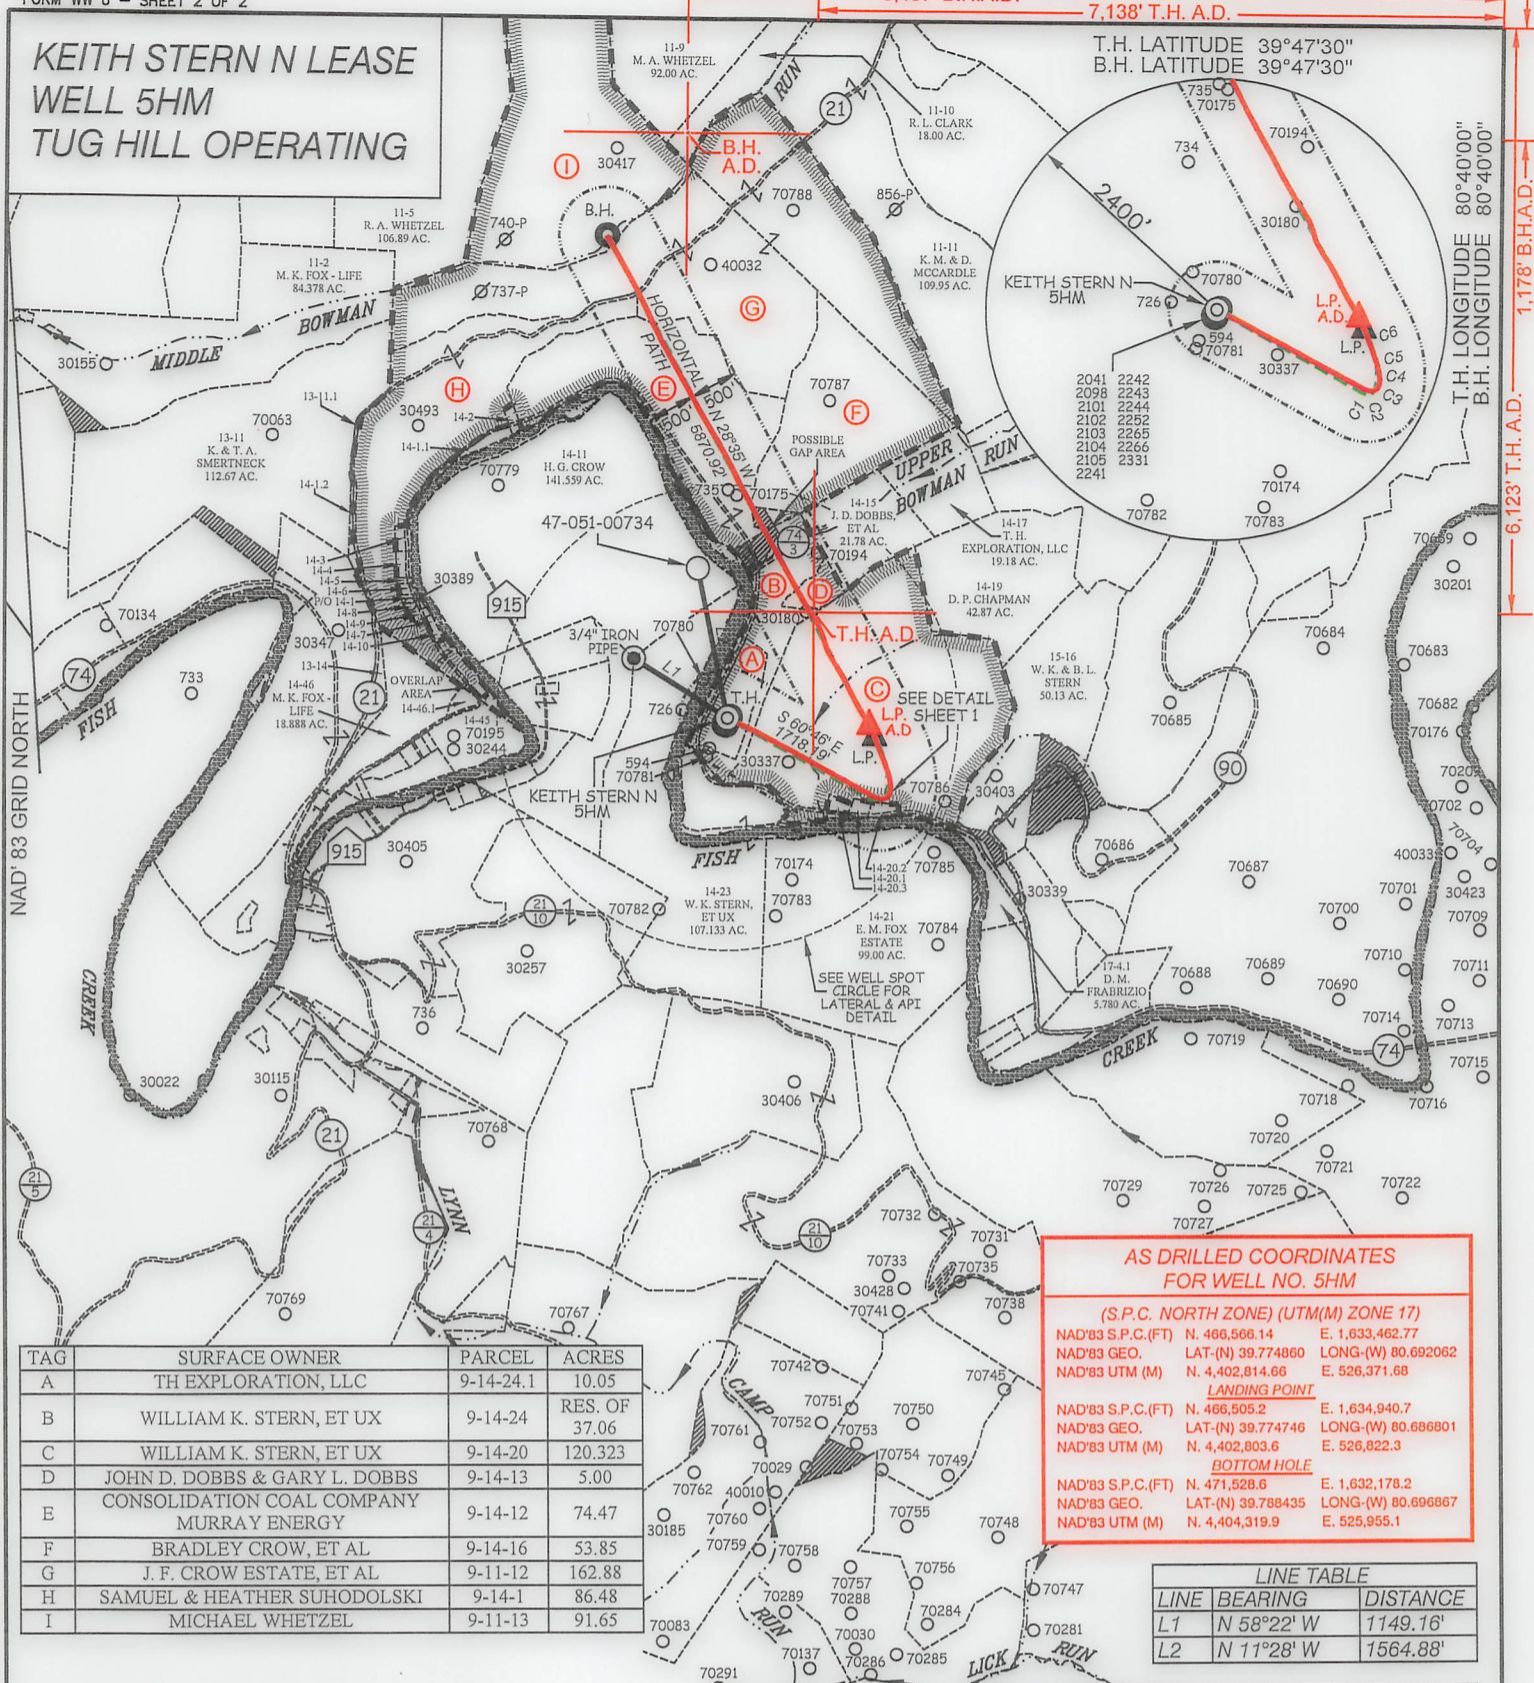

AS DRILLED COORDINATES FOR WELL NO. 5HM

(S.P.C. NORTH ZONE) (UTM(M) ZONE 17)

NAD'83 S.P.C.(FT)	N. 466,566.14	E. 1,633,462.77
NAD'83 GEO.	LAT-(N) 39.774860	LONG-(W) 80.692062
NAD'83 UTM (M)	N. 4,402,814.66	E. 526,371.68

LANDING POINT

NAD'83 S.P.C.(FT)	N. 466,505.2	E. 1,634,940.7
NAD'83 GEO.	LAT-(N) 39.774746	LONG-(W) 80.686801
NAD'83 UTM (M)	N. 4,402,803.6	E. 526,822.3

BOTTOM HOLE

NAD'83 S.P.C.(FT)	N. 471,528.6	E. 1,632,178.2
NAD'83 GEO.	LAT-(N) 39.788435	LONG-(W) 80.696887
NAD'83 UTM (M)	N. 4,404,319.9	E. 525,955.1

TAG	SURFACE OWNER	PARCEL	ACRES
A	TH EXPLORATION, LLC	9-14-24.1	10.05
B	WILLIAM K. STERN, ET UX	9-14-24	RES. OF 37.06
C	WILLIAM K. STERN, ET UX	9-14-20	120.323
D	JOHN D. DOBBS & GARY L. DOBBS	9-14-13	5.00
E	CONSOLIDATION COAL COMPANY MURRAY ENERGY	9-14-12	74.47
F	BRADLEY CROW, ET AL	9-14-16	53.85
G	J. F. CROW ESTATE, ET AL	9-11-12	162.88
H	SAMUEL & HEATHER SUHODOLSKI	9-14-1	86.48
I	MICHAEL WHETZEL	9-11-13	91.65

LINE TABLE

LINE	BEARING	DISTANCE
L1	N 58°22' W	1149.16'
L2	N 11°28' W	1564.88'

CURVE TABLE

CURVE	ARC LENGTH	RADIUS	CHORD BEARING	CHORD LENGTH
C1	63.27'	222.02'	S 66°29' E	63.06'
C2	80.92'	76.90'	N 73°46' E	77.24'
C3	82.04'	170.03'	N 24°43' E	81.24'
C4	184.74'	614.02'	N 01°08' E	184.04'
C5	178.72'	888.12'	N 12°39' W	178.42'
C6	243.36'	1384.25'	N 23°28' W	243.05'



12 Vanhorn Drive | P.O. Box 150 | Glenville, WV 26351 | 304.462.5634
 1412 Kanawha Boulevard, East | Charleston, WV 25301 | 304.346.3952
 254 East Beckley Bypass | Beckley, WV 25801 | 304.255.5296
 slswv.com

LEGEND

AS DRILLED ———

PROPOSED - - - - -

(S.P.C. NORTH ZONE) (UTM(M) ZONE 17)

NAD'83 S.P.C.(FT)	N. 466,566.14	E. 1,633,462.77
NAD'83 GEO.	LAT-(N) 39.774860	LONG-(W) 80.692062
NAD'83 UTM (M)	N. 4,402,814.66	E. 526,371.68

LANDING POINT

NAD'83 S.P.C.(FT)	N. 466,378.1	E. 1,634,995.8
NAD'83 GEO.	LAT-(N) 39.774399	LONG-(W) 80.686599
NAD'83 UTM (M)	N. 4,402,765.2	E. 526,839.7

BOTTOM HOLE

NAD'83 S.P.C.(FT)	N. 471,533.5	E. 1,632,186.9
NAD'83 GEO.	LAT-(N) 39.788449	LONG-(W) 80.696836
NAD'83 UTM (M)	N. 4,404,321.5	E. 525,957.7



(+) DENOTES LOCATION OF WELL ON UNITED STATES TOPOGRAPHIC MAPS.

P.S. 677 *Gregory A. Smith*

LEGEND

LEASE LINE

SURFACE LINE

WELL LATERAL

OFFSET LINE

TIE LINE

CREEK

ROAD

COUNTY ROUTE

PROPOSED WELL ⊙

EXISTING WELL ⊙

PERMITTED WELL ⊙

TAX MAP-PARCEL 00-00

LEASE # (SEE WW-6A1) A

SURFACE OWNER (SEE TABLE)

SCALE **1" = 2000'** FILE NO. **8811P5HMR -AD.dwg**
 KEITH STERN N-5HM-REV1

DATE **FEBRUARY 15**, 20 **23**

REVISED _____, 20 _____

OPERATORS WELL NO. **KEITH STERN N-5HM**

API WELL NO. **47 - 051 - 02376**

NO. STATE COUNTY PERMIT

STATE OF WEST VIRGINIA
 DIVISION OF ENVIRONMENTAL PROTECTION
 OFFICE OF OIL AND GAS

WELL OPERATOR **TUG HILL OPERATING, LLC** ADDRESS **1320 SOUTH UNIVERSITY DRIVE, SUITE 500 FORT WORTH, TX 76107**

DESIGNATED AGENT **DARREN BROWN - CT CORPORATION** ADDRESS **5098 WASHINGTON ST. W, STE 407 CHARLESTON, WV 25313-1561**

**KEITH STERN N LEASE
WELL 5HM
TUG HILL OPERATING**

8,487' B.H. A.D. 7,138' T.H. A.D.

T.H. LATITUDE 39°47'30"
B.H. LATITUDE 39°47'30"

B.H. A.D.


(S.P.C. NORTH ZONE) (UTM(M) ZONE 17)		
NAD'83 S.P.C.(FT)	N. 466,566.14	E. 1,633,462.77
NAD'83 GEO.	LAT-(N) 39.774860	LONG-(W) 80.692062
NAD'83 UTM (M)	N. 4,402,814.66	E. 526,371.68
LANDING POINT		
NAD'83 S.P.C.(FT)	N. 466,378.1	E. 1,634,995.8
NAD'83 GEO.	LAT-(N) 39.774399	LONG-(W) 80.686599
NAD'83 UTM (M)	N. 4,402,765.2	E. 526,839.7
BOTTOM HOLE		
NAD'83 S.P.C.(FT)	N. 471,533.5	E. 1,632,186.9
NAD'83 GEO.	LAT-(N) 39.788449	LONG-(W) 80.696836
NAD'83 UTM (M)	N. 4,404,321.5	E. 525,957.7

T.H. LONGITUDE 80°40'00"
B.H. LONGITUDE 80°40'00"
1,178' B.H.A.D.
6,123' T.H. A.D.


MAP/PARCEL	ADJOINING SURFACE OWNER LIST	ACRES
9-13-11.1	SAMUEL & HEATHER SUHODOLSKI	0.49
9-13-14	MARGARET K. FOX - LIFE	3.00
9-14-1.1	MICHAEL L. ALVAREZ	1.6
9-14-1.2	KENNETH N. & TERESA A. SMERTNECK	1.02
9-14-2	MICHAEL L. ALVAREZ	0.75
9-14-3	MICHAEL L. ALVAREZ	NORTH P/O 3 PCLS
9-14-4	MICHAEL L. ALVAREZ	3 PCLS & 1/8 AC.
9-14-5	MICHAEL L. ALVAREZ	200 X 60 PCL
9-14-6	MICHAEL L. ALVAREZ	120 X 200 PCL
9-14-7	JOHN T. ERAZMUS, III	0.25
9-14-8	JOHNNY C. HOLCOMB & JOHNNY C. HOLCOMB, II	2/5 AC.
9-14-9	JOHN E. DUFFY, ET UX	2/5 AC.
9-14-10	ROBERT I. DUFFY - LIFE	25/100 AC.
9-14-20.1	WILLIAM K. STERN, ET UX	1.321
9-14-20.2	WILLIAM K. STERN, ET UX	1.525
9-14-20.3	WILLIAM K. STERN, ET UX	0.831
9-14-45	GEORGE R. TAYLOR, ET UX	10.98
9-14-46.1	MARHA JANE FAZZARO	1.512

T.H. A.D.

REFERENCES

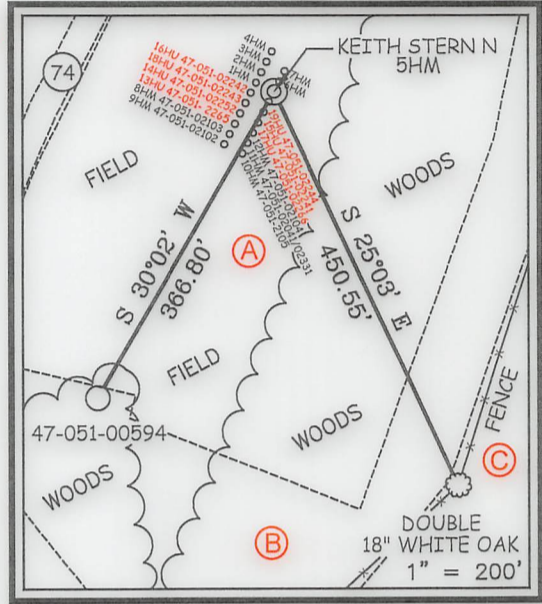

DETAIL SCALE: 1" = 50'

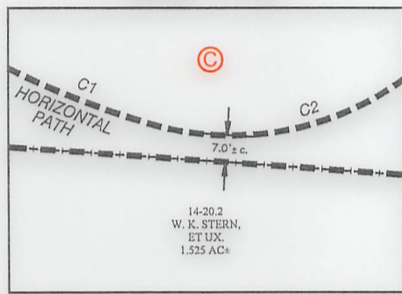

NOTES ON SURVEY

- NO WATER WELLS WERE FOUND WITHIN 250' OF PROPOSED GAS WELL. NO AGRICULTURAL BUILDINGS OR DWELLINGS > 2500 SQ. FT. WERE FOUND WITHIN 625' OF THE CENTER OF PROPOSED WELL PAD.
- WELL SPOT CIRCLE & TOPO MARK SCALE IS 1"=2000'.
- BASED ON WV DOT COUNTY ROUTE 74 IS A 40' STRIP OF LAND ACQUIRED IN NUMEROUS DEEDS.
- PLAT UPDATED TO SHOW AS-DRILLED PATH.
- AS DRILLED DATA PROVIDED BY TUG HILL OPERATING.



12 Vanhorn Drive | P.O. Box 150 | Glenville, WV 26351 | 304.462.5634
1412 Kanawha Boulevard, East | Charleston, WV 25301 | 304.346.3952
254 East Beckley Bypass | Beckley, WV 25801 | 304.255.5296
slsvv.com

I THE UNDERSIGNED, HEREBY CERTIFY THAT THIS PLAT IS CORRECT TO THE BEST OF MY KNOWLEDGE AND BELIEF AND SHOWS ALL THE INFORMATION REQUIRED BY LAW AND THE REGULATIONS ISSUED AND PRESCRIBED BY THE DIVISION OF ENVIRONMENTAL PROTECTION.

P.S. 677 *Gregory A. Smith*



(+) DENOTES LOCATION OF WELL ON UNITED STATES TOPOGRAPHIC MAPS.
DATE FEBRUARY 15, 20 23
REVISED _____, 20 ____
OPERATORS WELL NO. KEITH STERN N-5HM
API WELL NO. 47 - 051 - 02376
STATE COUNTY PERMIT

MINIMUM DEGREE OF ACCURACY 1 / 2500 FILE NO. 8811P5HMR -AD.dwg KEITH STERN N-5HM-REV1
HORIZONTAL & VERTICAL CONTROL DETERMINED BY DGPS (SURVEY GRADE TIE TO CORS NETWORK) SCALE 1" = 2000'

STATE OF WEST VIRGINIA
DIVISION OF ENVIRONMENTAL PROTECTION
OFFICE OF OIL AND GAS



WELL TYPE: OIL ___ GAS X INJECTION ___ WASTE DISPOSAL ___ IF "GAS" PRODUCTION X STORAGE ___ DEEP ___ SHALLOW X
LOCATION: GROUND = 745.30' ELEVATION PROPOSED = 744.65' WATERSHED FISH CREEK (HUC 10)
DISTRICT MEADE COUNTY MARSHALL QUADRANGLE GLEN EASTON 7.5'
SURFACE OWNER TH EXPLORATION, LLC ACREAGE 10.05±
ROYALTY OWNER ISAAC CROW, ET AL - SEE WW-6A1 ACREAGE 10.05±
PROPOSED WORK: DRILL X CONVERT ___ DRILL DEEPER ___ REDRILL ___ FRACTURE OR STIMULATE X PLUG OFF OLD FORMATION ___ PERFORATE NEW FORMATION ___ PLUG AND ABANDON ___ CLEAN OUT AND REPLUG ___ OTHER ___
PHYSICAL CHANGE IN WELL (SPECIFY) TARGET FORMATION MARCELLUS ESTIMATED DEPTH TVD: 6,410' / TMD: 12,919'

WELL OPERATOR TUG HILL OPERATING, LLC DESIGNATED AGENT DARREN BROWN - CT CORPORATION
ADDRESS 1320 SOUTH UNIVERSITY DRIVE, SUITE 500 FORT WORTH, TX 76107 ADDRESS 5098 WASHINGTON ST. W, STE 407 CHARLESTON, WV 25313-1561

COUNTY NAME PERMIT

10/27/2023