

**WILLETT S LEASE
6HM
EQT PRODUCTION CO.**

T.H. LATITUDE 39°50'00"
B.H. LATITUDE 39°50'00"

(S.P.C. NORTH ZONE) (UTM(M) ZONE 17 NORTH)

NAD'83 S.P.C.(FT) N. 483,982.78 E. 1,643,775.37
NAD'83 GEO. LAT-(N) 39.823040 LONG-(W) 80.656171
NAD'83 UTM (M) N. 4,408,173.24 E. 529,424.80

LANDING POINT

NAD'83 S.P.C.(FT) N. 484,008.5 E. 1,646,662.7
NAD'83 GEO. LAT-(N) 39.823212 LONG-(W) 80.645893
NAD'83 UTM (M) N. 4,408,195.8 E. 530,304.3

BOTTOM HOLE

NAD'83 S.P.C.(FT) N. 473,220.8 E. 1,652,781.5
NAD'83 GEO. LAT-(N) 39.793811 LONG-(W) 80.623629
NAD'83 UTM (M) N. 4,404,940.4 E. 532,223.4


T.H. LONGITUDE 80°37'30"
B.H. LONGITUDE 80°35'00"

A.D.
T.H.

TAG	SURFACE OWNER	PARCEL	ACRES
A	CNX LAND, LLC	9-8-6	27.596
B	CNX LAND, LLC	9-3-17	65.86
C	LARRY S. NEELY - LIFE	9-8-7.1	76.005
D	RAYMOND DEWAINÉ DOBBS, ET AL	9-3-15	70.7424
E	RAYMOND DEWAINÉ DOBBS, ET AL	9-3-14	81.331
F	RAYMOND DEWAINÉ DOBBS, ET AL	9-9-7.1	9.00
G	JAMES R. THOMAS, ET UX	9-9-7	60.796
H	JOSEPH B. & JUDITH PATRELLO	9-9-9.1	149.924
I	JAMES D. BLAKE, ET AL	9-9-8	52.144
J	VINCENT PATRELLO	9-9-8.2	0.723
K	DIANA MAE PIATT	9-9-8.1	2.253
L	CNX LAND, LLC	7-1-4	52.00
M	KAREN S. EVANS & JUDY KAY MATTHEWS	7-1-5	116.915
N	GEO A. BURRIS	7-8-14	95.44
O	BLAINE E. STERN, JR.	7-8-13	104.92

MAP/PARCEL	ADJOINING SURFACE OWNER LIST	ACRES
3-19-82	XCL PROCESSING OPERATING LLC	14.89
7-1-7.1	NANCY L. PARSONS	0.5
9-3-13	XCL PROCESSING OPERATING LLC	28.00
9-3-13.1	XCL PROCESSING OPERATING LLC	10.00
9-3-17.1	BRIAN & LEAH KESTNER	11.8
9-8-5.2	AMY EVANS & KAREN WHETZAL	4.586
9-8-6.1	KAYLA E. BRATTON	1.423
9-9-7.2	XCL PROCESSING OPERATING LLC	3.907
9-9-7.3	JEFFREY B. THOMAS	1.297
9-9-9	VINCENT P. PATRELLO	1.076

REFERENCES

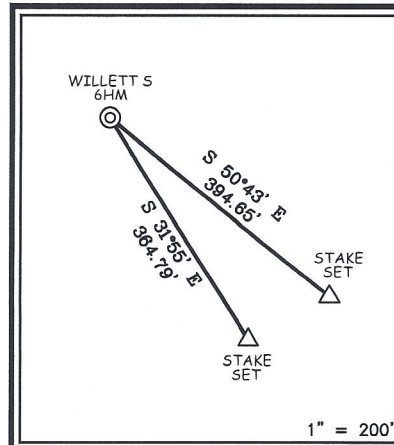

B.H.
A.D.

NOTES ON SURVEY

- NO WATER WELLS WERE FOUND WITHIN 250' OF PROPOSED GAS WELL. NO AGRICULTURAL BUILDINGS ≥ 2500 SQ. FT. OR DWELLINGS WERE FOUND WITHIN 625' OF THE CENTER OF PROPOSED WELL PAD.
- WELL SPOT CIRCLE & TOPD MARK SCALE IS 1"=200'
- PLAT UPDATED TO SHOW AS DRILLED PATH. AS DRILLED DATA PROVIDED BY EQT PRODUCTION CO.




12 Vanshook Drive | P.O. Box 180 | Glenville, WV 26031 | 304.462.4654
1412 Kanawha Boulevard, East | Charleston, WV 25301 | 304.346.1952
254 East Beckley Bypass | Beckley, WV 25801 | 304.255.3296
sllw.com

I THE UNDERSIGNED, HEREBY CERTIFY THAT THIS PLAT IS CORRECT TO THE BEST OF MY KNOWLEDGE AND BELIEF AND SHOWS ALL THE INFORMATION REQUIRED BY LAW AND THE REGULATIONS ISSUED AND PRESCRIBED BY THE DIVISION OF ENVIRONMENTAL PROTECTION.

P.S.
677

Gregory A. Smith

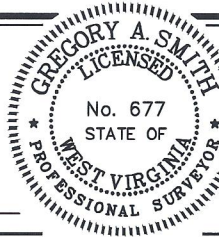

(+) DENOTES LOCATION OF WELL ON UNITED STATES TOPOGRAPHIC MAPS

DATE SEPTEMBER 8, 20 21

REVISED OCTOBER 13, 20 23

OPERATORS WELL NO. WILLETT S 6HM

API WELL NO. 47 - 051 - 02418
STATE COUNTY PERMIT

RECEIVED
Office of Oil and Gas

AUG 2 2024

MINIMUM DEGREE OF ACCURACY 1/2500 FILE NO. 8939-P6HM AD.dwg
WILLETT S 6HM-REV 2
HORIZONTAL & VERTICAL SCALE 1" = 2000'
CONTROL DETERMINED BY: DGPS (SURVEY GRADE TIE TO CORS NETWORK)

STATE OF WEST VIRGINIA
DIVISION OF ENVIRONMENTAL PROTECTION
OFFICE OF OIL AND GAS



WELL TYPE: OIL GAS LIQUID INJECTION WASTE DISPOSAL IF "GAS" PRODUCTION STORAGE DEEP SHALLOW

LOCATION: ELEVATION 1,310.03' WATERSHED TRIBUTARY OF UPPER BOWMAN RUN

DISTRICT MEADE COUNTY MARSHALL QUADRANGLE GLEN EASTON 7.5'

SURFACE OWNER CNX LAND LLC ACREAGE 27.596±

ROYALTY OWNER APPALACHIAN BASIN MINERALS, LP, ET AL ACREAGE 27.596±

PROPOSED WORK: LEASE NO. SEE WW-6A1

DRILL CONVERT DRILL DEEPER REDRILL FRACTURE OR STIMULATE PLUG OFF OLD

FORMATION PERFORATE NEW FORMATION PLUG AND ABANDON CLEAN OUT AND REPLUG OTHER

PHYSICAL CHANGE IN WELL (SPECIFY) _____ TARGET FORMATION MARCELLUS

ESTIMATED DEPTH TVD: 6,987' / TMD: 20,385'

WELL OPERATOR EQT PRODUCTION COMPANY DESIGNATED AGENT JOSEPH C. MALLOW

ADDRESS 400 WOODCLIFF DRIVE ADDRESS 427 MIDSTATE DRIVE

CANONSBURG, PA 15317 CLARKSBURG, WV 26301

COUNTY NAME
PERMIT

11/08/2024