

WW-7  
8-30-06



West Virginia Department of Environmental Protection  
Office of Oil and Gas

WELL LOCATION FORM: GPS

API: 47-051-30150 WELL NO.: M-1785

FARM NAME: HENRY WENDT

RESPONSIBLE PARTY NAME: WEST VIRGINIA LAND RESOURCES INC.

COUNTY: MARSHALL DISTRICT: LIBERTY

QUADRANGLE: CAMERON WV, PA

SURFACE OWNER: DALE MARSHALL & DANIEL R. WOOD

ROYALTY OWNER: \_\_\_\_\_

UTM GPS NORTHING: 4,404,886 m (1319')

UTM GPS EASTING: 540,954 m GPS ELEVATION: 402 m

The Responsible Party named above has chosen to submit GPS coordinates in lieu of preparing a new well location plat for a plugging permit or assigned API number on the above well. The Office of Oil and Gas will not accept GPS coordinates that do not meet the following requirements:


1. Datum: NAD 1983, Zone: 17 North, Coordinate Units: meters, Altitude: height above mean sea level (MSL) – meters.
2. Accuracy to Datum – 3.05 meters
3. Data Collection Method:

Survey grade GPS  : Post Processed Differential \_\_\_\_\_  
Real-Time Differential

Mapping Grade GPS \_\_\_\_\_ : Post Processed Differential \_\_\_\_\_  
Real-Time Differential \_\_\_\_\_

4. Letter size copy of the topography map showing the well location.

I the undersigned, hereby certify this data is correct to the best of my knowledge and belief and shows all the information required by law and the regulations issued and prescribed by the Office of Oil and Gas.

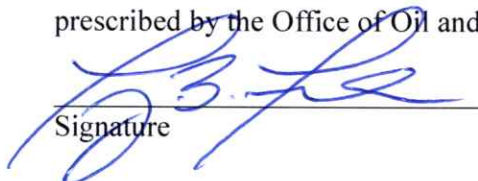  
Signature


Professional Surveyor  
Title

OCTOBER 1, 2022  
Date

RECEIVED  
Office of Oil and Gas  
OCT 13 2022  
WV Department of  
Environmental Protection



4705102476P

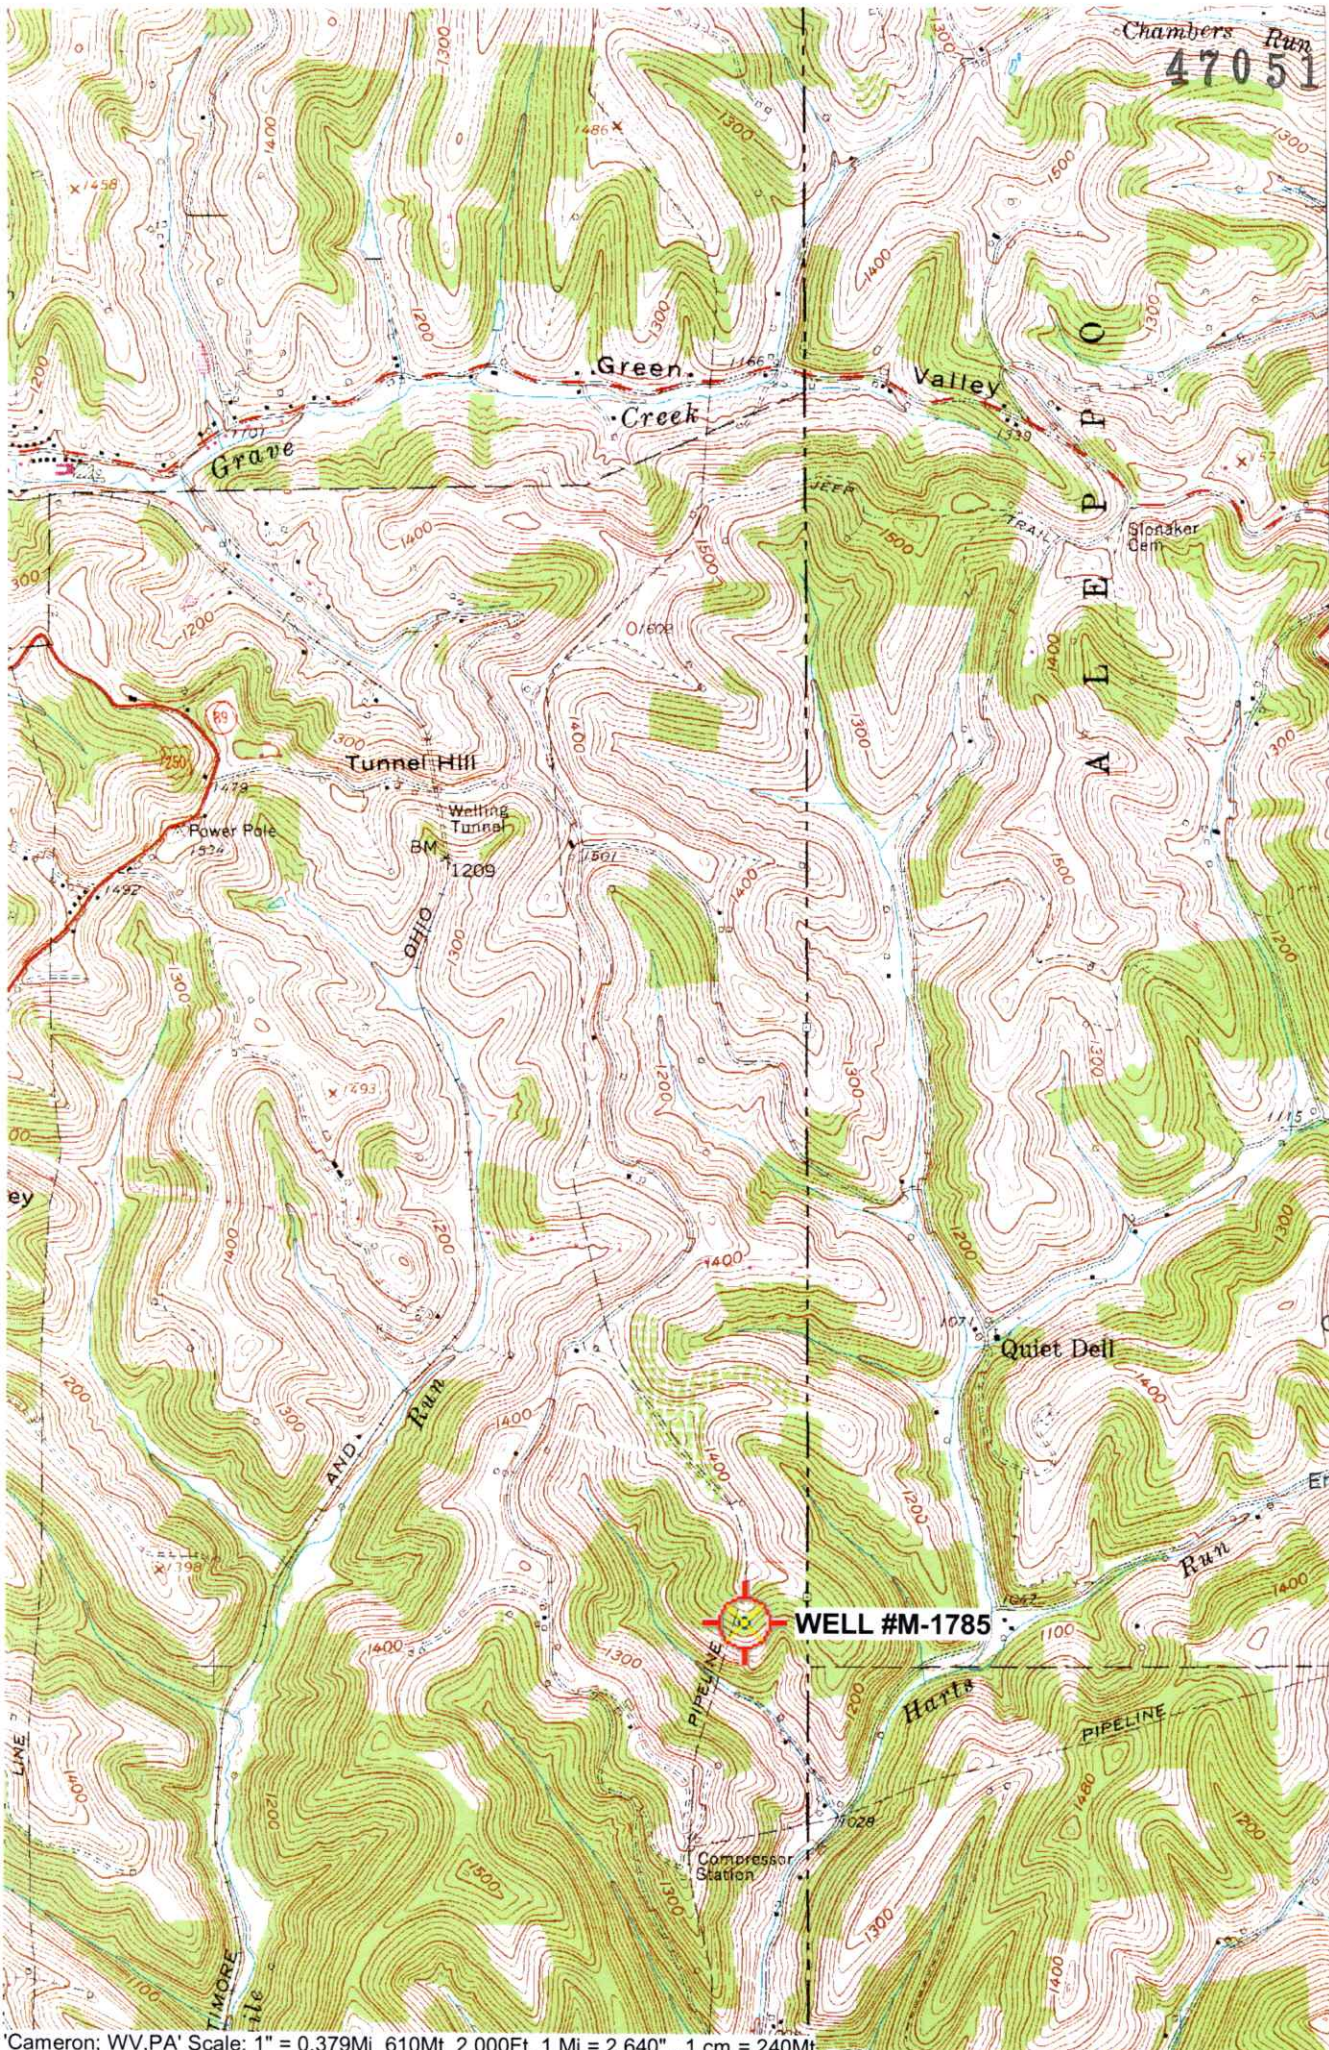

50'  
4409  
4408  
4406  
4405  
4404

(NEW FREEPORT)  
4963 IV SW

RECEIVED  
Office of Oil and Gas  
OCT 13 2022  
WV Department of  
Environmental Protection

12/16/2022