



---

west virginia department of environmental protection

---

Office of Oil and Gas  
601 57<sup>th</sup> Street, S.E.  
Charleston, WV 25304  
(304) 926-0450  
fax: (304) 926-0452

Harold D. Ward, Cabinet Secretary  
[www.dep.wv.gov](http://www.dep.wv.gov)

Monday, November 18, 2024  
PERMIT MODIFICATION APPROVAL  
Horizontal 6A / New Drill

SWN PRODUCTION COMPANY, LLC  
POST OFFICE BOX 12359

SPRING, TX 773914954


Re: Permit Modification Approval for Serafin Ortiz MSH 205H  
47-051-02510-00-00

**Adding an AST to the pad**

SWN PRODUCTION COMPANY, LLC

The Office of Oil and Gas has reviewed the attached permit modification for the above referenced permit. The attached modification has been approved and well work may begin. Please be reminded that the oil and gas inspector is to be notified twenty-four (24) hours before permitted well work is commenced.

If there are any questions, please feel free to contact me at (304) 926- 0450.

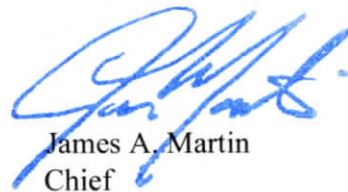A blue ink signature of James A. Martin, Chief, is written in a cursive style. Below the signature, the name "James A. Martin" and the title "Chief" are printed in a black, sans-serif font.

James A. Martin  
Chief



Operator's Well Number: Serafin Ortiz MSH 205H  
Farm Name: Frank J & Lori A Longwell  
U.S. WELL NUMBER: 47-051-02510-00-00  
Horizontal 6A New Drill  
Date Modification Issued: 11/18/2024

Promoting a healthy environment.

11/22/2024

**APPROVED**  
**WVDEP OOG**  
*[Signature]* 11/18/2024

LEGEND	
	EXISTING CONTOURS
	EXISTING PROPERTY LINE
	EXISTING PAD BERM
	EXISTING GRAVEL EDGE OF ROAD/PAD
	EXISTING BUILDINGS
	EXISTING FENCE
	EXISTING POOL
	EXISTING DITCH
	EXISTING TREE LINE
	EXISTING GATE POST
	EXISTING POWER POLE

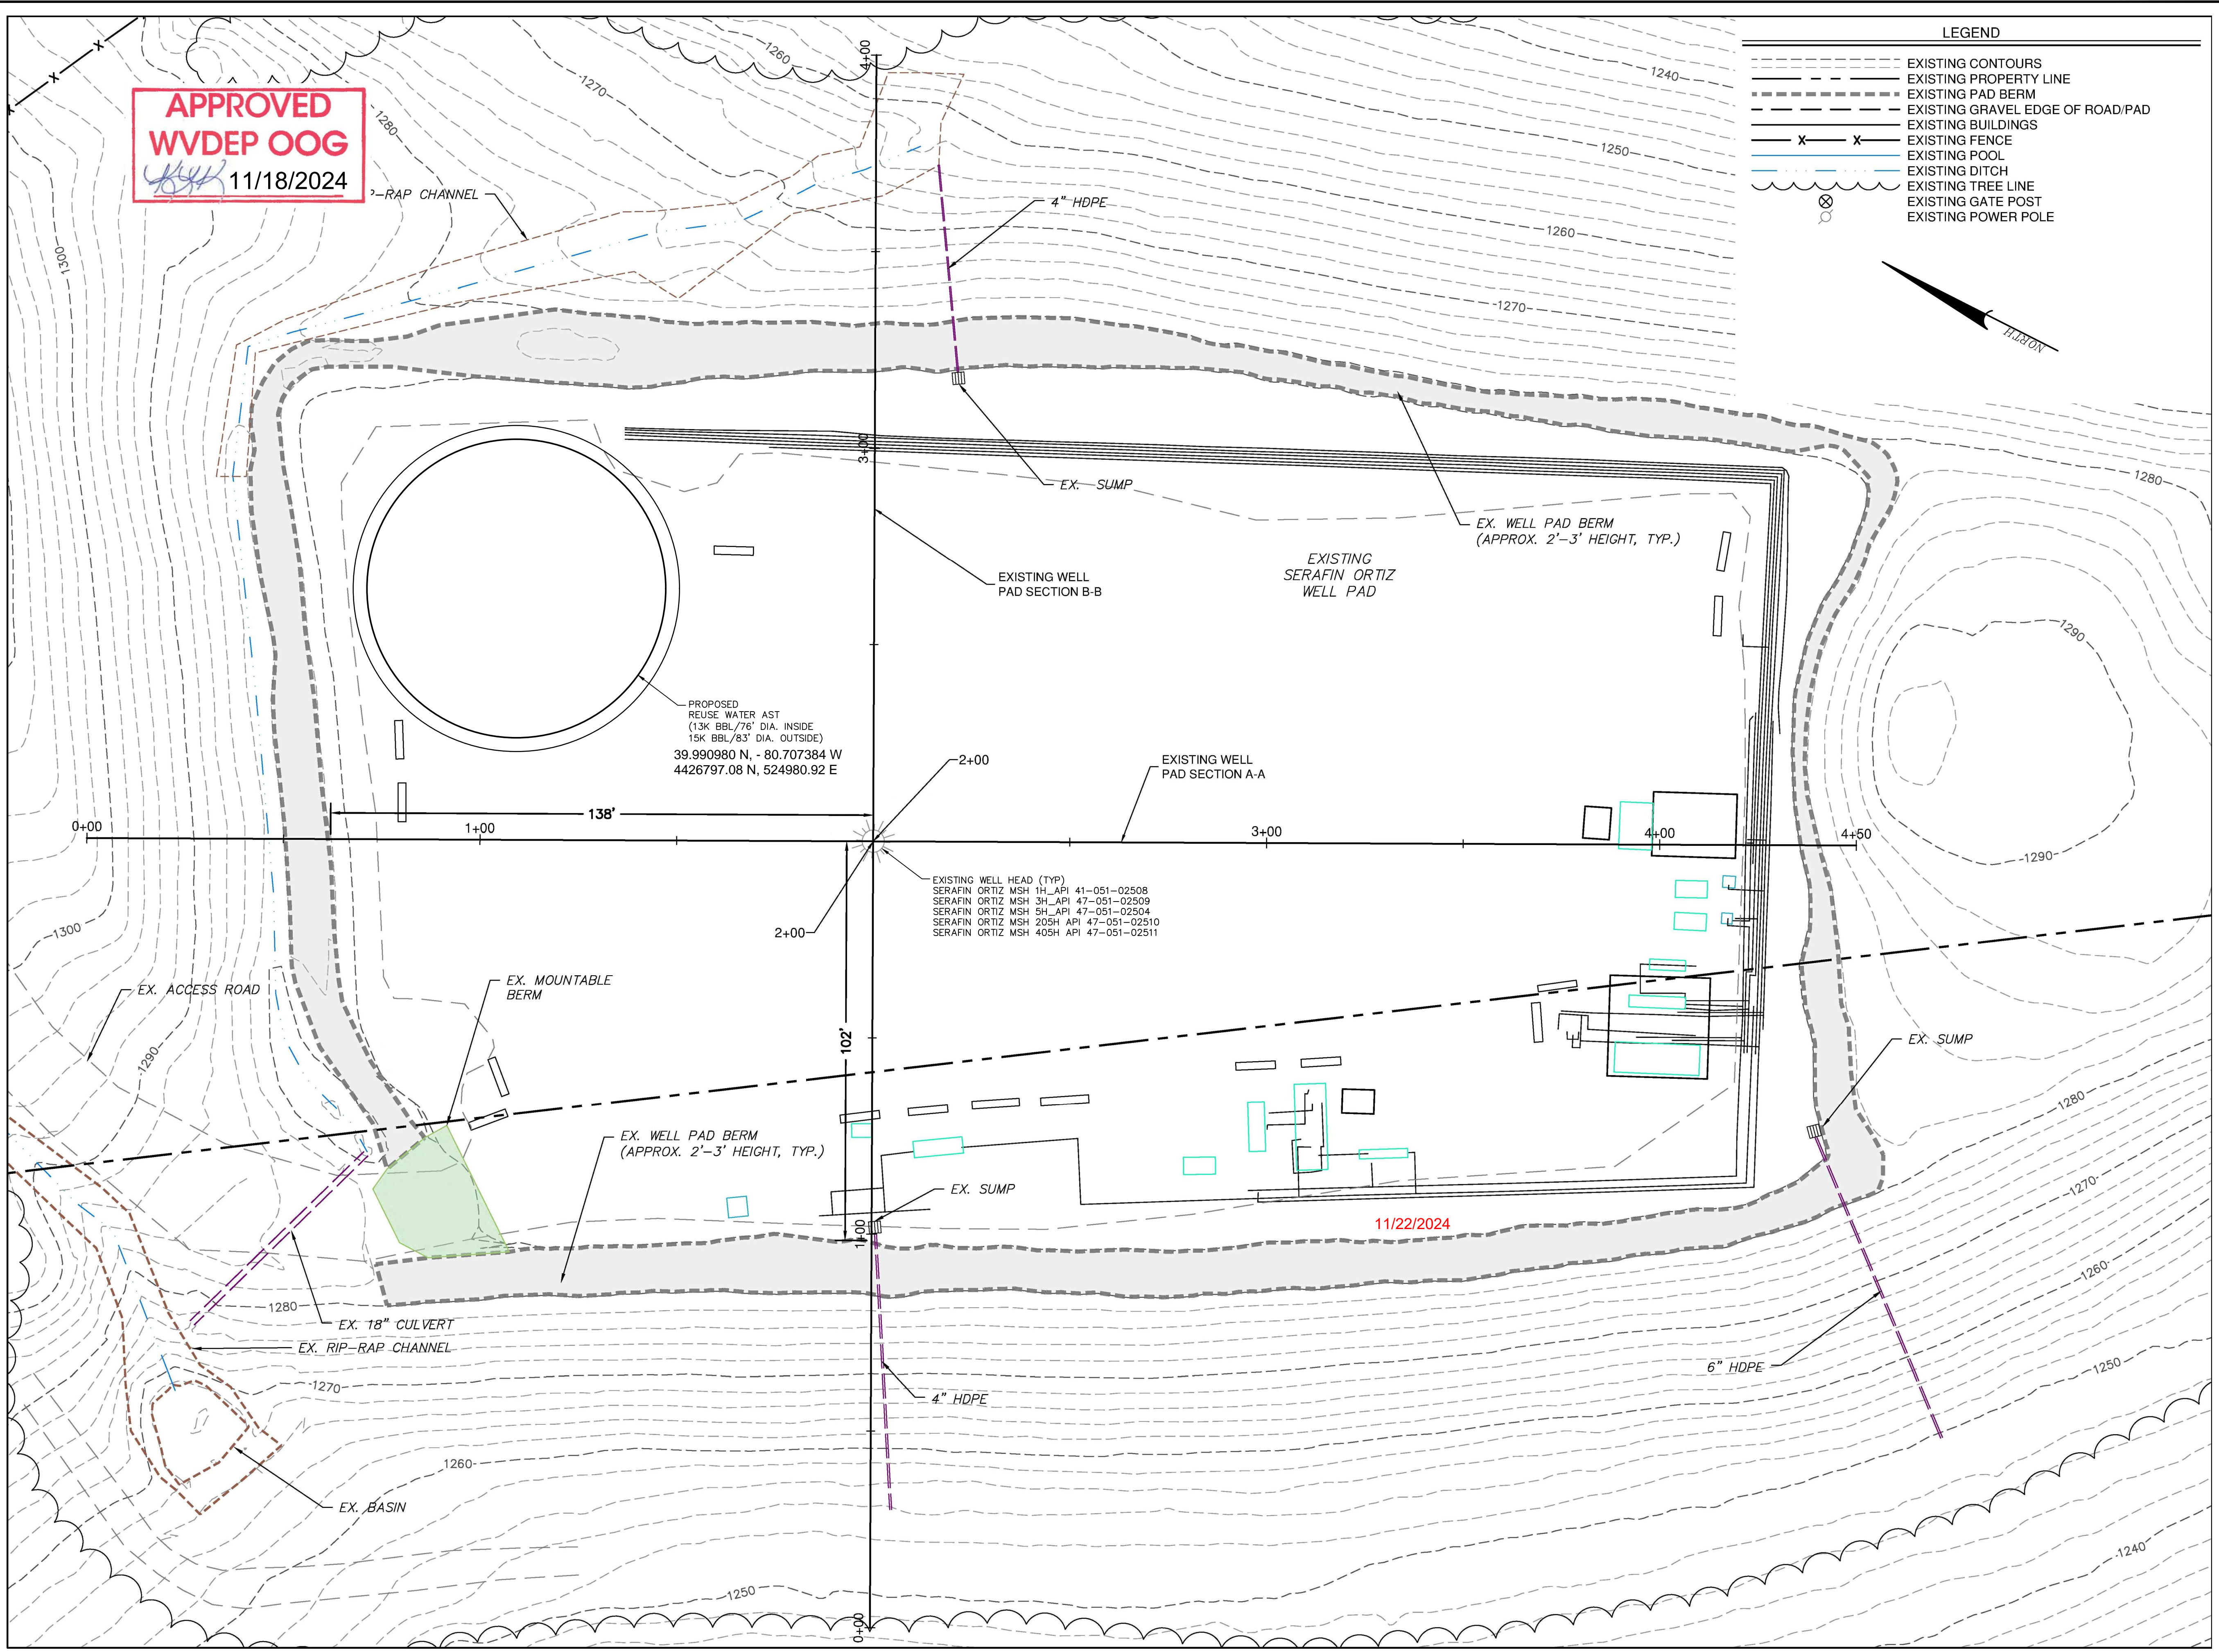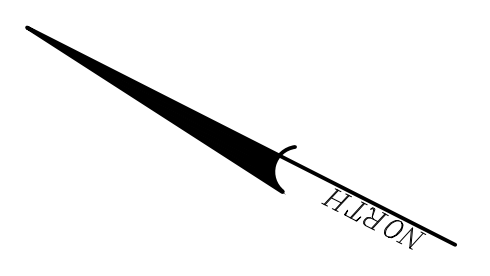

NO.	DATE	REVISION

FOR RETIEW ASSOCIATES BY:	ARRES:
MANAGER: CASEY BARTIKUS	DESIGN BY: CHKO BY:
PDZ	PDZ
DRAWN BY: PDZ	CHKO BY: PDZ
SURV. CHIEF: PDZ	FIELDBOOK NO.:
	DMA COLLECTOR:

CLIENT

Southwestern Energy A  
 SOUTHWEST APPALACHIA DIVISION  
 10000 Highway 100, Raleigh, NC 27607

SCALE: 1"=20'

0 10' 20' 40' 60'

**RETIEW**

RETIEW Associates, Inc.  
 One Robinson Plaza, Suite 200, Pittsburgh, PA 15205  
 Phone (800) 738-8395  
 Email: retiew@retiew.com  
 Website: www.retiew.com

Engineers • Planners • Surveyors • Landscape Architects  
 Environmental Consultants

EXHIBIT  
 REUSE WATER AST  
 FOR  
**SERAFIN ORTIZ  
 PRODUCTION PAD**

UNION DISTRICT MARSHALL COUNTY, WV

DATE: 10/25/2024

SHEET NO. 1 OF 1

DWG. NO. 0875602698

NOT FOR CONSTRUCTION/NOT FOR BIDDING