

4705102513B

Oil&Gas

Wells, Horizontal Only

WellStatus

- Active Well
- Permit Issued
- Permit Application
- Plugged

Wells, Active Status Only


WellUse

- △ Brine Disposal
- ✖ Fluid Injection
- Gas Production
- House Gas
- Observation
- Oil Production
- Production
- ▲ Solution Mining
- ◆ Storage
- Vent
- <all other values>

Wells, Other than Active Status

WellUse

- △ Brine Disposal
- ✖ Fluid Injection
- Gas Production
- House Gas
- Observation
- Oil Production
- Production
- Solution Mining

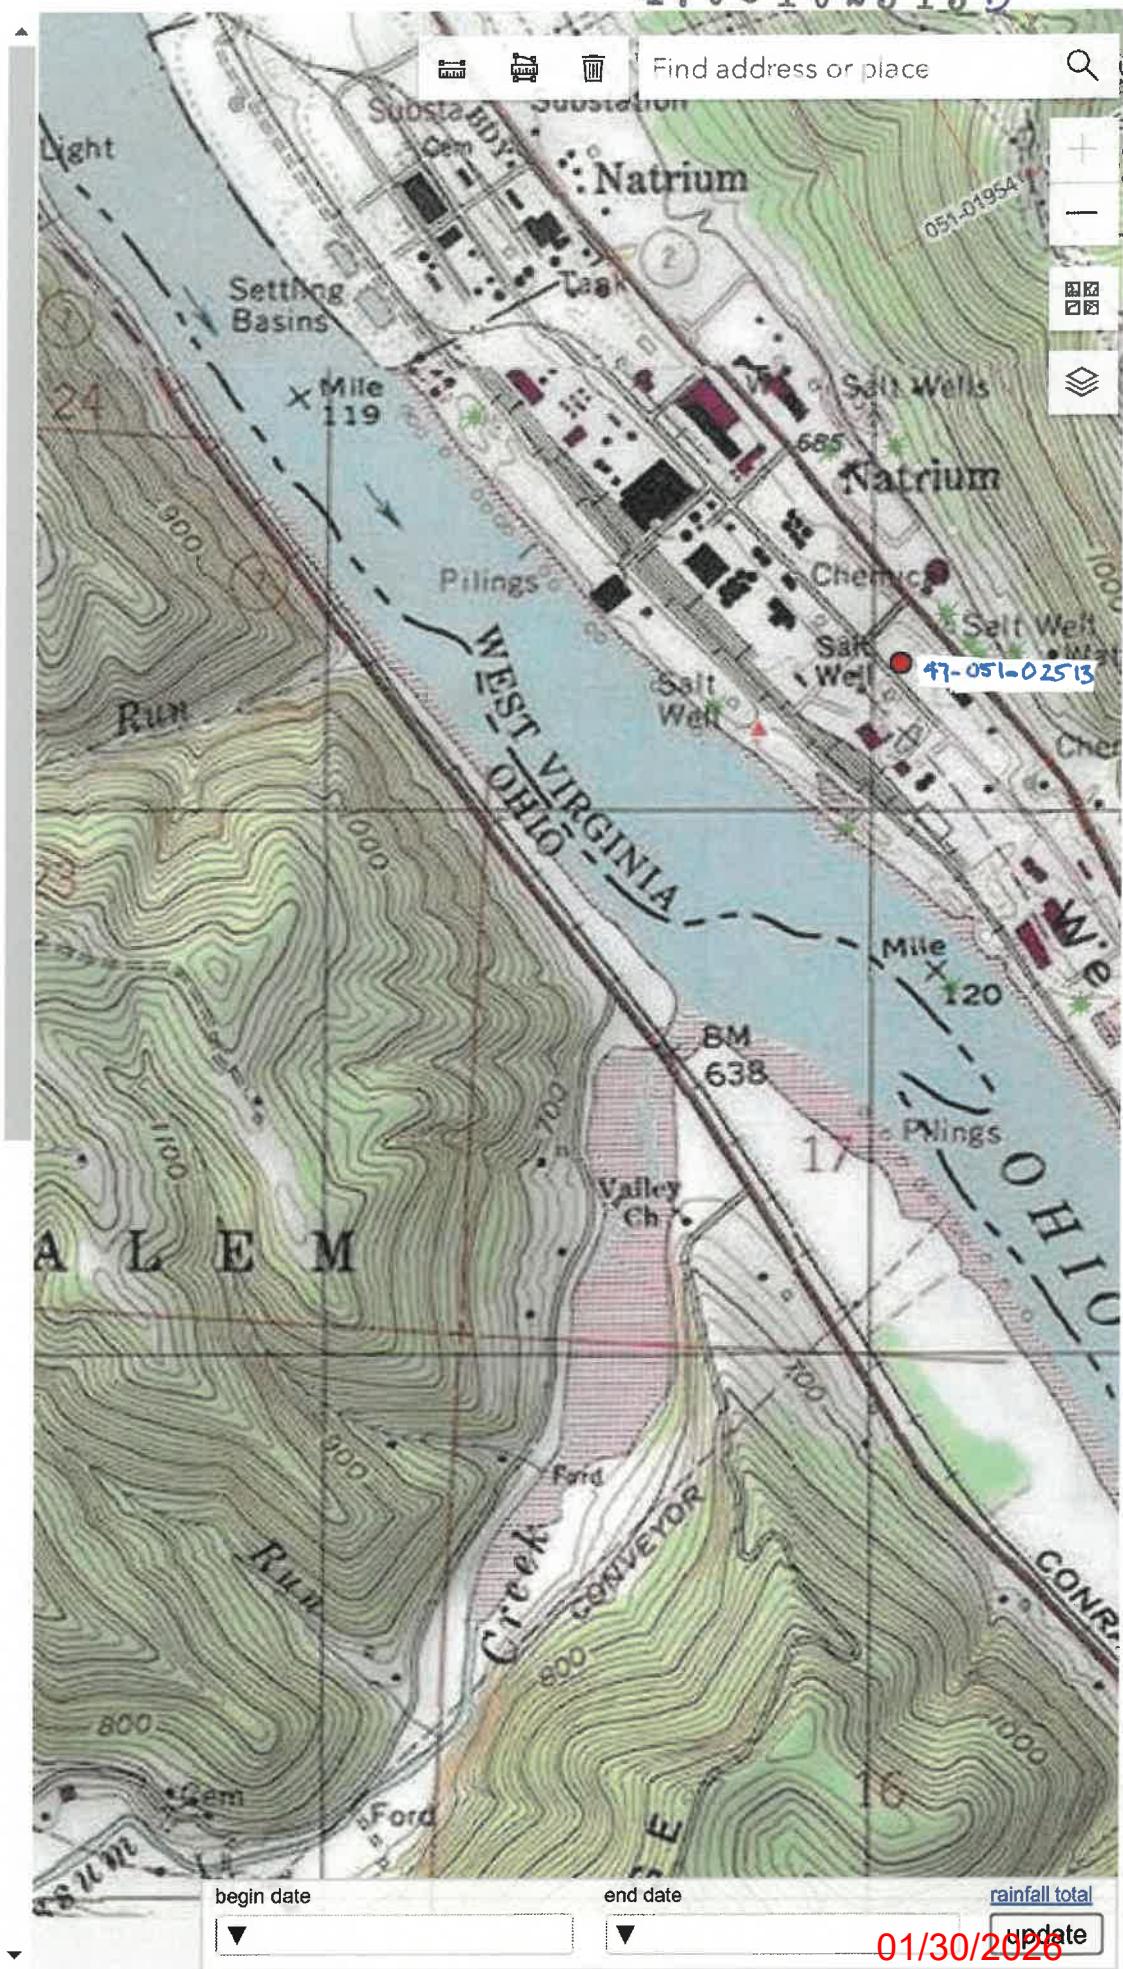

EAGLE NATRIUM, LLC

406.636 AC. ±

WELL NO. BW 101


WELL NO. BW 101
STATE PLANE COORDINATES
NORTH ZONE (NAD '83)

N. 456,362.59
E. 1,589,698.29


LAT=(N) 39.745148
LONG=(W) 80.847566

UTM (NAD '83)(METERS)
N. 4,399,483
E. 513,060

NAD' 83 GRID NORTH

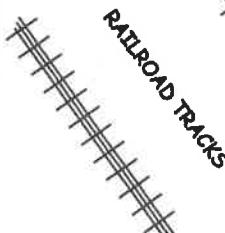

WESTLAKE NATRIUM, LLC
403.636 ACRES±
TM 21-25

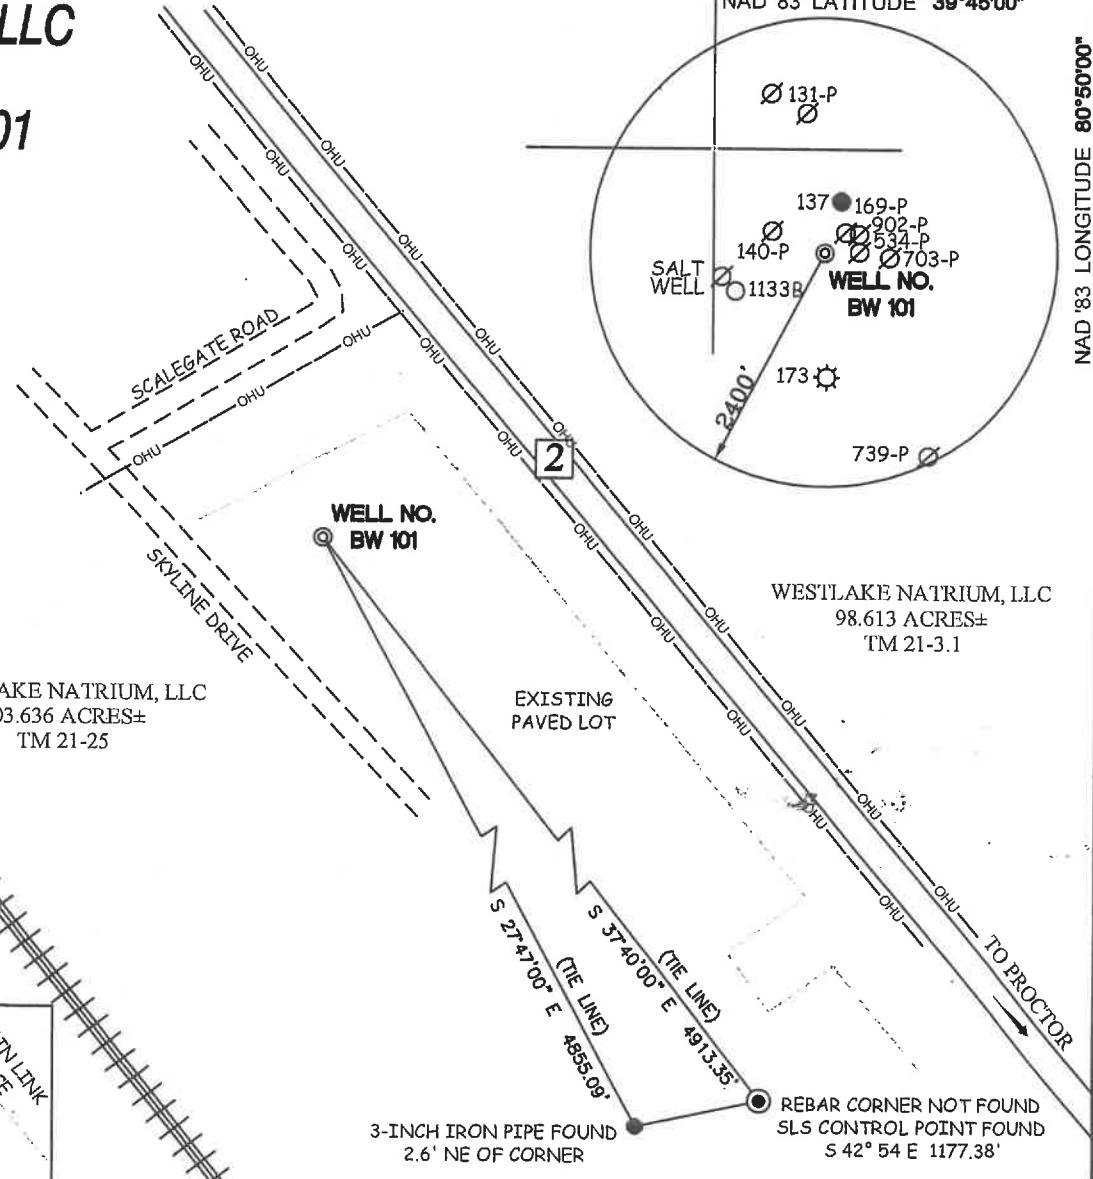

REFERENCES



12 Vanhorn Drive | P.O. Box 150 | Glenville, WV 26351 | 304.462.5634
1412 Kanawha Boulevard, East | Charleston, WV 25301 | 304.346.3952
254 East Beckley Bypass | Beckley, WV 25801 | 304.235.5295
slwv.com

I THE UNDERSIGNED, HEREBY CERTIFY THAT
THIS PLAT IS CORRECT TO THE BEST OF MY
KNOWLEDGE AND BELIEF AND SHOWS ALL
THE INFORMATION REQUIRED BY LAW AND
THE REGULATIONS ISSUED AND PRESCRIBED
BY THE DIVISION OF ENVIRONMENTAL PROTECTION.

P.S.
2294

Matthew J. Hilton Jr.

MINIMUM DEGREE
OF ACCURACY

1 / 2500

FILE NO. 8450-WESTLAKE-BW101-MRH-20230915.DWG

SCALE 1" = 200'


HORIZONTAL & VERTICAL
CONTROL DETERMINED BY DGPS (SURVEY GRADE TIE TO CORS NETWORK)

NAD '83 LATITUDE 39°45'00"

NAD 83 LONGITUDE 80°50'00"

4705102513B

NAD 83 LONGITUDE 80°50'00"

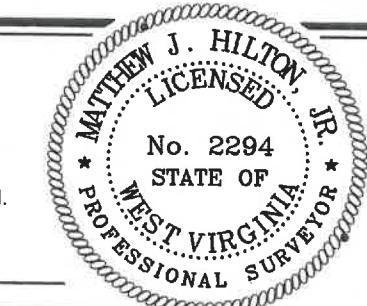

(+) DENOTES LOCATION OF WELL ON UNITED
STATES TOPOGRAPHIC MAPS.

DATE MARCH 26, 20 24

REVISED , 20

OPERATORS WELL NO. BW 101

API WELL NO. 47 - 051 - 02513B
STATE COUNTY PERMIT

STATE OF WEST VIRGINIA
DIVISION OF ENVIRONMENTAL PROTECTION
OFFICE OF OIL AND GAS



01/30/2026

EAGLE NATRIUM, LLC
406.636 AC.±
WELL NO. BW 101


NOT
TO
SCALE

WELL NO. BW 101
 STATE PLANE COORDINATES
 NORTH ZONE (NAD '83)
 N. 456,362.59
 E. 1,589,598.29
 LAT=(N) 39.745148
 LONG=(W) 80.847565
 UTM (NAD '83)(METERS)
 N. 4,399,443
 E. 513,060

NAD 83 GRID NORTH



REFERENCES

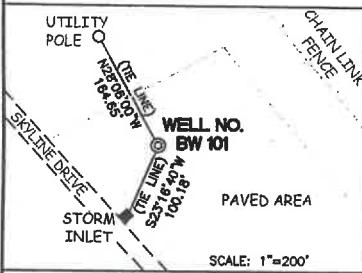

I THE UNDERSIGNED, HEREBY CERTIFY THAT
 THIS PLAT IS CORRECT TO THE BEST OF MY
 KNOWLEDGE AND BELIEF AND SHOWS ALL
 THE INFORMATION REQUIRED BY LAW AND
 THE REGULATIONS ISSUED AND PRESCRIBED
 BY THE DIVISION OF ENVIRONMENTAL PROTECTION.


P.S.
 2294

Matthew J. Hilton Jr.

RECEIVED
 Office of Oil & Gas

APR 15 2024

WV Department of
 Environmental Protection

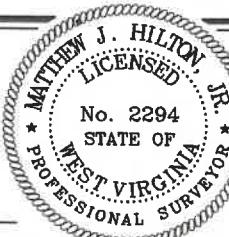

1. TIES TO WELLS, CORNERS AND REFERENCES ARE BASED ON GRID NORTH FOR THE WV STATE PLANE COORDINATE SYSTEM NORTH ZONE NAD '83.
2. TRACT BOUNDARY SHOWN HEREON TAKEN FROM DEED BOOK 799 PAGE 387 AND A PREVIOUS SURVEY BY SLS IN 2004 - 2005.
3. SURFACE OWNER AND ADJOINER INFORMATION TAKEN FROM THE ASSESSOR AND COUNTY CLERK RECORDS OF MARSHALL COUNTY IN SEPTEMBER 2023.
4. WELL STATE PLANE, LAT./LONG. AND UTM (NAD '83) COORDINATES ESTABLISHED BY DGPS(SURVEY GRADE).
5. EAGLE NATRIUM, LLC HAS CHANGED TO WESTLAKE NATRIUM, LLC.

(+) DENOTES LOCATION OF WELL ON UNITED STATES TOPOGRAPHIC MAPS.

DATE MARCH 26 20 24

REVISED 20

OPERATORS WELL NO. BW 101

API WELL NO. 47 - 051 - 02513B

STATE MARCH 26 20 24

STATE COUNTY PERMIT

STATE OF WEST VIRGINIA
 DIVISION OF ENVIRONMENTAL PROTECTION
 OFFICE OF OIL AND GAS



MINIMUM DEGREE
 OF ACCURACY 1 / 2500 FILE NO. 9450-WESTLAKE-BW101-MRH-20230915.DWG
 HORIZONTAL & VERTICAL
 CONTROL DETERMINED BY DGPS (SURVEY GRADE TIE TO CORS NETWORK)

WELL BRINE & LIQUID WASTE IF
 TYPE: OIL GAS INJECTION DISPOSAL "GAS" PRODUCTION STORAGE DEEP SHALLOW

LOCATION: GROUND ELEVATION 648' WATERSHED OHIO RIVER

DISTRICT FRANKLIN COUNTY MARSHALL QUADRANGLE NEW MARTINSVILLE 7.5'

SURFACE OWNER EAGLE NATRIUM, LLC ACREAGE 456.62± (TOTAL) 403.636± (NET)

ROYALTY OWNER EAGLE NATRIUM, LLC ACREAGE

LEASE NO.

PROPOSED WORK: DRILL CONVERT DRILL DEEPER REDRILL FRACTURE OR STIMULATE PLUG OFF OLD

FORMATION PERFORATE NEW FORMATION PLUG AND ABANDON CLEAN OUT AND REPLUG OTHER

PHYSICAL CHANGE IN WELL (SPECIFY) TARGET FORMATION SALINA
 ESTIMATED DEPTH 6700' - 6800'

WELL OPERATOR	EAGLE NATRIUM, LLC	DESIGNATED AGENT	D. SCOTT MILLS
ADDRESS	15696 ENERGY ROAD	ADDRESS	15696 ENERGY ROAD
	PROCTOR, WV 26055		PROCTOR, WV 26055

01/30/2026

COUNTY NAME

PERMIT

4705102513B
 NAD '83 LATITUDE 39°45'00"
 1768' 1768'
 80°50'00" 80°50'00"
 NAD 83 LONGITUDE