


4705102528

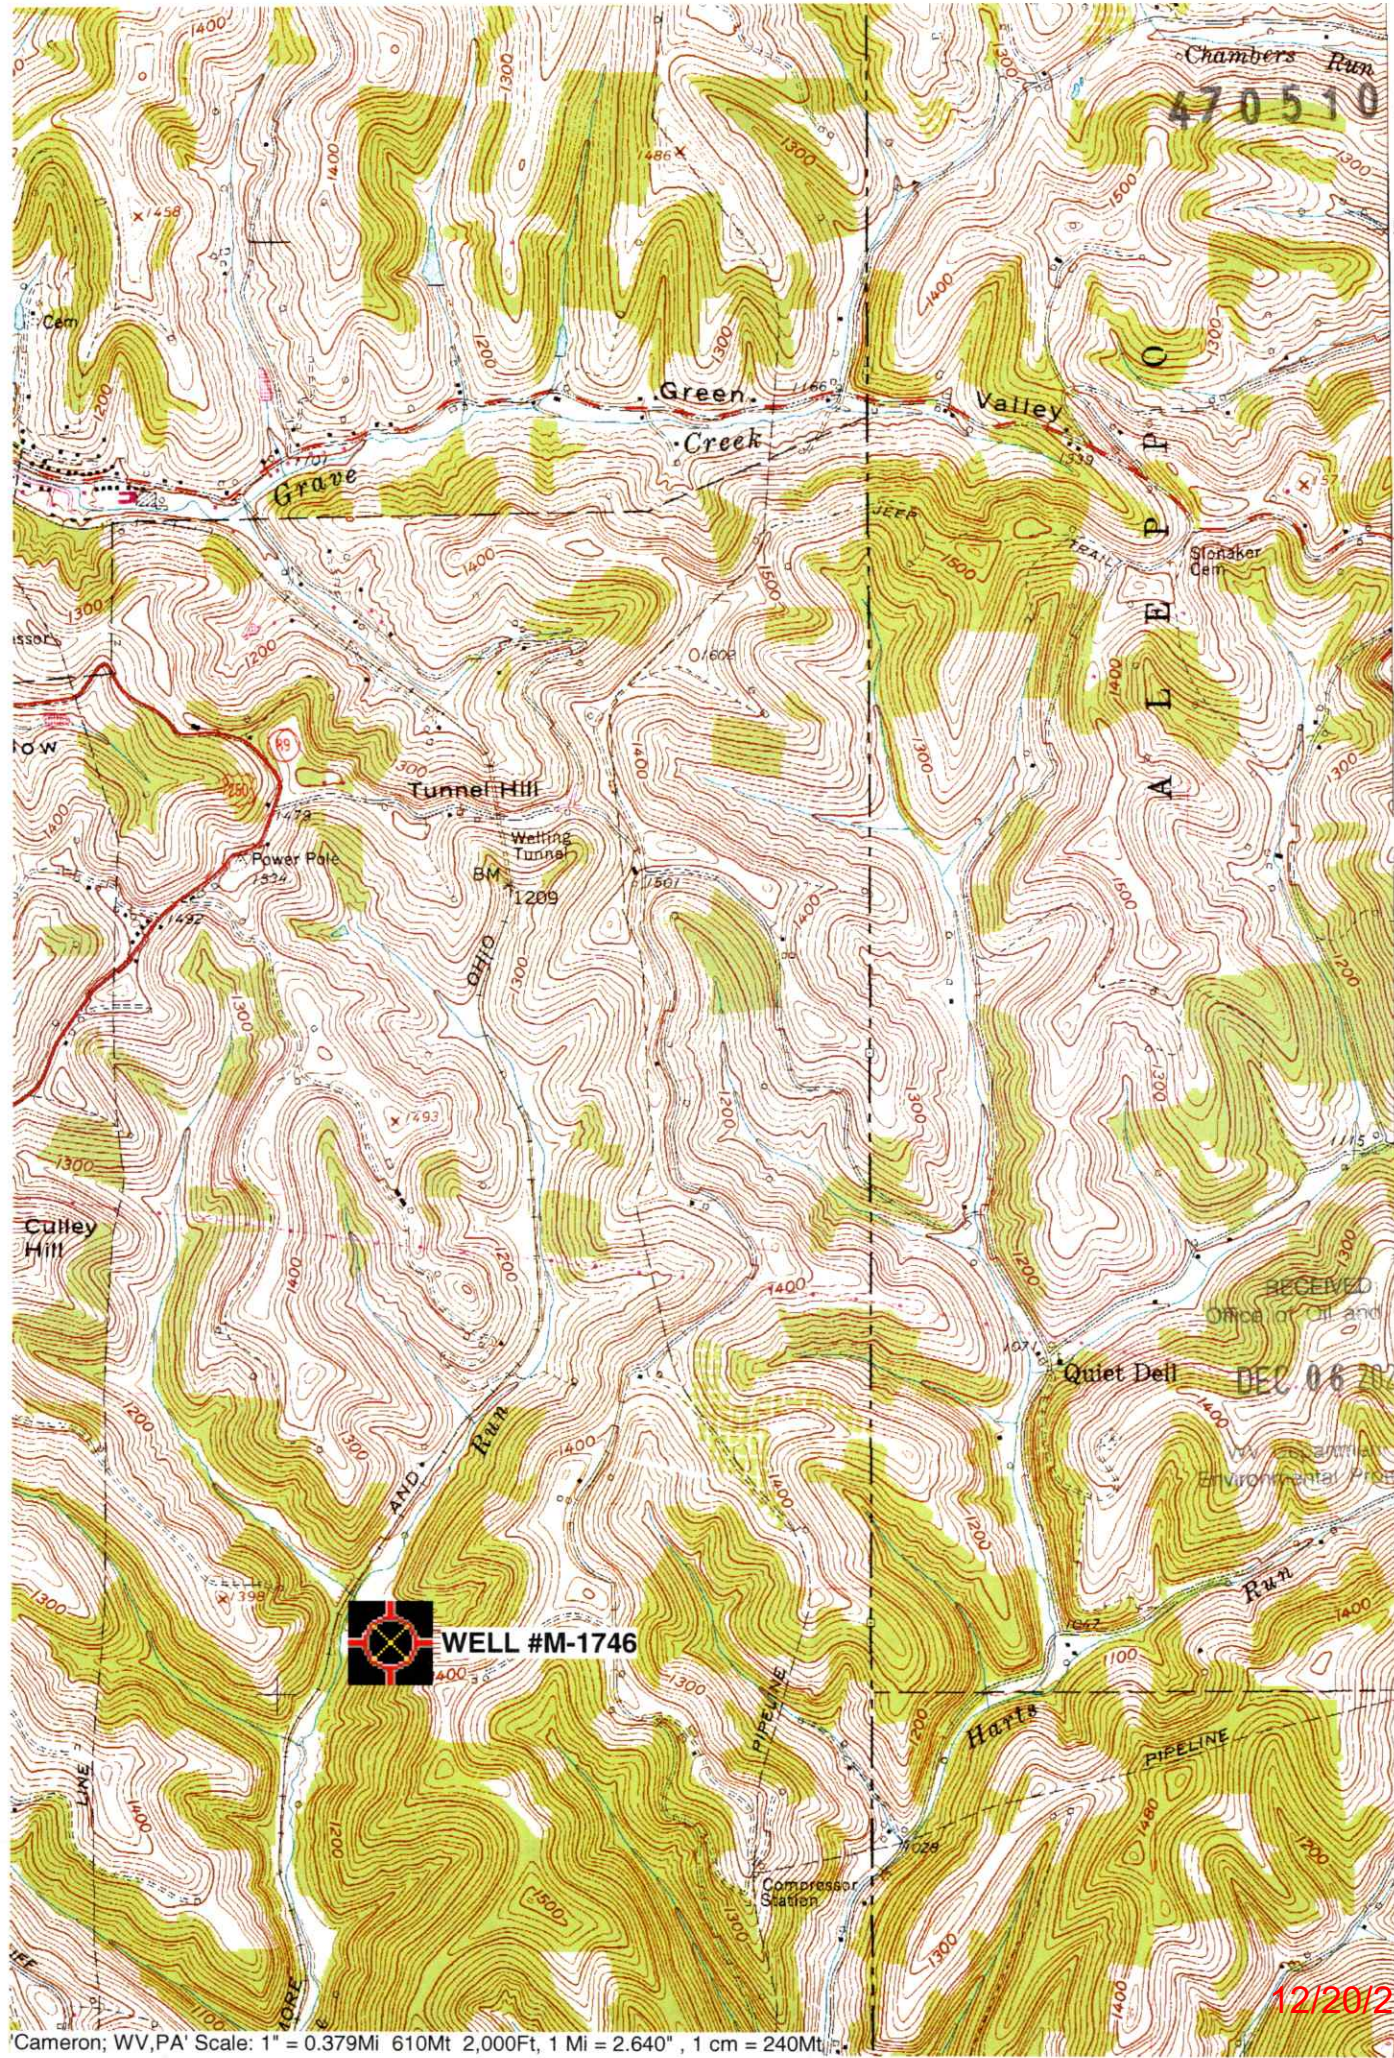

50'
4409
4408
4406
4405
4404

(NEW FREEPORT)
4963 IV SW

RECEIVED
Office of Oil and Gas
DEC 06 2024
WV Department of
Environmental Protection

 **WELL #M-1746**

12/20/2024

WW-7
8-30-06



West Virginia Department of Environmental Protection
Office of Oil and Gas

WELL LOCATION FORM: GPS

API: 47-051-30122 WELL NO.: M-1746

FARM NAME: WARD HUPP

RESPONSIBLE PARTY NAME: WEST VIRGINIA LAND RESOURCES INC.

COUNTY: MARSHALL DISTRICT: LIBERTY

QUADRANGLE: CAMERON WV, PA

SURFACE OWNER: JASON C. ROSS

ROYALTY OWNER: _____

UTM GPS NORTHING: 4,404,688 m

UTM GPS EASTING: 539,608 m GPS ELEVATION: 372 m

The Responsible Party named above has chosen to submit GPS coordinates in lieu of preparing a new well location plat for a plugging permit or assigned API number on the above well. The Office of Oil and Gas will not accept GPS coordinates that do not meet the following requirements:

1. Datum: NAD 1983, Zone: 17 North, Coordinate Units: meters, Altitude: height above mean sea level (MSL) – meters.
2. Accuracy to Datum – 3.05 meters
3. Data Collection Method:

Survey grade GPS : Post Processed Differential _____


Real-Time Differential

Mapping Grade GPS _____ : Post Processed Differential _____

Real-Time Differential _____

4. **Letter size copy of the topography map showing the well location.**

I the undersigned, hereby certify this data is correct to the best of my knowledge and belief and shows all the information required by law and the regulations issued and prescribed by the Office of Oil and Gas.

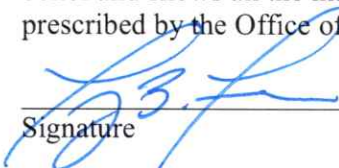
Signature

PS2002
Title

OCTOBER 21, 2024
Date

RECEIVED
Office of Oil and Gas

DEC 06 2024

WV Department of
Environmental Protection