


Union dist

Plugging Affidavit

Oct 27, 1931.

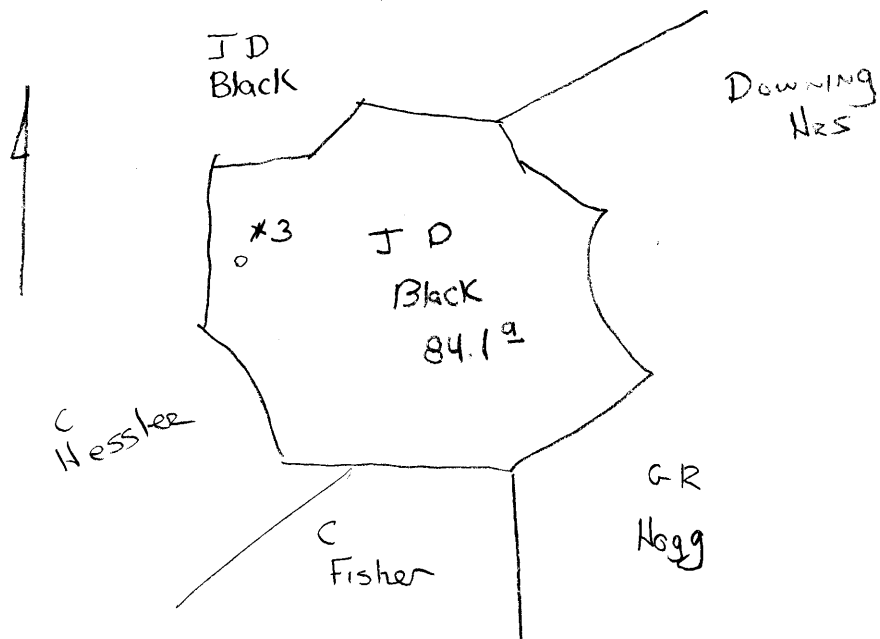

Marsh 14A

Union District, Marshall County, W. Va.

Natural Gas Co. of W. Va.

On 105 acres, surface owned by J. D. Black, Sherrard, W. Va.

Elevation, 1127'.

14' conductor; 10" casing, 249'; 8", 949'; 6-5/8", 1545'; 2", 1545'.

Abandonment reported to Dept. of Mines, Sept. 22, 1931.

	Top.	Bottom.
Haplotown (Sewickley) Coal	580	584
Pittsburgh Coal (SLM)	667	673
Sand	949	954
Sand	967	1002
Sand	1305	1330
1st Salt Sand	1357	1422
2nd Salt Sand (gas at 1536')	1527	1536
Total depth		1549

Union District, Marshall County, W. Va.
 Natural Gas Co. of W. Va., 800 Union Tr. Bldg., Pittsburgh, Pa.
 On 105 acres, surface owned by J. D. Black, Cherrard, W. Va., and
 mineral rights by Natural Gas Co. of W. Va., Pittsburgh, Pa.

Drilled prior to June 1, 1929.

Elevation, 1127'.

1 1/2" conductor; 10" casing, 249'; 8", 949'; 6-5/8", 1545'; 2" tubing, 1545'.

Coal was encountered at 580-584, and 667-673'.

Abandonment reported to Dept. of Mines Sept. 22, 1931.

	Top.	Bottom.
Mapletown Coal	580	- 584
Pittsburgh Coal (B&C)	667	- 673
Sand	949	- 954
Sand	987	- 1002
Sand	1305	- 1330
1st Salt Sand	1357	- 1422
2nd Salt Sand (gas at 1536')	1527	- 1536
Total depth		1549

MARS-14-A