


Cameron dist

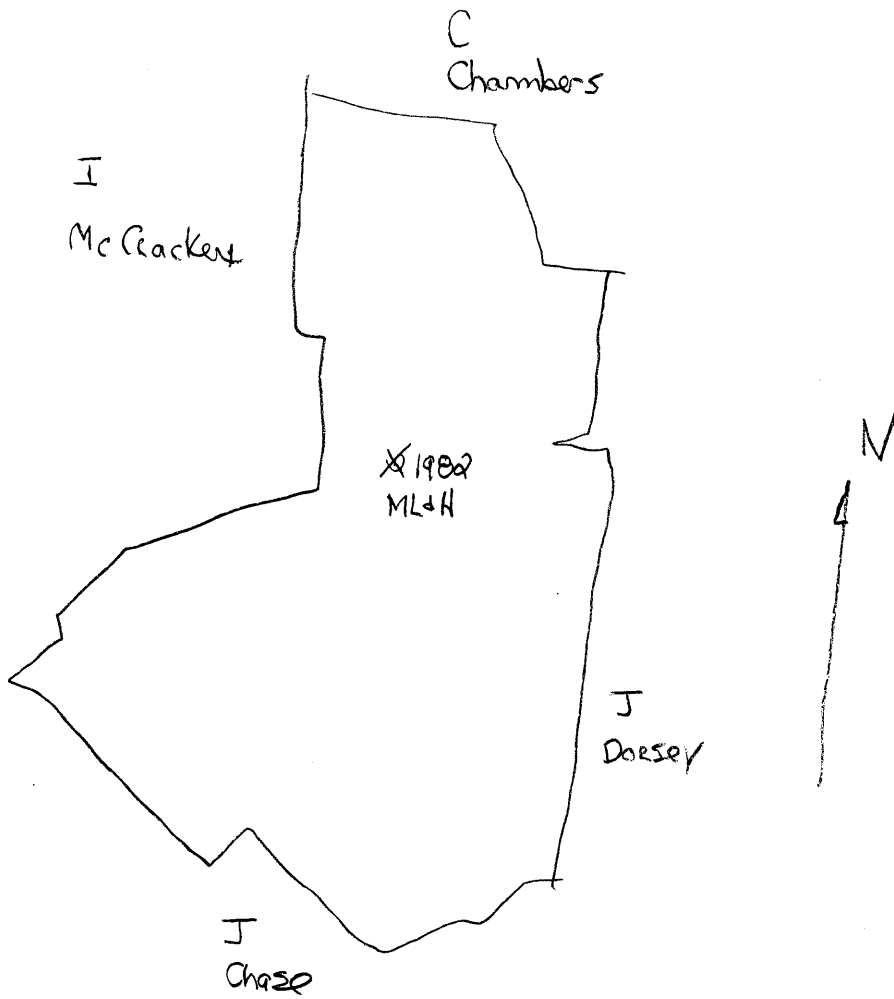

30061

Cameron District, Marshall County, W. Va.

By The Manufacturers Light & Heat Co., 500 Union Trust Bldg.,
Pittsburgh, Pa.

On 135 acres, surface owned by Alice Chambers, Cameron, W. Va.,
and mineral rights by ML&H Co., Pgh., Pa.

Drilled prior to June 1, 1929.

Elevation, 1156' L.

15' conductor; 10" casing, 254'; 8", 1058'; 6-5/8", 1850'.

Coal was encountered at 405-410, 650-655, and 750-757'.

Abandonment reported to Dept. of Mines August 17, 1936.

Well was shot in Gordon Stray Sand.

Gas well.

	Top.	Bottom.	Thickness.
Waynesburg Coal	405	- 410	5
Mapletown (Sewickley) Coal	650	- 655	5
Pittsburgh Coal	750	- 757	7
Murphy Sand	880	- 900	20
Big Dunkard Sand	1290	- 1280	30
Gas Sand	1415	- 1455	40
Salt Sand	1540	- 1595	55
Little Line	1835	- 1845	10
Big Line	1850	- 1900	50
Big Injun Sand	1900	- 2150	250
30-Foot shells	2400	- 2520	120
Fifty-foot Sand (gas at 2695')	2693	- 2715	22
Gordon Stray and Gordon Sands (gas at 2763')	2755	- 2795	40
Sand	2922	- 2926	4
Total depth		2932	